

CENTRAL MAPPING AUTHORITY

Department of Lands

Trigonometrical Survey of N.S.W.

RECONNAISSANCE and MAINTENANCE REPORT

This Trig. Station has been:-

Note: Cross out word or words which do not apply

1. Completely cleared to permit 360° vision to surrounding Trig.

2. Cleared by lanes bearing..... from Trig. Mast

3. Trig. Mast & Vanes have been painted white & black respectively.

4. The Trig. was unpiled/not-unpiled, dimensions now being:
 Description of mark: Drill hole in Rock should be explicit, e.g. Steel plug, Brass plug, Bolt, G.I. Pipe

Height of mark..... m above rock/concrete..... m above G.L.

Height of Top Vanes to Top Mark..... m. Diameter of Vanes (vertical)..... m.

Height of Cairn..... m. Diameter of Cairn..... m.

Length of Mast..... m. (approximate if not unpiled)

5. A..... set in conc/rock has been placed..... m. bearing.....°M from Trig. Mast

6. A..... set in conc/soil has been placed..... m. bearing.....°M from Trig. Mast

7. A..... set in conc/soil has been placed..... m. bearing.....°M from Trig. Mast

8. A..... set in conc/rock has been placed..... m. bearing.....°M from Trig. Mast

9. Connection..... to..... m. bearing.....°M

10. Connection..... to..... m. bearing.....°M

11. Connection..... to..... m. bearing.....°M

12. Connection..... to..... m. bearing.....°M

13. Diff. Ht. is..... m. above below

14. Diff. Ht. is..... m. above below

15. Diff. Ht. is..... m. above below

16. Diff. Ht. is..... m. above below

Prepared by: K.S. HADDOX 6-8-1976

Checked: 16/5/76

Noted on U.T.M. Card

Checked

STATION BUTLER TS 5618

Co. Cook

Ph: MEROO

Map Sheet: ST. ALBANS

No: 5031-S

Inspected by: K.S. HADDOX

Date: 30-7-1976

Authority: C.M.A.

Field Book:

Beacon Diagram

Not to Scale

No Beacon


Date

Record of Station

Owners Name..... Address..... 	Current Occupant..... Address.....
--	---

Access

kms 30-7-1976	
000	At Kormond P.D. Proceed West along Bells Line of Road towards Lithgow
13	Turn Right. Conkeroy Road to Singleton & Colo
435	Take Left fork.
505	Take Left fork.
110	Cleared paddock on left
111	Turn Left off road through iron gate
	Trig located 17m south west of gate.

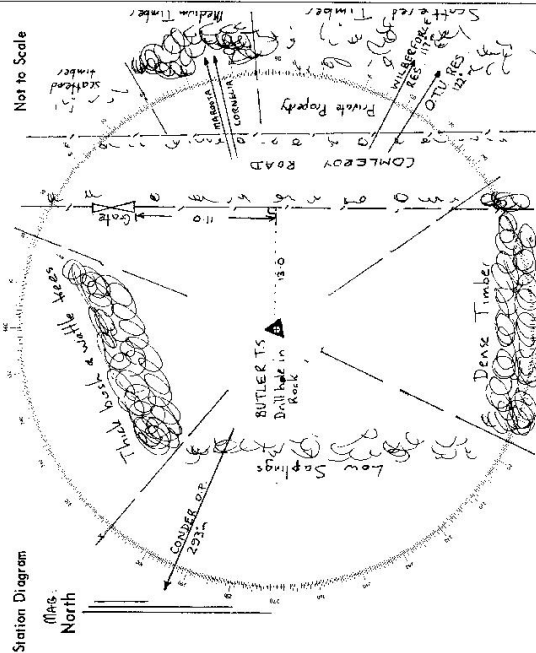

List of Observed Directions:--

[illegible]


Address

Owners Name..

Address:

Access 26-11-1976

PLEASE SEE RECONNAISSANCE REPORT PREPARED BY K. HADDON ON 30/7/76

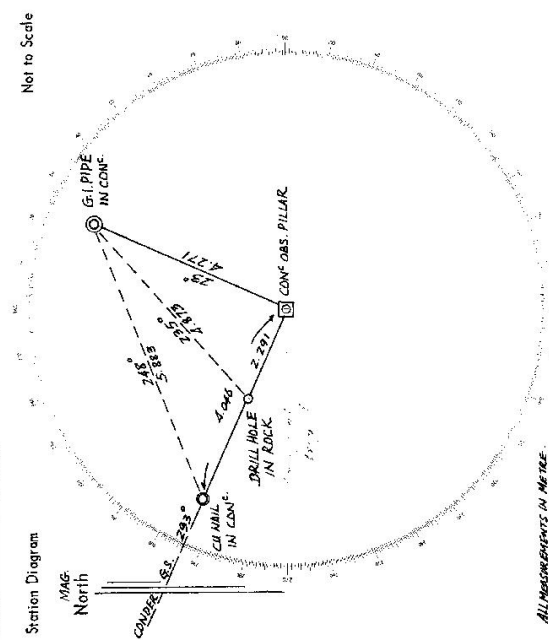

ALL MEASUREMENTS IN METRE.

List of Observed Directions:--

Standpoint: CON^s. OBS. PILLAR

Station	Direction	Station	Direction
CONVER. G.S.O.P.	350° 59' 50"	CONVER. G.S.O.P.	250° 55' 50"
C/L NAIL IN CONC.	360° 00'	STAINLESS STEEL SPIGOT ON PIP	270° 04'
DRILL HOLE IN ROCK	355° 17'	DRILL HOLE IN ROCK	298° 04'
G/L PIPE IN CONC.	90° 01'	C/L NAIL IN CONC.	313° 25' 30"

Station	Direction	Station	Direction
1	2	3	4
5	6	7	8
9	10	11	12
13	14	15	16
17	18	19	20
21	22	23	24
25	26	27	28
29	30	31	32
33	34	35	36
37	38	39	40
41	42	43	44
45	46	47	48
49	50	51	52
53	54	55	56
57	58	59	60
61	62	63	64
65	66	67	68
69	70	71	72
73	74	75	76
77	78	79	80
81	82	83	84
85	86	87	88
89	90	91	92
93	94	95	96
97	98	99	100