

TS 5620 7-4-98

CENTRAL MAPPING AUTHORITY Department of Lands Trigonometrical Survey of N.S.W. RECONNAISSANCE and MAINTENANCE REPORT	STATION <u>DOUBLE HERB (VILLAGE) GS</u> Co: <u>DRIDLEY</u> PH: <u>WIKKI WIKKI</u> Map Sheet: <u>CO 883024 N174</u> No: <u>9335</u> Inspected by: <u>L.V. MUMFIS</u> Date: <u>12th Nov 2022</u> Authority: <u>C.M.A.</u> Field Book: <u>01333</u>
--	--

This Trig. Station has been:-

Note: Cross out word or words which do not apply

1. ~~Completely cleared to permit 360° vision to surrounding Triggs.~~
2. Cleared by lances bearing from Trig. Mast
3. Trig. Mast & Vanes have been painted white & black respectively. ✓
4. The Trig. was unpiled/~~not supplied~~, dimensions now being: Original Station ~~has~~ found, not found

Description of mark..... CONCRETE OBSERVATION POINT should be explicit, e.g. Steel plug, Brass plug, Bolt, G.I. Pipe

Height of mark..... ^{above} 1.3342 m below rock/concrete m above G.L.

Height of Top Vanes to Top Mark 1.410 m. Diameter of Vanes (vertical) 0.755 m.

Height of ~~Capit~~ Signal m. Diameter of Cairn m.

Length of Mast m. (approximate if not unpiled)

5. ~~Brass plug~~ FP set in conc/rock has been placed 2.906 m. bearing 100° from Trig. Mast
6. A S.M. set in conc/soil has been placed 3.26 m. bearing 33° from Trig. Mast
7. A G.M. set in conc/soil has been placed 6.155 m. bearing 87° from Trig. Mast
8. A set in conc/rock has been placed m. bearing from Trig. Mast
9. Connection Brass Plug to S.M. : 3.327 m. bearing 345°
10. Connection Brass Plug to G.I. Bolt : 3.351 m. bearing 82°
11. Connection S.M. to G.I. Bolt : 4.945 m. bearing 121°
12. Connection to m. bearing from Trig. Mast
13. Diff. Ht. Brass Plug to G.I. Bolt is 2.122 m. below Brass Plug
14. Diff. Ht. S.M. to G.I. Bolt is 1.650 m. below Brass Plug
15. Diff. Ht. G.I. Bolt to G.I. Bolt is 1.161 m. below Brass Plug
16. Diff. Ht. is m. ^{above} below


Prepared by: Checked:
Noted on U.T.M. Card

Beacon Diagram

STATION **TS 5620**
DOUBLE HEAD (Pile) CS

Owners Name:
 Current Occupant: **FORRESTER**
 Address: **WILMINGTON, DE 19804**
 Address: **KEMPSON OFFICE**
 Address: **West Kemper**

Station Diagram
 Not to Scale
 North

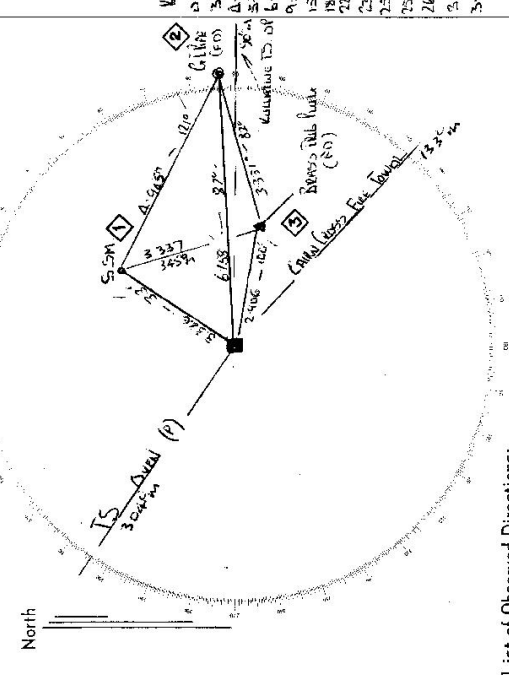

Access
13-11-1976
WILMINGTON PD AND GEORGE STONE TRAVELERS APTS TO WINDS RUNNING
TOUR LEFT SIDE TOOTHBOL
TOUR LEFT SIDE HILL HILL
TOUR BEHIND MOUNTAIN ROAD
TOUR LEFT SIDE MOUNTAIN ROAD TO CORNER
TOUR BEHIND 4 HOUSES
TOUR RIGHT SIDE HILL HILL 7
STREET PAVEMENT SIDE TO CORNER
TOUR DAM CORNER BEH
TOUR BEHIND HILL ROAD
TOUR STAIR RIGHT SIDE FLAT TOP HILL WITH CORNER HILL 2A
CROSS LAINE
TOUR LEFT SIDE HILL HILL TRACK IN MOUNTAIN
TOUR

List of Observed Directions:-

Standpoint: **Concrete Piles**

Station	Direction	Station	Direction
CHINA CROSS FOR TOWER	0.00	CHINA CROSS FOR TOWER	0.00
CHINA T.S. 151.6	30	CHINA T.S. 151.6	30
S.5M IN CONC	281.5	S.5M IN CONC	281.5
G.110 IN CONC	314.22	G.110 IN CONC	314.22
QUARTER T.S. 217	54	QUARTER T.S. 217	54
B.100 IN CONC	325	B.100 IN CONC	325

Standpoint: **Beam, Tall Pole**

Station	Direction	Station	Direction
CHINA CROSS FOR TOWER	0.00	CHINA CROSS FOR TOWER	0.00
CHINA T.S. 151.6	30	CHINA T.S. 151.6	30
S.5M IN CONC	281.5	S.5M IN CONC	281.5
G.110 IN CONC	314.22	G.110 IN CONC	314.22
QUARTER T.S. 217	54	QUARTER T.S. 217	54
B.100 IN CONC	325	B.100 IN CONC	325