

CENTRAL MAPPING AUTHORITY
Department of Lands

Trigonometrical Survey of N.S.W.

RECONNAISSANCE and ~~MAINTENANCE~~ REPORT

This Trig. Station has been:-

Note: Cross out word or words which do not apply

1. Completely cleared to permit 360° vision to surrounding Trigs.
2. Cleared by ~~lanes bearing~~..... from Trig. Mast
3. Trig. Mast & Vanes have been painted white & black respectively.
4. The Trig. was emptied/not unpiled, dimensions now being:

Description of mark..... should be explicit, e.g. Steel plug, Brass plug, Bolt, G.I. Pipe
 Height of mark..... m ^{above} / _{below} rock/concrete..... m ^{above} / _{below} G.L.
 Height of Top Vanes to Top Mark..... m. Diameter of Vanes (vertical)..... m.
 Height of Cairn..... m. Diameter of Cairn..... m.

5. A..... set in conc/rock has been placed..... m. bearing.....°M from Trig. Mast
6. A..... set in conc/soil has been placed..... m. bearing.....°M from Trig. Mast
7. A..... set in conc/soil has been placed..... m. bearing.....°M from Trig. Mast
8. A..... set in conc/rock has been placed..... m. bearing.....°M from Trig. Mast

9. Connection..... to..... m. bearing.....°M
10. Connection..... to..... m. bearing.....°M
11. Connection..... to..... m. bearing.....°M
12. Connection..... to..... m. bearing.....°M
13. Diff. Ht. is..... m. ^{above} / _{below}
14. Diff. Ht. is..... m. ^{above} / _{below}
15. Diff. Ht. is..... m. ^{above} / _{below}
16. Diff. Ht. is..... m. ^{above} / _{below}

Prepared By: K.S. Mulla- 4/1/76 Checked: S. S. 20/7/76 Noted on U.T.M. Card

STATION WADDELL TS 5625


Co: CUMBERLAND Ph: NORTH COZAH

Map Sheet: SYDNEY No: 3307N

Inspected by: K.S. Mulla Date: 29.7.1976

Authority: C.M.A. Field Book:

Beacon Diagram Not to Scale

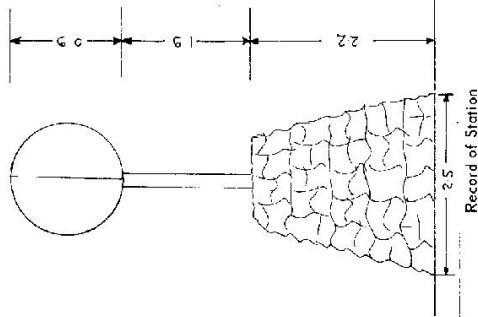


Date

Record of Station

Checked

STATION **WADDELL G.S. TS 5625**

Owners Name.....
 Current Occupant.....
 Address.....
 Address.....
 Access.....

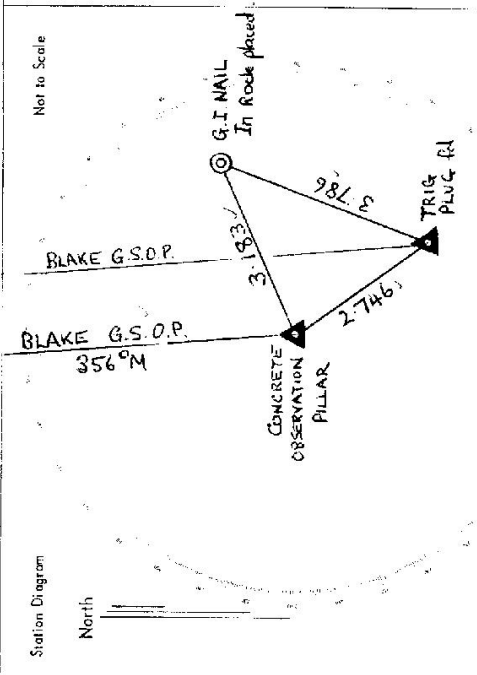

List of Observed Directions:-


Station	Direction	Station	Direction
BLAKE G.S.O.P.	0°00'00"	BLAKE G.S.O.P.	0°00'00"
GI NAIL in rock placed	70°28'14"	GI NAIL in rock placed	25°05'25"
TRIG PLUG rd	141°25'14"	SIS signal	329°26'14"

Station	Direction	Station	Direction

Standpoint: CONCRETE OBSERVATION PILLAR Standpoint: TRIG PLUG

STATION WADDELL TS 5625

Owners Name.....
 Current Occupant.....
 Address.....
 Address.....
 Access.....

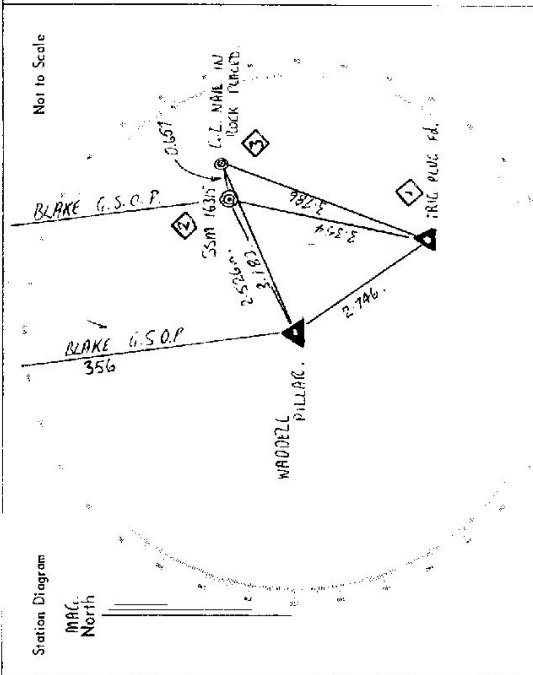

List of Observed Directions:-

Standpoint: WADDELL PILLAR. Standpoint: SSM 16315.

Station	Direction	Station	Direction
BLAKE G.S.O.P.	352° 60'	BLAKE G.S.O.P.	352° 60'
G.L. NAIL FD.	70° 38'	TRIG. PLUG. FD.	197° 08'
SSM 16315	70° 38'	S/S S11601	250° 36'
TRIG. PLUG. FD.	149° 37'		

Station	Direction	Station	Direction

