


STATION HEATON G.S. (P112) TS 5631

Owners Name.....
 Address.....
 Access.....

Current Occupant.....
 Address.....
 Access.....

Not to Scale

Station Diagram

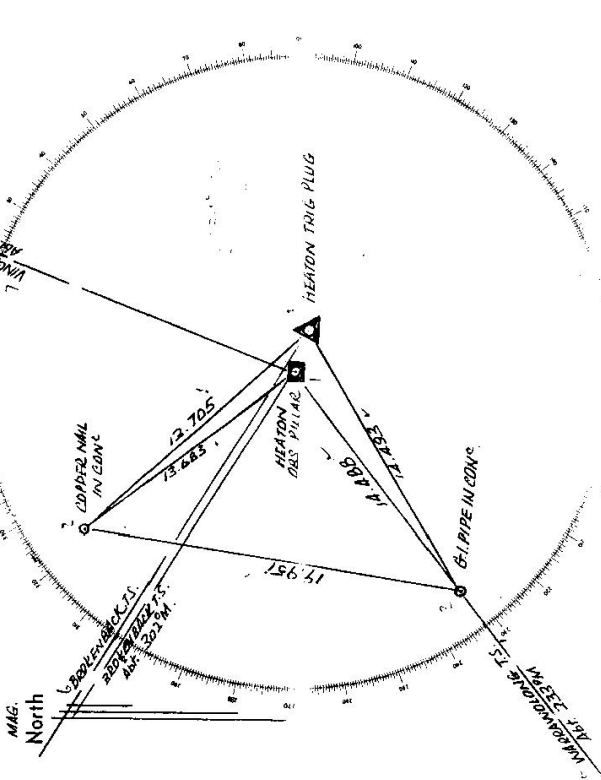

List of Observed Directions:-

Station	Direction	Station	Direction
WOODHOLM TRIG.	359 59 46	WOODHOLM TRIG.	359 59 60
G.I. PIPE IN CONCRETE PLACED	359 59 50	COPPER NAIL IN CONCRETE PLACED	359 59 60
WOODHOLM TRIG.	69 45 41.5	G.I. PIPE IN CONCRETE PLACED	290 19 50
COPPER NAIL IN CONCRETE PLACED	90 08 40		
VALENT T.S. OP	158 12 14		
STATION POINT : G.I. PIPE IN CONC. PLD.		STATION POINT : COPPER NAIL IN CONC. PLD.	
STATION	Direction	STATION	Direction
COPPER NAIL IN CONC. PLD.	359 59 60	359 59 60	359 59 60
TRIG. PLUG	43 27 50	TRIG. PLUG	359 58 30
359 59 60	43 17 20	G.I. PIPE IN CONC. PLD.	46 33 40

GEODETTIC SURVEY OF N.S.W.

CENTRAL MAPPING AUTHORITY

GEODETTIC STATION RECONNAISSANCE and MAINTENANCE REPORT

- Description:
- Note: Cross out word or words which do not apply
- Cleared by lanes bearing.....from Trig. Mast
 - Mast & Vanes have been painted white & black respectively.
 - The station/pillar was unpiled/not unpiled/constructed on.....19....., dimensions now being:
Description of mark.....should be explicit, e.g., S/Steel Pillar Plate, Steel plug, Brass plug, Bolt, G.I. Pipe
Height of mark.....m. above rock/concrete; Mark is.....m. above G.L.
Height of Top Vanes to Top Mark/Pillar plate.....m. Diameter of Vanes (vertical).....m.
Height of Cairn.....m. Diameter of Cairn.....m. Name Plate found/not found/placed.
Length of Mast.....m. (approximate if not unpiled)
 - A.....set in conc/rock has been placed/found, bearing.....°M from Mast/Plug/Pillar
 - A.....set in conc/rock has been placed/found, bearing.....°M from Mast/Plug/Pillar
 - A.....set in conc/rock has been placed/found, bearing.....°M from Mast/Plug/Pillar
 - A.....set in conc/rock has been placed/found, bearing.....°M from Mast/Plug/Pillar
 - Action required:.....

STANDPOINT:

Mark	Direction	Horiz. Distance	Height Difference	Mark	Direction	Horiz. Distance	Height Difference
			above standpt.				above standpt.
			below standpt.				below standpt.
			above standpt.				above standpt.
			below standpt.				below standpt.
Prepared by: P. Berts 8/12/90 Checked: [Signature] 21/10/99 Noted on U.T.M. Card

SI 2793-1

STATION: HEATON (P) No.: 5631

MAP SHEET SCALE 1:250 000 S.W. 1149 000 G.P.S. CHECK.

INSPECTED BY: P. Berts DATE: 23/1/90

AUTHORITY: Laws Incorporated CENTRE FIELD BOOK: 2102

STATION HEATON (P) TS 5631

6: 2735 - 2 D. West, Government Printer

Owner's Name: BARRETT, DAVE Current Occupant:

Address: 203 CRESSNOCK Address:

Address: 174 STEVE SWAY - DISTRICT HEADQUARTERS Phone:

Phone:

ACCESS

Access Report of 23.1.1980 was found suitable/unsuitable.

AM FEATURE

0.00 POST OFFICE CRESSNOCK TRAVEL TOWARDS BARRIBOLONG, ALONG VINCENT STREET

2.03 CROSS RAILWAY LINE

2.17 CROSS RAILWAY LINE

5.21 STRAIGHT AVENUE THROUGH KITCHENER

10.77 TURN LEFT SIGN SYDNEY VIA WYONG, SANDY CREEK ROAD.

13.52 TURN RIGHT SIGN WATAGON STATE FOREST. HEATON LOOKOUT 13 KM.

17.21 GRID

18.42 GRID

19.10 PASS GEORGES ROAD ON RIGHT

20.20 TAKE RIGHT FORK; MACLEAN LOOKOUT ON LEFT.

20.43 PASS WATAGON FOREST HEADQUARTERS CAMPING AREA ON LEFT

21.00 PASS HAYMONDS ROAD ON LEFT

23.31 TAKE LEFT FORK SIGN HEATON LOOKOUT 4 KM.

23.51 PASS ROAD ON RIGHT

25.22 TURN LEFT SIGN HEATON ROAD LOOKOUT PENIC AREA.

26.88 HEATON LOOKOUT ON RIGHT

26.95 TAKE LEFT FORK

27.26 TAKE LEFT FORK

27.49 GRID

29.33 HEATON (P) ON PLATFORM ON RIGHT NEAT TO TELECOM TOWER ✓

Date	Record of Station

Not to Scale

Beacon Diagram		

This section to be completed by officer constructing pillar.

Original station mark found/not found.

Description of mark:

Original beacon found/not found.

Description of beacon:

Height Top of Vane to Top Markm.

Height of markm. above G.L. / below rock/conc.m. above G.L. / below

Diameter of Vanesm. Height of Cairnm.

Original Beacon has/has not been destroyed by ma.