

STATION CAMPBELL^{TS} 5635

Current Occupant.....

Address.....

Owners Name.....


Address.....

Access 30-1-1975

Not to Scale

Station Diagram

North

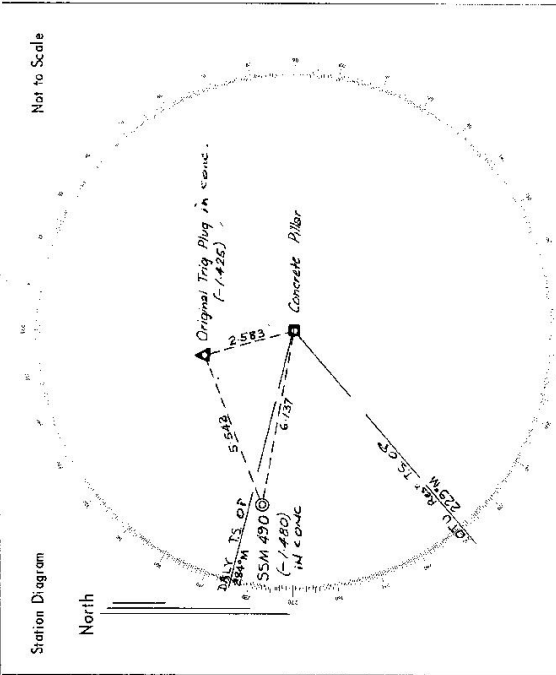

List of Observed Directions:-

Station	Direction	Station	Direction
O.T.V. Rest. T.S. OP	359° 59' 60"	O.T.V. Rest. T.S. OP	359° 59' 60"
DAILY T.S. OP	55° 58' 30"	Trig. Plug	206° 14' 30"
SSM 490	51° 08' 00"	S.P. 33 of	731° 10' 40"
Trig. Plug	115° 44'		
Standpoint: Pillar		Standpoint: SSM 490	
Station	Direction	Station	Direction