

CENTRAL MAPPING AUTHORITY
Department of Lands

Trigonometrical Survey of N.S.W.

RECONNAISSANCE and MAINTENANCE REPORT

This Trig. Station has been:-

Note: Cross out word or words which do not apply

1. Completely cleared to permit 360° vision to surrounding Trig.
2. Cleared by lanes bearing 340°M to 255°M; 255°M to 150°M; 150°M to 320°M from Trig. Mast
3. Trig. Mast & Vanes have been painted white & black respectively. ✓
4. The Trig. was unpiled/~~not unpiled~~, dimensions now being:


Description of mark... Concrete Pillar should be explicit, e.g. Steel plug, Brass plug, Bell, G.I. Pipe
 Height of mark..... m above rock/concrete 1.3 m above G.I.
 Height of Top Vanes to Top Mark..... 1.32 m. Diameter of Vanes (vertical)..... 0.75 m.
 Height of Cairn..... m. Diameter of Cairn..... m.

5. A. Trig. Plug set in conc/rock has been placed..... 2.688 m. bearing..... 3.0°M from Trig. Mast
6. A. G.I. Pipe set in conc/soil has been placed..... 3.271 m. bearing..... 301.0°M from Trig. Mast
7. A..... set in conc/soil has been placed..... m. bearing..... °M from Trig. Mast
8. A..... set in conc/rock has been placed..... m. bearing..... °M from Trig. Mast
9. Connection... Plug... to G.I. Pipe : 3.116 m. bearing..... 251.0°M
10. Connection..... to..... m. bearing..... °M
11. Connection..... to..... m. bearing..... °M
12. Connection..... to..... m. bearing..... °M
13. Diff. Ht. Trig. Plug is 1.520 m. ^{above} ~~below~~ Pillar Plate
14. Diff. Ht. G.I. Pipe is 1.460 m. ^{above} ~~below~~ Pillar Plate
15. Diff. Ht. is..... m. above.....
16. Diff. Ht. is..... m. above.....

Prepared by: [Signature] Checked: [Signature] Noted on U.T.M. Card 39.0.7x

STATION DALY TS 5638
 Co: Cumberland Ph: Maroota
 Map Sheet: PENRITH No: 9030
 Inspected by: T. Morrison Date: 29-1-75
 Authority: C.M.A. Field Book: 1432

Beacon Diagram Net to Scale

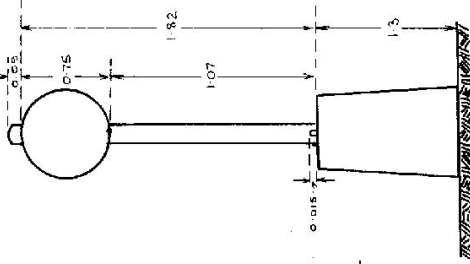

Date	Record of Station

Checked

STATION **DALY TS 5638**


Current Occupant.....

Address.....

Owners Name.....

Address.....

Access **29-1-1975**

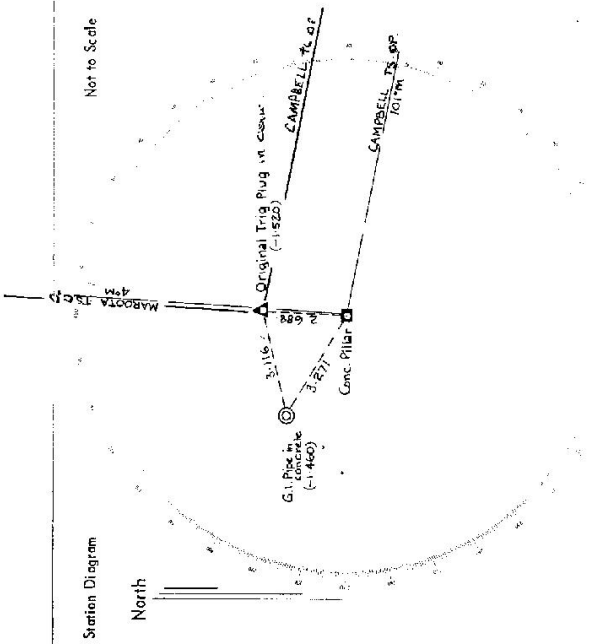

List of Observed Directions:-

Standpoint: Pillar		Standpoint: Trig. Plug	
Station	Direction	Station	Direction
MAROOHA TS OP	353 59 60	MAROOHA TS OP	353 59 60
CAMPBELL TS OP	97 28 58	CAMPBELL TS OP	97 30 37
G.I. Pipe in conc.	236 42	Pillar Spigot	178 49
Trig Plug	353 49	G.I. Pipe in conc.	247 00
Station	Direction	Station	Direction

St 2733-2 D. West, Government Printer

STATION	DALY TS 5638
Owner's Name:	Current Occupant:
Address:	Address:
Phone:	Phone:
<p>Access Report of 25.7.1977 was found suitable/unsuitable:</p> <p style="text-align: center;">ACCESS</p>	
	Ref: 0160.031.CS.8027
Date	Record of Station
25-7-97	<p>PILLAR FOUND - MOSTLY DOWN BUT O.K. SURROUNDED BY TREES BUT SOME GPS POSSIBLE. - RTA SURVISORS - PARRAMATTA. Ray Glenon</p>

Beacon Diagram		Not to Scale
<div style="background-color: #e0e0e0; width: 100%; height: 100%;"></div>		

This section to be completed by officer constructing pillar.

Original station mark found/not found.

Description of mark:

Original beacon found/not found.

Description of beacon:

Height Top of Vanes to Top Mark.....m.

Height of mark.....m. above G.L. below

Diameter of Vanesm. Height of Cairnm.

Original Beacon has/has not been destroyed by me.