

7.4-98

CENTRAL MAPPING AUTHORITY  
 Department of Lands  
 Trigonometrical Survey of N.S.W.  
 RECONNAISSANCE and MAINTENANCE REPORT

STATION HUNTER TS 5639

Co: Hunter  
 Map Sheet: ST. ALBANS  
 Inspected by: T. Morrison  
 Authority: C. M. A.  
 No: 9031  
 Date: 6.2.75  
 Field Book: 1432  
 Not to Scale

This Trig. Station has been: Note: Cross out word or words which do not apply


1. Completely cleared to permit 360° vision to surrounding Trig.
2. Cleared by Janes bearing 99-132°M; 213-5°M from Trig. Mast
3. Trig. Mast & Vanes have been painted white & black respectively. ✓
4. The Trig. was unpiled/not unpiled, dimensions now being:

Description of mark: Conc. Pile. should be explicit, e.g. Steel plug, Brass plug, Bolt, G.I. Pipe  
 Height of mark: 1.3 m above rock/concrete base above G.L.  
 Height of Top Vanes to Top Mark: 1.47 m Diameter of Vanes (vertical): 0.75 m.  
 Height of Cairn: m. Diameter of Cairn: m.

- Length of Mast: 1.56 m. (approximate if not unpiled)
5. A Trig. Plug set in conc/rock has been placed: 2.525 m. bearing 144°M from Trig. Mast
  6. A G.I. Pipe set in conc/soil has been placed: 2.530 m. bearing 115°M from Trig. Mast
  7. A set in conc/soil has been placed: m. bearing °M from Trig. Mast
  8. A set in conc/rock has been placed: m. bearing °M from Trig. Mast

9. Connection: Plug to G.I. Pipe: 1.240 m. bearing 40°M
10. Connection: to: m. bearing °M
11. Connection: to: m. bearing 94°M
12. Connection: to: m. bearing °M SENIOR TRIGONOMETRICAL SURVEYOR
13. Diff. Ht. Trig. Plug is: 1.265 m. below Pile. Plate
14. Diff. Ht. G.I. Pipe is: 1.239 m. above below
15. Diff. Ht. is: m. above below
16. Diff. Ht. is: m. above below

Prepared by: A. Hunter Checked: S. W. Noted on U.T.M. Card

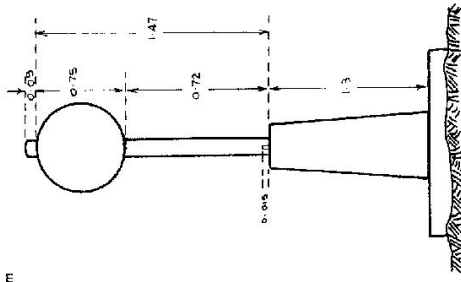

Date: Record of Station

Checked



CENTRAL MAPPING AUTHORITY

GEODETIC SURVEY OF NSW

GEODETIC STATION RECONNAISSANCE and MAINTENANCE REPORT


STATION: **HUNTER** No.: **5639**

MAP SHEET SCALE 1:250 000 **SYDNEY**

INSPECTED BY: **G. DICKSON** DATE: **28th Nov. 78**

AUTHORITY: **C.M.A.** FIELD BOOK: **169**

Description: *Note: Cross out word or words which do not apply*  
 1. Cleared by lances bearing..... **SLIGHT CLEARING FOR 160 HORIZON**..... from Trig, Mast  
 2. Mast & Vanes have been painted white & black respectively.  
 3. The station/pillar was unpiled/not unpiled/constructed on..... 19....., dimensions now being:  
 Description of mark **S/S PILLAR PLATE** should be explicit, e.g., S/Steel Pillar Plate, Steel plug, Brass plug, Bolt, G.I. Pipe  
 Height of mark.....m. above rock/concrete; Mark is.....m. above G.I. below  
 Height of Top Vanes to Top Mark/Pillar plate **1.44**.....m. Diameter of Vanes (vertical) **4.75**.....m.  
 Height of Cairn.....m. Diameter of Cairn.....m. Name Plate found/~~not found~~/placed.  
 Length of Mast.....m. (approximate if not unpiled)  
 4. A.....set in conc/rock has been placed/found, bearing.....° M from Mast/Plug/Pillar  
 5. A.....set in conc/rock has been placed/found, bearing.....° M from Mast/Plug/Pillar  
 6. A.....set in conc/rock has been placed/found, bearing.....° M from Mast/Plug/Pillar  
 7. A.....set in conc/rock has been placed/found, bearing.....° M from Mast/Plug/Pillar  
 8. Action required:.....

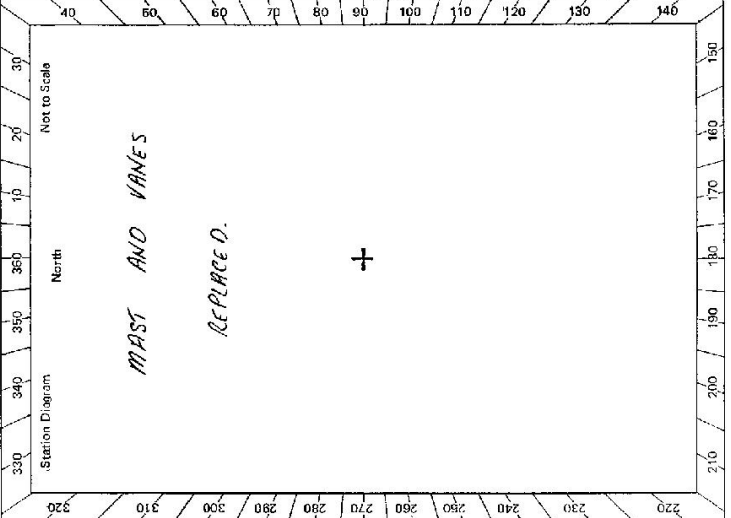

STANDPOINT:						
Mark	Direction	Horiz. Distance	Height Difference	Direction	Horiz. Distance	Height Difference
			above standpt.			above standpt.
			below			below
			above standpt.			above standpt.
			below			below
Prepared by: ..... Checked: ..... Noted on U.T.M. Card

STATION <b>HUNTER. TS 5639</b>	Owner's Name: ..... Address: ..... Phone: ..... Current Occupant: ..... Address: ..... Phone: ..... ACCESS Access Report of <b>28.8.1978</b> was found suitable/unsuitable. <b>KILOMETERS</b> 0.0 0.45 0.9 1.35 3.0 5.75 6.00 7.75 8.45 9.5 10.05 10.15 FEATURE BRIDGE OVER COLD RIVER LOWER PORTLAND. CROSS BRIDGE. INTERSECTION - STRAIGHT AHEAD ROAD TO LEFT 'WARRUMARRU RIDGE RL'. COLD HEIGHTS PARK. SEALED ROAD ENDS. TURN LEFT. SOUTHS JUNIORS TOURIST HOTEL. GATE + COURSE. FORK - VEER LEFT. PROPERTY ON RIGHT 'MARDOO VALLEY STUD'. FORK - TURN LEFT, SIGN 'MUNYARRA' TO RIGHT. STRAIGHT AHEAD - TRACK TO LEFT. FORK - TURN LEFT - BLAZED TREE CENTRE OF FORK. FOLLOW TRACK - OCCASIONAL BLAZES. ROCKY SECTION A.H.D. ONLY. TRUC.
Beacon Diagram Not to Scale 	This section to be completed by officer constructing pillar. Original station mark found/not found. Description of mark: ..... Original beacon found/not found. Description of beacon: ..... Height Top of Vanes to Top Mark .....m. Height of mark .....m. above G.L. below G.L. Diameter of Vanes .....m. Height of Cairn .....m. Original Beacon has/not been destroyed by me.
Date	Record of Station

Sr 2739-2 D. Weet. Government Printer

CENTRAL MAPPING AUTHORITY

GEODETIC STATION RECONNAISSANCE and MAINTENANCE REPORT

Description:

Note: Cross out word or words which do not apply

1. Cleared by vanes bearing..... from Trig. Mast
2. Mast & Vanes have been painted white & black respectively.
3. ~~The station/pillar was unspiked/not unspiked/constructed on~~.....<sup>19</sup>....., dimensions now being:
  - Description of mark.....~~should be explicit, e.g., S/Steel Pillar Plate, Steel plug, Brass plug, Bolt, G.I. Pipe~~
  - Height of mark <sup>above</sup> ~~below~~ .....m. Mark is <sup>above</sup> ~~below~~ .....m. G.L.
  - Height of Top Vanes to ~~Top Mark/Pillar plate~~ .....<sup>1.43</sup>.....m. Diameter of Vanes (vertical) .....<sup>0.75</sup>.....m.
  - ~~Height of Cairn~~.....m. Diameter of Cairn.....m. Name Plate found/not found/placed:
  - Length of Mast .....<sup>1.51</sup>.....m. (approximate if not unspiled)
4. A.....set in conc/rock has been placed/found, bearing.....°M from Mast/Plug/Pillar
5. A.....set in conc/rock has been placed/found, bearing.....°M from Mast/Plug/Pillar
6. A.....set in conc/rock has been placed/found, bearing.....°M from Mast/Plug/Pillar
7. A.....set in conc/rock has been placed/found, bearing.....°M from Mast/Plug/Pillar
8. Action required:.....

STANDPOINT:

Mark	Direction	Horiz. Distance	Height Difference	Mark	Direction	Horiz. Distance	Height Difference
			above standpt. below				above standpt. below
			above standpt. below				above standpt. below
STANDPOINT:

Mark	Direction	Horiz. Distance	Height Difference
			above standpt. below
			above standpt. below
Prepared by:

Checked:

Noted on U.T.M. Card

Checked *[Signature]*

STATION: *HUNTER (P)* No.: *5639*

MAP SHEET SCALE 1:250 000

INSPECTED BY: *K. J. PATT* DATE: *8/12/82*


AUTHORITY: *J.M.R.* FIELD BOOK:

Station Diagram

Not to Scale

St 2733-2 D. West, Government Printer

STATION **5639 HUNTER (P)**

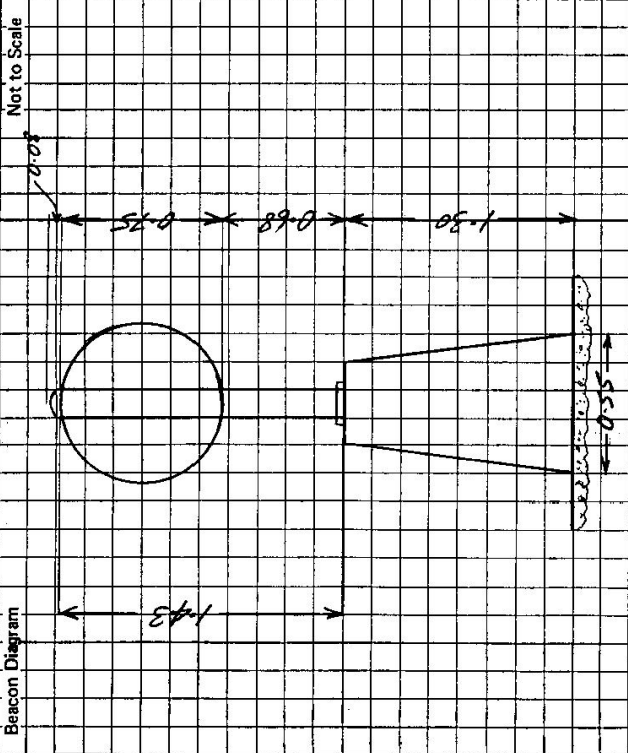

Owner's Name: .....  
 Address: .....  
 Phone: .....

Current Occupant: .....  
 Address: .....  
 Phone: .....

**ACCESS**

Access Report of 8/12/1982 was found suitable/unsuitable.

- 00 At Wisemans Ferry Police Station. Head south to lower Portland
- 0.31 Webbs Creek Ferry on right.
- 14.98 Cliftonville Ski Lodge. Road to Maroota on left.
- 23.07 Turn Right to Portland Ferry. Sign Wisemans Ferry 22-Windsor 27
- 23.14 Ferry Gate.
- 23.45 Junction. Road to Wilberforce. Turn right over Colo River Bridge.
- 23.55 Centre Colo River Bridge.
- 23.89 Road to Colo Heights on left.
- 26.59 Souths Juniors Tourist Motel "Una Voce" Centre Mah Building.
- 29.28 Gate "Mardoo Valley Stud".
- 29.54 House, Take left fork up hill.
- 31.41 Turn left up hill. Sign: Wisemans Ferry-Private Property-  
No Through Road.
- 31.61 Power Stauchion No. 91. Keep Stauchion on your left.
- 32.14 Track on left.
- 33.18 Turn left.
- 33.87 Pillar.

This section to be completed by officer constructing pillar.

Original station mark found/not found.

Description of mark: .....

Original beacon found/not found.

Description of beacon: .....

Height Top of Vanes to Top Mark.....m.

Height of mark.....m. above rock/conc.....m. below G.L.

Diameter of Vanes.....m. Height of Cairn.....m.

Original Beacon has/has not been destroyed by me.

Date	Record of Station