
CENTRAL MAPPING AUTHORITY	86-94-2
Department of Lands	STATION BAYNES FILL PALLE 5646
This Trig. Station has been:-	Co: UFRNON Ph: ECCA
	Map Sheet: Shray Dures 1236
1. Completely eleared to pormit 360° vision to surrounding Trigs.	Inspected by: L. J. Homs Date: 21 11 1971
2. Cleared by lanes bearingfrom Trig. Mast	
3. Trig. Mast & Vanes have been painted white & black respectively. V	Beacon Diagram Not to Scale
4. The Trig. was unpiled/nat u	1/
Description of mark	Sold (O O O O O
Height of mark1370	Mary Council Conf.
Height of Top Vanes to Top Mark(Albm.	a.
Height of Gamm. Co. O. S.	
Length of Mast	
5. A.Talu. Muset in conc/rock has been plesed. 3 COUm. bearing	Name Large
6. A.S.S.Mset in conc/sett has been placed. 1.326m. bearing	867
7. A. G38995set in conc/seei has been planered	
8. Aset in conc/rock has been placedm. bearing	
9. Connection 3000 Met. to. 5.5. M : 253. m. bearing 316 9M (at 122 w land 18 122) observing his	
10. Connection Brown But to Giffer : Bast m. bearing Ith M. Lane 15 to 18 below 65 M.	というというという
11. Connection 5.5% to 6.5% to 6.8%	Date Record of Station
12. Connectiontom. bearing	( Can pullar es
13. DIH. H. SAFES RUD M. M. LAKEL IS J. 28. In begins	
15. Diff. Hr. 18 North 18 Joseph 15. 19 155 m. obstance March Baseline	
Let Couls is a stat m. above Thus I'M	
Prepared by: R Holls Card Checked: Checked:	Checked

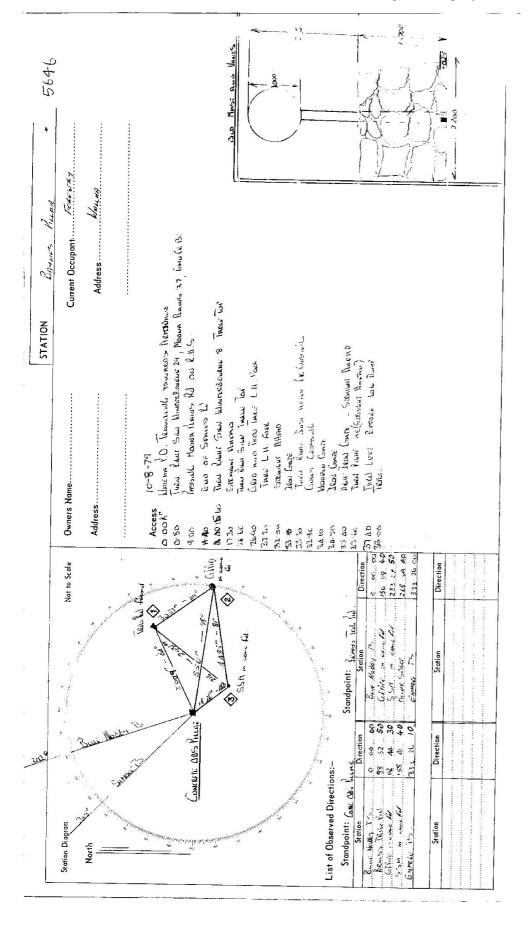

Direction  Distance  Direction  Distance  Dist		ORT STATION: BANES GSOP * No.: 5646	MAP SHEET SCALE 1:250 000 ARMIDALE	INSPECTED BY: C. Zahra DATE: :0-6-74	AUTHORITY: CMA FIELD BOOK: 1778	330 340 350 360 10 20 30	G.I. Pipe Station Diagram North Not to Scele	, /		nd/placed.	/ oois			082	1-	seo /	\0	Height Difference	above standpt. No below standpt.	above standpt.	above standpt.	above standpt,	above standpt, below	above standpt. No.	above wode
Sebering	GEODETIC SURVEY OF ILS.W.	RECONNAISSANCE and MAINTENANCE REPC	te: Cross out word or wards which do noyapply	from Trig. Mast	\ \	19, dimensions now being:	S/Steel Pillar Plate, Steel plug, Brass plug, Bolt, G	Mark is below G.L.	R. Diameter of Vanes (vertical)m.	irnm. Name Plate found/not found/placed.	ympiled)	found, bearing"M from Mast/Plug/Pillar	found, bearing"M from Mast/Plug/Pillar	found, bearing, M from Mast/Plug/Pillar	found, bearing"M from Mast/Plug/Pillar		STANDPOINT:	Direction Distance							
~ · =	CENTRAL MAPPING AUTHORITY	GEODETIC STATION F	Not	1. Cleared by lanes bearing	Mast & Vanes have been painted white & black respectively.	llar was unpiled/not unpiled/constructed on	markshould be explicit, e.g.,	Height of markm. above rock/concrete;	1:	Height of Cairn	Length of Mastm. (approximate if not	set in conc/rock has been plaged/f	set in sone krock has been placed/fi	set ir concircock has been placed/fi	7. A	8. Action required:		Horiz, Distance	above standpt.	above standpt.	above standpt.	above standpt.	above standpt.	above standpt.	above standot

33–2 D. West, Government Printer		STATION BANNES GSOP	* 5646
pacon Diagram Not to Scale		!	
	Owner's I	Owner's Name:ForestXy_Downs.ss.ori	TEKTY DOMM SSIGN.
	Address:	Address:	alche
		***************************************	***************************************
	Phone:		***************************************
		ACCESS (C	
	A Access B	Access Bonort of 21 / 12/1076was found suitable insuitable	
	0.0 Klm	0.0 Kim Waldra 9 C travel tenrands Armidale	
	D-B Turn	Turn right sign Winterbourne 29 Mound Plains 37 Emolt 13	
_	8-0 Pass	Pass Acona Plains Road on right	
	14.4 End	End of seuled lead.	
	15.6 Turn	Turn right sign Winterbourne & Table Top	
	17-3 Straic	Straight Ahead	
	24.6 Turn	Turn right-Sign Table Top	
	26.9 Brid	Brid and then take Left fork	
	32.2 Take	Take left fork.	
		Straight Ahand	
		Iron Gate	
	13.3 Turn	Turn right just after creek crossing	
		Ûrossing	
	34 · 1 Much	Wooden Gaite	
his section to be completed by officer constructing pillar.	34.5 Iron	I con Bate Through high ion gate - veer right, take truck between two bared trees (buit take Apsley track)	ees (Duit take Apoley track)
		cossing - veer right into opening in trees, then veer lett	
riginal station mark found/not found,	-	St. 6 both Crossings	
escription of mark;	31.35 Tun	Turn left before log dump and tollow tain't blazed Track. Bannes GSOP	
riginal beacon found/not found.			
escription of beacon:	Date	Record of Station	
eight Top of Vanes to Top Mark			
eight of markn., above rock/concm.,			***************************************
woled wolld		***************************************	***************************************
iameter of Vanesm. Height of Cairnm.			
riginal Beacon has/has not been destroyed by me.			***************************************
		the state of the s	