

7400

CENTRAL MAPPING AUTHORITY
Department of Lands
Trigonometrical Survey of N.S.W.
RECONNAISSANCE and MAINTENANCE REPORT

STATION MIDONIA HILL IS 5650
Co: VERNON Ph: FENWICK
Map Sheet: YARRA WATER No: 9235
Inspected by: T. R. HOWES Date: 22nd Dec 1976
Authority: LANDS Field Book: 6115

This Trig. Station has been: Note: Cross out word or words which do not apply


1. ~~Completely cleared to permit 360° vision to surrounding Trig.~~
2. Cleared by lanes bearing from Trig. Mast
3. Trig. Mast & Vanes have been painted white & black respectively. ✓
4. The Trig. was unpainted/~~not unpainted~~, dimensions now being: ~~.....~~

Description of mark: ~~Concrete. 0.15. 3.00~~ should be explicit, e.g. Steel plug, Brass plug, Bolt, G.I. Pipe
Height of ~~mark~~ ^{plug} m above rock/concrete m above G.L.
Height of Top Vanes to Top ~~Mark~~ ^{plug} m. Diameter of Vanes (vertical) m.
Height of ~~mark~~ ^{plug} m. Diameter of Cairn m.

- Length of Mast m. (approximate if not unpeeled)
5. A. S.S.M. set in conc/~~rock~~ has been ~~placed~~ ^{found} m. bearing °M from Trig. Mast ~~Plm.~~
 6. A. ~~Concrete~~ ^{found} set in conc/~~rock~~ has been ~~placed~~ ^{found} m. bearing °M from Trig. Mast ~~Plm.~~
 7. A. G.I. ~~set~~ ^{found} in conc/~~rock~~ has been ~~placed~~ ^{found} m. bearing °M from Trig. Mast ~~Plm.~~
 8. A. set in conc/rock has been placed m. bearing °M from Trig. Mast

9. Connection ~~between S.S.M. to S.S.M.~~ ^{found} m. bearing °M
10. Connection ~~between S.S.M. to G.I. Pipe~~ ^{found} m. bearing °M
11. Connection ~~S.S.M. to G.I. Pipe~~ ^{found} m. bearing °M
12. Connection to m. bearing °M
13. Diff. Ht. ~~between S.S.M. and G.I. Pipe~~ ^{found} is m. ~~above~~ ^{below} ~~Plm.~~
14. Diff. Ht. ~~S.S.M. and G.I. Pipe~~ ^{found} is m. ~~above~~ ^{below} ~~Plm.~~
15. Diff. Ht. ~~between G.I. Pipe and G.I. Pipe~~ ^{found} is m. ~~above~~ ^{below} ~~Plm.~~
16. Diff. Ht. is m. ~~above~~ ^{below} ~~Plm.~~

Prepared by: R. Howes Checked: Noted on U.T.M. Card

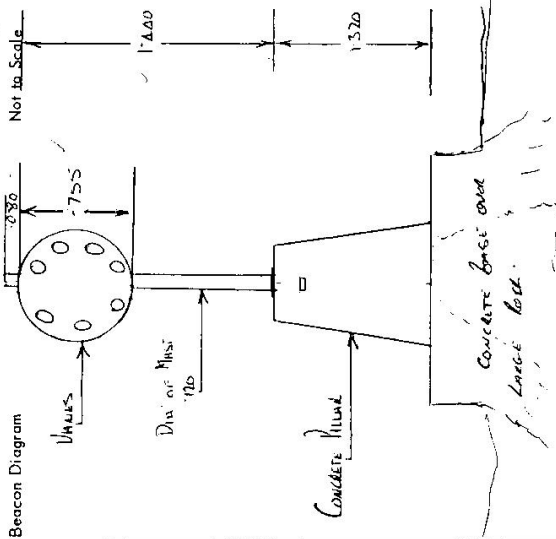

Date: 21/12/76
Record of Station
Concrete Plug established.

CENTRAL MAPPING AUTHORITY

GEODETIC SURVEY OF N.S.W.
 GEODETIC STATION RECONNAISSANCE and MAINTENANCE REPORT


STATION: **MOONA** No.: **5650**

MAP SHEET SCALE 1:250 000
 INSPECTED BY: **Hastings**

DATE: **4-6-79**

AUTHORITY: **CMA**

Station Diagram

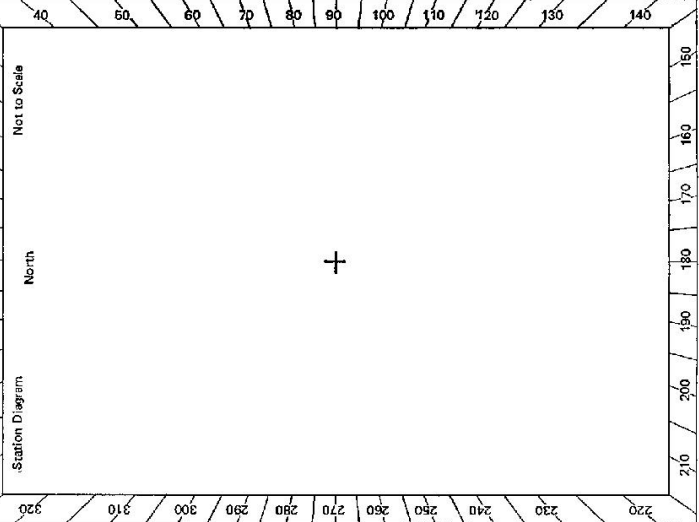

Note: Cross out word or words which do not apply

- 1. Cleared by lanes bearing..... from Trig. Mast
- 2. Mast & Vanes have been painted white & black respectively.
- 3. The station/pillar was unpiled/hot unpiled/constructed on.....19..... dimensions now being:
 Description of mark..... should be explicit, e.g., S/Steel Pillar Plate, Steel Plug, Brass plug/Bolt, G.I. Pipe
 Height of mark.....m. above rock/concrete; Mark is.....m. above G.L.
 Height of Top Vanes to Top Mark/Pillar plate.....m. Diameter of Vanes (vertical).....m.
 Height of Cairn.....m. Diameter of Cairn.....m. Name Plate found/hot found/placed.
 Length of Mast.....m. (approximate if not impiled)
- 4. A.....set in conc/rock has been placed/found; bearing.....°M from Mast/Plug/Pillar
- 5. A.....set in conc/rock has been placed/found, bearing.....°M from Mast/Plug/Pillar
- 6. A.....set in conc/rock has been placed/found; bearing.....°M from Mast/Plug/Pillar
- 7. A.....set in conc/rock has been placed/found, bearing.....°M from Mast/Plug/Pillar
- 8. Action required.....

STANDPOINT:			
Mark	Direction	Horiz. Distance	Height Difference
			above standpt.
			below standpt.
			above standpt.
			below standpt.
Prepared by: **AS 12-2-80** Checked: **17/3/80** Noted on U.T.M. Card

Checked

