
86-12	STATION LUKERS PORTERS IS 5651	Co: HANNES Ph: Stock Map Sheet: Manbautru SH. No: 4135 South	by: L. R. Hours Date: will Feb.	Authority Field Book: D1340	Beacon Diagram Not to Scale	00	357	See A See 1		<del></del>		1	378	<b>→</b>	(4) thurst Conserved	77-17		Date Record of Station				•		Checked
Trigor - strical Survey of N.S.W.	RECONNAISSA NA MAINTENANCE REPORT	Note: Crass out ward or wards which do not apply	to surrounding Trigs.	L'AMES CAUST	۱۶. ر	isions now being:	Description of mark Craccours. Observativate Sympth should be explicit, e.g. Steel plug, Brass plug, Bolt, G.L. Pipe	above reek/concrete	NASS. m. Diameter of Vanes (vertical) 7555m.	Diameter of Cairn	(approximate if not unpiled)	AGARDORE Groeset in conclosed has been pleece. 4453m. bearing	A.S.S.Mset in conc/soil has been placed 3327m. bearing95 from Trig. Mast	placedn. bearing	placedm, bearing	9 m. bearing6ds9M	m. bearing9M	m. bearingM	m. bearing9M	22 . m. comes Burned Bentos	24. m. oberes Russe Partie	D.2. m. charte date Cathering below.		Checked: Noted on U.T.M. Card
CENTRAL MAPPING AUTHORITY	Department of Lands	This Trig. Station has been:-	1. C <del>ompletely cleared to permit 360° vicion to currounding Trigs-</del>	2. Cleared by lanes bearing	3. Trig. Mast & Vanes have been painted white & black respectively.		Description of markCanadems. Observe	Height of Hampet1:33.0m below rock/concrete	Height of Top Vanes to Top Ment. 1725			5. AGARLUDKE CASESET in concress has been	6. A. S. S.Mset in conc/soil has been	7. Aset in conc/soil has been placed	8. Aset in conc/tock has been placedm. bearing	9. Connection Grate Met 1646. SSM: 7:414 m. bearing 6469M	10, Connection	11. Connectionto m. bearing 11.	12. Connectiontotom. bearing9M	13. Diff. Ht. Cattlebea Lase St. is. 1872. m. Delay Blung. Bank	14. Diff. Ht. \$5.19.19.10.00c1615.22	15. Diff. Ht. S.S.M. W. COMC. Lelin. is. 12:00.22. m. oberion.	16. Diff. Htis	Prepared by: Che

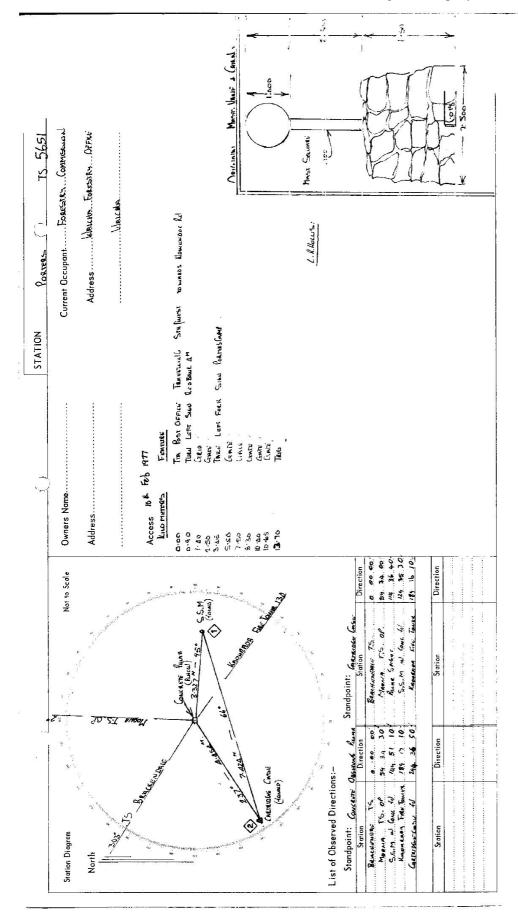

					(0) 3051000	7.50
GEODETIC STAT	GEODETIC STATION RECONNAISSANCE and MAINTENANCE REPORT	MAINTENANCE REPC		SIATION:		(O)
	Note: Cross out word or words which do not apply	ds which do not apply		MAP SHEET SCALE 1:250 000	HASTINGS	
1. Cleared by lanes bearing		from Trig. Mast		INSPECTED BY: (	G. JONES.	DATE: 16/6/81
Mast & Vanes have been painted white & black respectively.	ively.			AUTHORITY:	cmy.	FIELD BOOK: 1915
The station/pillar was unpiled/not unpiled/constructed on	191	dimensions now being:	K	330 340	350 360	10 / 20 / 30
/s. / Perfershould be explicit.	be explicit, e.g., S/Steel Piliar Plate, Steel plug, Brass plug, Bolt, G.I. Pipe	plug, Brass plug, Bolt, G	.l. Pipe	Station Diagram	MAG. North	Not to Scale
Height of markm. below rock/concrete;	Mark is G.L.	" G.L.	/	, 	- {	
Height of Top Vanes to Top Mark/Pillar plate		Diameter of Vanes (vertical)m.	Ė		C/00	1. Col.
Height of Cairn	m.	Name Plate found/not found/placed.	/_	30 70 70	2 Consed	という
Length of Mastm. (approximate if not unpiled)	if not unpiled)		΄ ορόε	3	lone	St. John S.
4. Aset in conc/rock has been placed/found, bearing	1	2M from Mast/Plug/Pillar	/ 00	legred	W. C.	Colored Colored
Aset in conc/rock has been placed/found, bearing	aced/fourid, bearing	from Mast/Plug/Pillar	<u>.</u>	2	いっという	Joe 71°m
set in conciner has been placed/found, bearing	aced/found, bearing°M	from Mast/Plug/Pillar	080 1	oás Seo		Cleared Fig.
7. Aset in conc/rock has been placed/found, bearing	aced/found, bearing,	from Mast/Plug/Pillar	0/2	olz o	₩ 1.5.	\$250 \$250
8. Action required:			1	Seo	52	
	STANDPOINT:		103		3	PORTERS (P)
Direction Horiz, Height Difference	nce Mark	Direction Distance		3	YEW Y	
above standpt.	tandpt			540	O. S.	clear
above standpt.	andpt.			25.50	c/ear.	te
above standpt.	landpt			SEZ		(0)
above standpt.	andpt.		above standpt.			16 S
above standpt.	tandpt.		above standpt,			4UT)
above standpt.	andpt		above standpt.	ızz		
above standpt.	tandpt		above standpt.	210 / 200	190 180	170 160 150
1 Checked:	ked:	Noted on U. T.M. Card	f. Card		Checked	

Beacon Diagram Not to Scale			
	Owner's Name. ENFIELD STATE FOREST.	O STATE FOREST.	Current Occupant:
	Address:Address:	FORESTER	Address:
	PO. 80x 7/ WALCHA 2354.	WALCHA 2354.	mooneman managa ka
Concrate what found in good order	Thomas and the same of the sam	ACCESS	
	Access Report of/.5./19	Access Report of//1972,was found suitable/unsuitable.	
	ES	TEATURE	ě
	00.00	Tia P.O. Travelling Sth/West	ng Sth/West
		towards Nowendoc Road.	Road.
	06.00	Turn left sign Redbank 4m.	dbank 4m.
	1.40	Grid .	
	2.50	Gate.	•
	3.45	Take left fork sign Porters	gn Porters
		Camp.	
	Noon S	Gate. Gate. Gate.	
This section to be completed by officer constructing pillar.	8.30	Gate.	<b>≠</b> 3.
Outsing season marks for real fact for real	10.40	Gate.	**
	10.65	Gate.	
	2		4w9 1912 WERSTURES
Original beacon tound/not round.	3 000 000 000 000 000 000 000 000 000 0		Access.
Description of beacon:	Date	Rec	Record of Station
Height Top of Vanes to Top Mark			
Height of markm actors rock/concm. below G.L.			
Diameter of Varies		***************************************	n ana mananananananananan manananananana
Original Beacon has/has not been destroyed by me.		***************************************	
Original Beacon has/has not been destroyed by me.	-		altodisenakadikullumukhteadamilikkullomiaanami