

GEODEIC SURVEY OF N.S.W.

CENTRAL MAPPING AUTHORITY


GEODEIC STATION RECONNAISSANCE and MAINTENANCE REPORT

STATION: SUTHERLAND (P) No.: 5665

MAP SHEET SCALE 1:250,000 SYDNEY

INSPECTED BY: W.M. GILLIBRAY DATE: 12 8-80


AUTHORITY: C.M.A. FIELD BOOK:

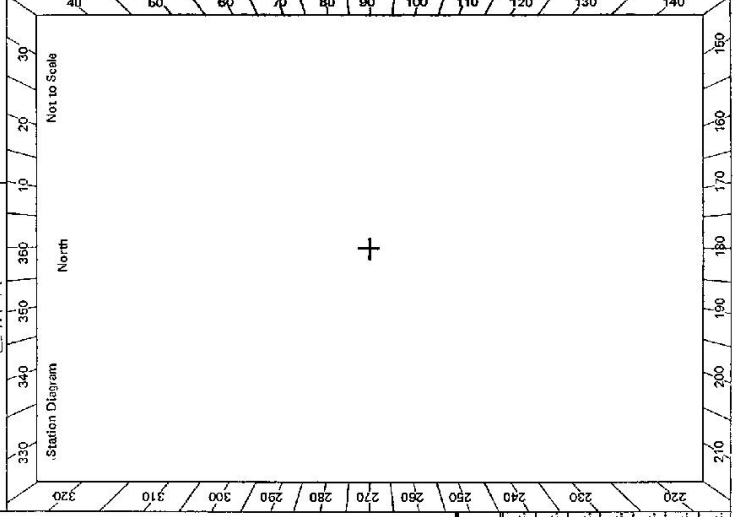

- Description:
1. Cleared by lanes bearing..... from Trig. Mast
2. Mast & Vanes have been painted white & black respectively.
3. The station/pillar was unpiled/not unpiled/constructed on 17.8.80. 19.80. dimensions now being:
 Description of mark **R.T. PILLAR** should be explicit, e.g., S/Steel Pillar Plate, Steel plug, Brass plug, Bolt, G.I. Pipe
 Height of mark **0.267** m. ^{above} ~~below~~ feet/concrete; Mark ism. ^{above} ~~below~~ G.L.
 Height of Top Vanes to Top Mark/Pillar plate **5.08** m. Diameter of Vanes (vertical) **0.600** m.
 Height of Cairn.....m. Diameter of Cairn.....m. Name Plate found/not-found/placed.
 Length of Mast **5.38** m. (approximate if not unpiled)
4. A.....set in conc/rock has been placed/found, bearing.....° M from Mast/Plug/Pillar
5. A.....set in conc/rock has been placed/found, bearing.....° M from Mast/Plug/Pillar
6. A.....set in conc/rock has been placed/found, bearing.....° M from Mast/Plug/Pillar
7. A.....set in conc/rock has been placed/found, bearing.....° M from Mast/Plug/Pillar
8. Action required:.....

STANDPOINT:			
Mark	Direction	Horiz. Distance	Height Difference
			above standpt.
			below standpt.
			above standpt.
			below standpt.
Prepared by: *[Signature]* Checked: *[Signature]* Noted on U.T.M. Card

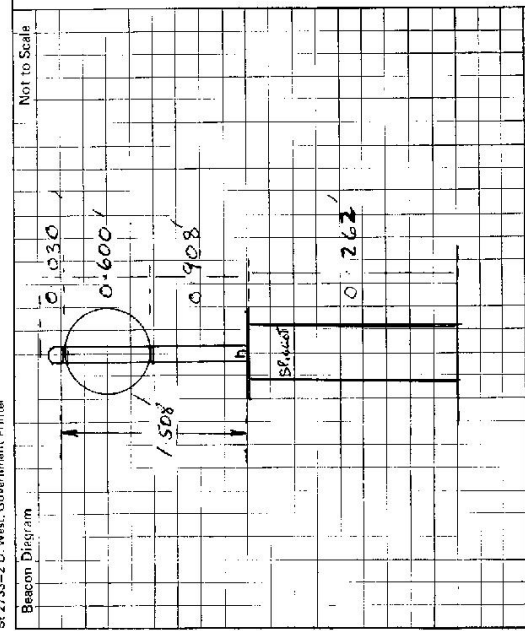STATION SUTHERLAND R.T. PILLAR 5665	Current Occupant: Address: Phone: Owner's Name: SUTHERLAND HOSPITAL Address: Phone: Access Report of:/18.....was found suitable/unsuitable.
Beacon Diagram Not to Scale	
This section to be completed by officer constructing pillar.	
Original station mark found/ not found .	
Description of mark: ROOF TOP PILLAR	
Original beacon found/ not found .	
Description of beacon: ROOF TOP PILLAR SUTHERLAND HOSPITAL	
Height Top of Vanes to Top Mark: 0.908 m.	
Height of mark: 0.262 m. above below G.L.	
Diameter of Vanes: 0.30 m. Height of Callm m.	
Original Beacon has/ has not been destroyed by me.	
Date	Record of Station

STATION 5665 TS SUTHERLAND (P)

Hospital Staff & Patients

Current Occupant

Owners Name: Health Commission


Address: 28 PRESIDENT AVE

Address: 9 YOUNG ST, SYDNEY

CARINGBAH


SYDNEY

Access 17-9-1976

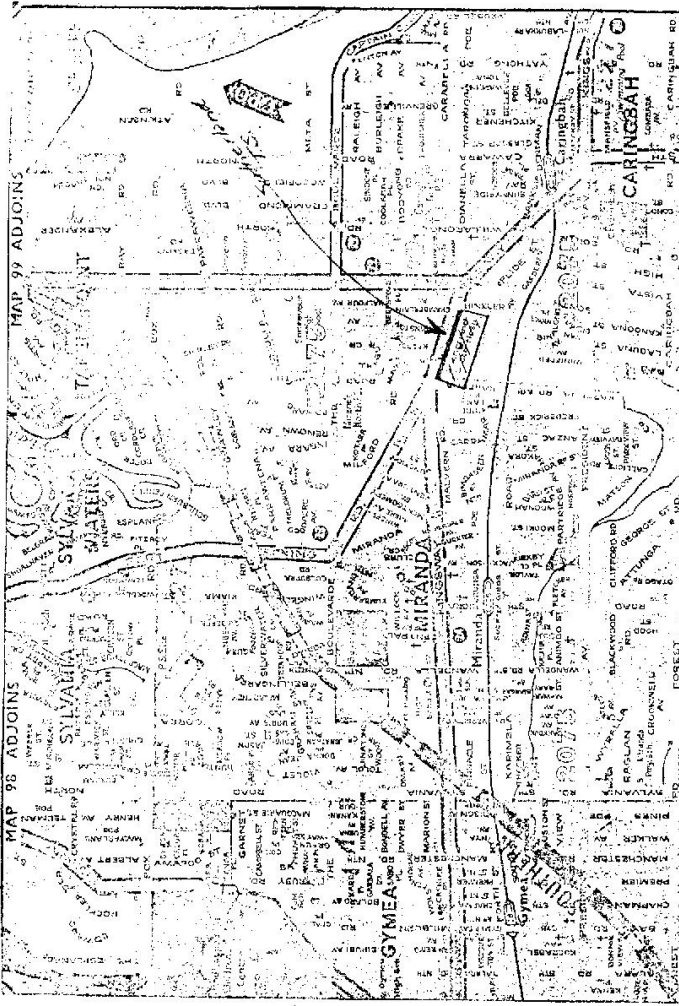

* Contact Hospital Engineer (Janitor) at hospital

Not to Scale

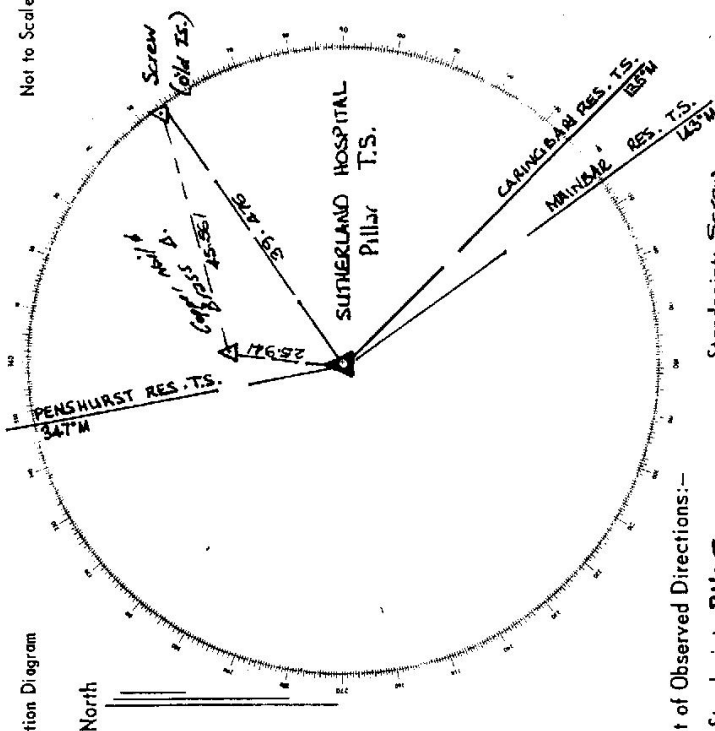

List of Observed Directions:-

Station	Direction	Station	Direction
Mainbar Res TS.	184° 04' 08" S	Mainbar Res TS	173° 05' 29" S
Penshurst Res TS.	351° 55' 50" S	Sutherland TS (Pillar)	241° 00' 00" S
TS (Sutherland PNI)	92° 15' 09" S	B.T.	295° 35' 20" S
TS (CARINGBAH RES)	173° 27' 31" S	Penshurst Res TS.	240° 16' 03" S
B.T.	6° 44' 21" S	Carlingbah Res TS.	152° 54' 36" S

Standpoint: Screw.

Standpoint: Pillar