

CENTRAL MAPPING AUTHORITY
Department of Lands

Trigonometrical Survey of N.S.W.

RECONNAISSANCE and MAINTENANCE REPORT

This Trig. Station has been:-

Note: Cross out word or words which do not apply


1. Completely cleared to permit ~~300~~ vision to surrounding Trigs.
2. Cleared by lanes bearing ~~120~~ ^{40/2} from Trig. Mast
3. Trig. Mast & Vanes have been painted white & black respectively. ✓
4. The Trig. was unpiled/not unpiled, dimensions now being: Original Station Mark found / ~~not found~~

Description of mark: ~~Concrete~~ ^{Obscured} ~~stone~~ ^{rock/concrete} should be explicit, e.g. Steel plug, Brass plug, Bell, G.I. Pipe
 Height of ~~mark~~ ^{stone} m ^{above} / ~~below~~ ^{below} rock/concrete m above / below G.I.
 Height of Top Vanes to Top ~~Mast~~ ^{Stone} m. Diameter of Vanes (vertical) 755 m.
 Height of ~~stone~~ ^{stone} m. Diameter of Cairn m.

- Length of Mast m. (approximate if not unpiled)
5. A. ~~384~~ ³⁸⁴ set in conc/~~rock~~ ^{stone} has been ~~placed~~ ^{placed} 3.294 m. bearing 98° 0M from Trig. Mast
 6. A. ~~600~~ ⁶⁰⁰ set in conc/~~soil~~ ^{stone} has been placed 2.775 m. bearing 40° 0M from Trig. Mast
 7. A. set in conc./soil has been placed m. bearing 0M from Trig. Mast
 8. A. set in conc./rock has been placed m. bearing 0M from Trig. Mast
 9. Connection Trig. Pin to ~~Copper Nail~~ ^{Copper Nail} 2.533 m. bearing 330° 0M
 10. Connection to m. bearing 0M
 11. Connection to m. bearing 0M
 12. Connection to m. bearing 0M
 13. Diff. Ht. ~~Stainless Steel Trig. Ball~~ ^{Stainless Steel Trig. Ball} 1.240 m. ^{above} / ~~below~~ ^{below} ~~stone~~ ^{stone} m. bearing 0M
 14. Diff. Ht. ~~Stone Mast~~ ^{Stone Mast} (above/below) is 1.267 m. ^{above} / ~~below~~ ^{below} ~~stone~~ ^{stone} m. bearing 0M
 15. Diff. Ht. ~~Stainless Steel Trig. Ball~~ ^{Stainless Steel Trig. Ball} is 0.025 m. ^{above} / ~~below~~ ^{below} ~~stone~~ ^{stone} m. bearing 0M
 16. Diff. Ht. is m. ^{above} / ~~below~~ ^{below} ~~stone~~ ^{stone} m. bearing 0M

Prepared by: Checked: Noted on U.T.M. Card

STATION: **KOOLVUNN** T: **5667**
 Co: **Homes** Ph: **6140**
 Map Sheet: **Litter Manual** No: **6140**
 Inspected by: **L. O. Nourse** Date: **26.5.1977**
 Authority: **01390** Field Book: **01390**
 Beacon Diagram: **Not to Scale**

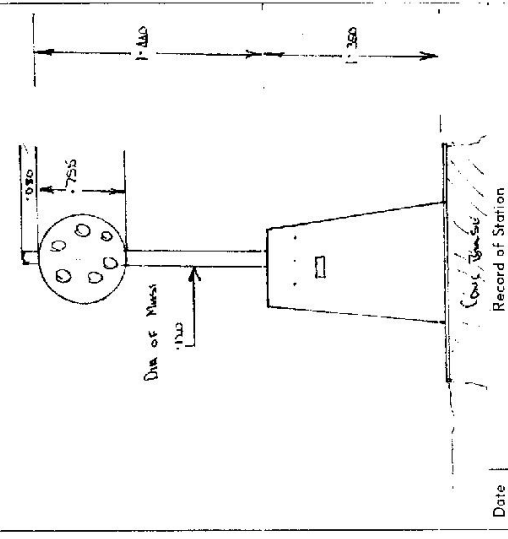

Date: _____

