

7-4-88

CENTRAL MAPPING AUTHORITY
 Department of Lands

Trigonometrical Survey of N.S.W.
 RECONNAISSANCE and MAINTENANCE REPORT

STATION	<u>TRIGONOMETRICAL SURVEY</u>	Ph:	<u>TS 5673</u>
Co:	<u>DMH</u>	No:	<u>8830</u>
Map Sheet:	<u>40/50</u>	Date:	<u>18/10/76</u>
Inspected by:	<u>P. BERTS</u>	Field Book:	<u>01574</u>
Authority:	<u>P.M.A.</u>	Not to Scale	

Bench Diagram

DISTANCE BETWEEN BOTTLE AND STUMP
 ABOUT 5 METRES
 REMAINS OF WOODEN TRIPOD TYPE
 MAST

STUMP

OLD BOTTLE FOUND
 LYING ON GROUND
 NEAR A HOLE

This Trig. Station has been:

Note: Cross out word or words which do not apply

1. Completely cleared to permit 360° vision to surrounding Trigs.
2. Cleared by lanes bearing from Trig. Mast
3. Trig. Mast & Vanes have been painted white & black respectively.
4. The Trig. was unpiled/not unpiled, dimensions now being:

Description of mark: BOTTLE should be explicit, e.g. Steel plug, Brass plug, Bolt, G.I. Pipe

Height of mark: m ^{above} / _{below} rock/concrete m ^{above} / _{below} G.L.

Height of Top Vanes to Top Mark: m. Diameter of Vanes (vertical): m.

Height of Cairn: m. Diameter of Cairn: m.

Length of Mast: m. (approximate if not unpiled)
5. A. set in conc./rock has been placed m. bearing°M from Trig. Mast
6. A. set in conc./soil has been placed m. bearing°M from Trig. Mast
7. A. set in conc./soil has been placed m. bearing°M from Trig. Mast
8. A. set in conc./rock has been placed m. bearing°M from Trig. Mast
9. Connection: to m. bearing°M
10. Connection: to m. bearing°M
11. Connection: to m. bearing°M
12. Connection: to m. bearing°M
13. Diff. Ht. is m. ^{above} / _{below}
14. Diff. Ht. is m. ^{above} / _{below}
15. Diff. Ht. is m. ^{above} / _{below}
16. Diff. Ht. is m. ^{above} / _{below}

Prepared by: _____ Checked: _____

Noted on U.T.M. Card

Date	Record of Station

Checked

CENTRAL MAPPING AUTHORITY
Department of Lands

Trigonometrical Survey of N.S.W.

RECONNAISSANCE and MAINTENANCE REPORT

74-98

STATION TAUNAS IS Phillip Id 5673

Co: ARTHURS Ph: GARLEY

Map Sheet: OBERON No: 8830

Inspected by: P.Potts Date: 21/1/77

Authority: C.M.A. Field Book: DFSB4

Beacon Diagram 1:2500 Nth. to Scale

Note: Cross out word or words which do not apply

This Trig. Station has been:

1. Completely cleared to permit 360° vision to surrounding Trigs.
2. Cleared by lones bearing..... from Trig. Mast
3. Trig. Mast & Vanes have been painted white & black respectively.
4. The Trig. was unpiled/not unpiled, dimensions now being.....

Description of mark. Obsolete OBSOLETE Replaced should be explicit, e.g. Steel plug, Brass plug, Bolt, G.I. Pipe

Height of mark..... m above rock/concrete below G.L. 1.525 m above below G.L.

Height of Top Vanes to Top Mark..... m. Diameter of Vanes (vertical) 0.755 m.

Height of Cairn..... m. Diameter of Cairn..... m.

Length of Mast..... m. (approximate if not unpiled)

5. A. 6.4 set in conc/rock has been placed. 4.72 m. bearing 242°M from Trig. Mast Replaced

6. A. 6.4 set in conc/soil has been placed. 3.045 m. bearing 345°M from Trig. Mast Replaced

7. A..... set in conc/soil has been placed..... m. bearing.....°M from Trig. Mast

8. A..... set in conc/rock has been placed..... m. bearing.....°M from Trig. Mast

9. Connection 6.4 to 6.4 7.257 m. bearing 183°M

10. Connection..... to..... m. bearing.....°M

11. Connection..... to..... m. bearing.....°M

12. Connection..... to..... m. bearing.....°M


13. Diff. Ht. is..... m. above below

14. Diff. Ht. is..... m. above below

15. Diff. Ht. is..... m. above below

16. Diff. Ht. is..... m. above below

Prepared by: P.Potts 29/1/77 Checked: B.Neave field 12/77 Noted on U.T.M. Card

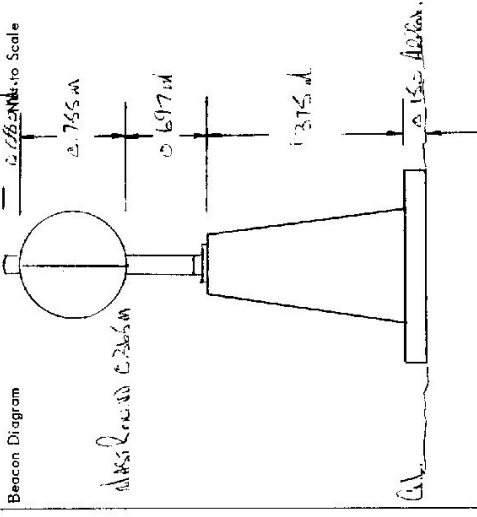

Date	Record of Station
21/1/77	REPLACED OBSOLETE PHILLIP ID

Checked

CENTRAL MAPPING AUTHORITY
Department of Lands

Name Acquired by: C. M. A. Trig. Station No. 5673 (Pillar)

RECONNAISSANCE and MAINTENANCE REPORT

STATION TANNAS 5673 (Pillar)

This Trig. Station has been:-

Note: Cross out word or words which do not apply

1. Completely cleared to permit 360° vision to surrounding triggs.

2. Cleared by lanes bearing..... from Trig. Mast

3. Trig. Mast & Vanes have been painted white & black respectively. ✓

4. The Trig. was unpiled/~~not unpiled~~, dimensions now being:

Description of mark 5/5 Pillar Plate should be explicit, e.g. Steel plug, Brass plug, Bolt, G.L. Pipe

Height of mark..... m above rock/concrete..... m above G.L.

Height of Top Vanes to Top Mark 1.455 m. Diameter of Vanes (vertical) 0.75 m.

Height of Cairn..... m. Diameter of Cairn..... m.

Length of Mast..... m. (approximate if not unpiled)

5. A Cu. Nail set in conc./~~rock~~ has been placed 4.460 m. bearing 45 °M from Trig. Mast Pillar

6. A G.L. Pipe set in conc./~~soil~~ has been placed 3.038 m. bearing 176 °M from Trig. Mast Pillar

7. A..... set in conc./soil has been placed..... m. bearing..... °M from Trig. Mast

8. A..... set in conc./rock has been placed..... m. bearing..... °M from Trig. Mast

9. Connection Cu. Nail to G.L. Pipe: 7.256 m. bearing 213 °M

10. Connection..... to..... m. bearing..... °M

11. Connection..... to..... m. bearing..... °M

12. Connection..... to..... m. bearing..... °M

13. Diff. Ht. Cu. Nail is 1.578 m. ~~above~~ Pillar Plate

14. Diff. Ht. G.L. Pipe is 1.444 m. ~~above~~ Pillar Plate

15. Diff. Ht. is..... m. ~~above~~.....


16. Diff. Ht. is..... m. ~~above~~.....

Prepared by: A. Silvertsen 10.2.77 Checked:.....

Noted on U.T.M. Card

Co: BATHURST Ph: OKLEY
Map Sheet: OBBERON No: 8830
Inspected by: A. Silvertsen Date: 10 Feb 1977
Authority: C.M.A. Field Book: 1546

Beacon Diagram

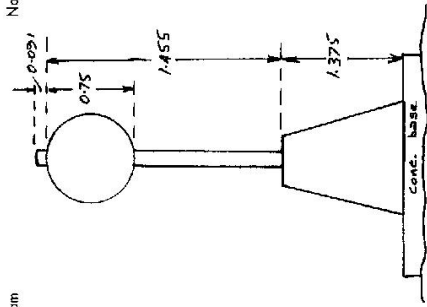


Date 2/1/77 Record of Station Conc. Pillar established.

Checked

STATION **TANNAS** **GS (Pillar)** TS 5673

Owners Name.....
 Current Occupant.....
 Address.....
 Address.....
 Access.....

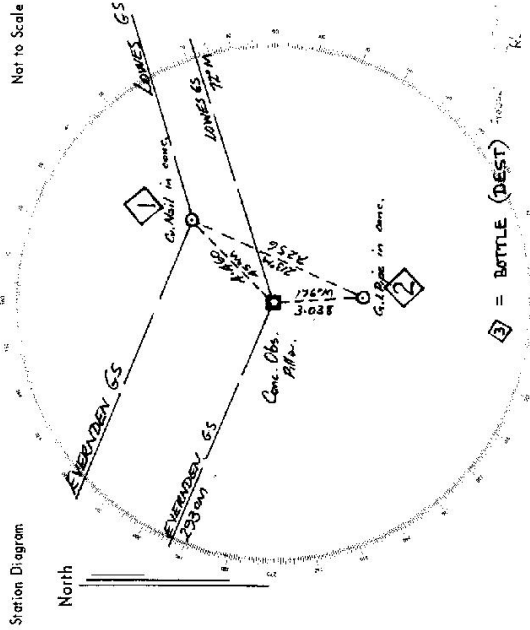

List of Observed Directions:-

Station	Direction	Station	Direction
Evereden GS (Pillar)	0 00 00	Evereden GS (Pillar)	0 00 00
C. Mail in conc.	82 17	Lewis GS (Pillar)	139 03 16
Lewis GS (Pillar)	139 03 16	G.I. Pipe in conc.	230 09
G.I. Pipe in conc.	232 10	Cone. OP	282 17

Station	Direction	Station	Direction

Standpoint: Conc. Pillar Standpoint: Cu. Nail in conc.

