

CENTRAL MAPPING AUTHORITY
Department of Lands

Trigonometrical Survey of N.S.W.

RECONNAISSANCE and MAINTENANCE REPORT

This Trig. Station has been:-

Note: Cross out word or words which do not apply

1. Completely cleared to permit 360° vision to surrounding Trigs.
2. Cleared by lanes bearing S 56 27° E from Trig. Mast
3. Trig. Mast & Vanes have been painted white & black respectively.
4. The Trig. was unpiled/not unpiled, dimensions now being:

Description of mark BOTTLE NECK IN CONCRETE should be explicitly, e.g. Steel plug, Brass plug, Bolt, G.I. Pipe

Height of mark CONCRETE LEVEL m above rock/concrete m below G.L.

Height of Top Vanes to Top Mark..... m. Diameter of Vanes (vertical)..... m.

Height of Cairn..... m. Diameter of Cairn..... m.

Length of Mast..... m. (approximate if not unpiled)

5. A..... set in conc/rock has been placed..... m. bearing.....°M from Trig. Mast
6. A..... set in conc/soil has been placed..... m. bearing.....°M from Trig. Mast
7. A..... set in conc/soil has been placed..... m. bearing.....°M from Trig. Mast
8. A..... set in conc/rock has been placed..... m. bearing.....°M from Trig. Mast

9. Connection..... to..... m. bearing.....°M

10. Connection..... to..... m. bearing.....°M

11. Connection..... to..... m. bearing.....°M

12. Connection..... to..... m. bearing.....°M

13. Diff. Ht. is..... m. ^{above} below

14. Diff. Ht. is..... m. ^{above} below

15. Diff. Ht. is..... m. ^{above} below

16. Diff. Ht. is..... m. ^{above} below

Prepared by:

Checked:

Noted on U.T.M. Card

STATION WINDY CORNELL TS 5674
Co: WESTMORELAND Ph: LINDDALE

Map Sheet: 4820/24 No: SX 233
Inspected by: P. BATES Date: 11/1/76
Authority: P.M.A. Field Book: 151575

Beacon Diagram Not to Scale



BOTTLE NECK IN CONCRETE. A
ON BUSHHILL - TREES ON ANOTHER
TRUCK IN 270 to S

Date	Record of Station

Checked

74-98

Trigonometrical Survey of N.S.W.

CENTRAL MAPPING AUTHORITY

Department of Lands

RECONNAISSANCE and MAINTENANCE REPORT

STATION WINDY CORNER OS. PILLAR TS 5674

Co: WESMORLELAND Ph: LANARSALE
 Map Sheet: OBERON No: 8830
 Inspected by: P. ROSS Date: 22/1/77
 Authority: C.M.A. Field Book: Δ1534

This Trig. Station has been:-

Note: Cross out word or words which do not apply

1. Completely cleared to permit 360° vision to surrounding Trigs.
2. Cleared by lanes bearing..... from Trig. Mast
3. Trig. Mast & Vanes have been painted white & black respectively.
4. The Trig. was unpiled/not unpiled, dimensions now being: Original Station Mark found / ~~found~~

Description of mark: CONCRETE BASELINE PILLAR should be explicit, e.g. Steel plug, Brass plug, Bolt, G.I. Pipe
 Height of mark: 1.375 m above ~~rock~~ concrete 1.525 m above ~~below~~ G.L.

Height of Top Vanes to Top Mark..... m. Diameter of Vanes (vertical) Δ.755 m.

Height of Cairn..... m. Diameter of Cairn..... m.

Length of Mast..... m. (approximate if not unpiled)

5. A. C.M. set in conc/~~rock~~ has been placed. 3.12 m. bearing 312 °M from Trig. Mast Pillar

6. ROCK set in conc/~~soil~~ has been placed. 2.265 m. bearing 3A °M from Trig. Mast Pillar

7. A..... set in conc/~~soil~~ has been placed..... m. bearing..... °M from Trig. Mast

8. A..... set in conc/~~rock~~ has been placed..... m. bearing..... °M from Trig. Mast

9. Connection C.M. to ROCK 3.607 m. bearing 270 °M

10. Connection..... to..... m. bearing..... °M

11. Connection..... to..... m. bearing..... °M


12. Connection..... to..... m. bearing..... °M

13. Diff. Ht. is..... m. above below

14. Diff. Ht. is..... m. above below

15. Diff. Ht. is..... m. above below

16. Diff. Ht. is..... m. above below

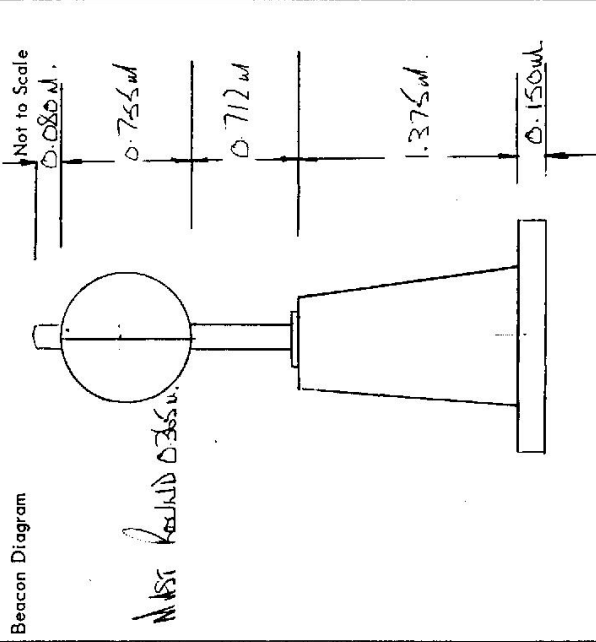

Date	Record of Station
21/1/77	CONCRETE PILLAR PLACED.


Prepared by: P. ROSS 29/1/77. Checked: P. ROSS 1/2/77. Noted on U.T.M. Card

Checked

STATION WINDY CORNER CS PILLAR IS 5674

Owners Name: Mr. T. HALLSLOW.
 Address: WALLEY DOWNS.
 Current Occupant: THE LAGOON PHONE LAGOON I. CONTACT MANAGER MR. P. SHAW.
 Address:

Access 22/1/1977
 VICES
 0.00 LAGOON P.D. HEADING TOWARDS BURHURST.
 0.80 TURN RIGHT SIGN O'CONNELL 13 KM.
 1.30 CROSS CONCRETE BRIDGE
 4.20 TURN LEFT OFF SEALED ROAD.
 4.24 IRON GATE FROM HERE MAKE OWN WAY.
 TO STATION AT TOP OF RIDGE
 4.36 GEOMETRIC STATION WINDY CORNER.

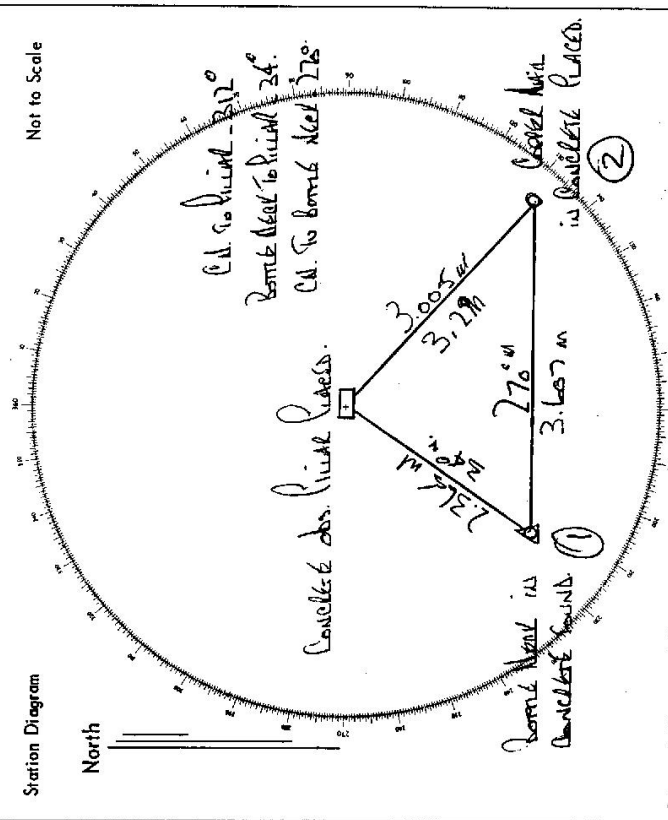

List of Observed Directions:-

Standpoint:		Standpoint:	
Station	Direction	Station	Direction
Station	Direction	Station	Direction