

CENTRAL MAPPING AUTHORITY
Department of Lands

Trigonometrical Survey of N.S.W.
RECONNAISSANCE and MAINTENANCE REPORT

This Trig. Station has been:-

Note: Cross out word or words which do not apply

1. Completely cleared to permit 360° vision to surrounding Trigs.
2. Cleared by lanes bearing Black Hill from Trig. Mast
3. Trig. Mast & Vanes have been painted white & black respectively.
4. The Trig. was unpiled/not unpiled, dimensions now being:

Description of mark..... should be explicitly e.g. Steel plug, Brass plug, Ball, G.I. Pipe
 Height of mark..... m above rock/concrete m below G.L.
 Height of Top Vanes to Top Mark..... m. Diameter of Vanes (vertical) 0.755 m.
 Height of Cairn 2.62 m. Diameter of Cairn 2.62 m.

- Length of Mast..... m. (approximate if not unpiled)
5. A..... set in conc/rock has been placed..... m. bearing.....°M from Trig. Mast
 6. A..... set in conc/soil has been placed..... m. bearing.....°M from Trig. Mast
 7. A..... set in conc/soil has been placed..... m. bearing.....°M from Trig. Mast
 8. A..... set in conc/rock has been placed..... m. bearing.....°M from Trig. Mast

9. Connection..... to..... m. bearing.....°M
10. Connection..... to..... m. bearing.....°M
11. Connection..... to..... m. bearing.....°M
12. Connection..... to..... m. bearing.....°M
13. Diff. Ht. is..... m. ^{above}/_{below}
14. Diff. Ht. is..... m. ^{above}/_{below}
15. Diff. Ht. is..... m. ^{above}/_{below}
16. Diff. Ht. is..... m. ^{above}/_{below}

Prepared by: Checked: Noted on U.T.M. Card

STATION MacKILDA C's TS 5675
 Co: BARNES Ph: THREE BROTHERS
 Map Sheet: BLAYNEY No: 8730
 Inspected by: P POTTS Date: 20/10/76
 Authority: C.M.A. Field Book: 01515

Beacon Diagram
 Not to Scale
MKS & VANES BRASS LUG
ON GROUND - WIREST HWT
TOPS AND BAKEN SURTIN

Date

Record of Station

Checked

CENTRAL MAPPING AUTHORITY
Department of Lands

Trigonometrical Survey of N.S.W.

RECONNAISSANCE and MAINTENANCE REPORT

This Trig. Station has been:-

Note: Cross out word or words which do not apply

1. Completely cleared to permit 360° vision to surrounding Trigs.
2. Cleared by lanes bearing..... from Trig. Mast
3. Trig. Mast & Vanes have been painted white & black respectively.
4. The Trig. was unpiled/not unpiled, dimensions now being: **Original Station Mark bearing, ~~unpiled~~**
Description of mark: **Concrete obelisk** should be explicit, e.g. Steel plug, Brass plug, Belt, G.I. Pipe

Height of mark..... 1.370 m above rock/concrete 1.570 m above G.L.
 Height of Top Vanes to Top Mark..... m Diameter of Vanes (vertical) 0.755 m.
 Height of Cairn..... m Diameter of Cairn..... m.
 Length of Mast..... m. (approximate if not unpiled)

5. A 1.1.9 set in conc/rock has been placed 3.025 m. bearing 76 °M from Trig. Mast PILLAR
6. A 1.1.9 set in conc/soil has been placed 4.413 m. bearing 321 °M from Trig. Mast PILLAR
7. A..... set in conc/soil has been placed..... m. bearing..... °M from Trig. Mast
8. A..... set in conc/rock has been placed..... m. bearing..... °M from Trig. Mast

9. Connection 1.1.9 to 1.1.9: 3.475 m. bearing 95 °M
10. Connection..... to.....:..... m. bearing..... °M
11. Connection..... to.....:..... m. bearing..... °M
12. Connection..... to.....:..... m. bearing..... °M
13. Diff. Ht. is..... m. above below
14. Diff. Ht. is..... m. above below
15. Diff. Ht. is..... m. above below
16. Diff. Ht. is..... m. above below

Prepared by: P. Leath 29/1/17. Checked: P. Leath 12/1/17. Noted on U.T.M. Card

7499


STATION Nova Rilda G.S. Pillar TS 5675

Co: BATHURST Ph: ARBE BENTERS

Map Sheet: 8730 No: 8730

Inspected by: P. Leath Date: 29/1/17

Authority: C.M.A. Field Book: 01534

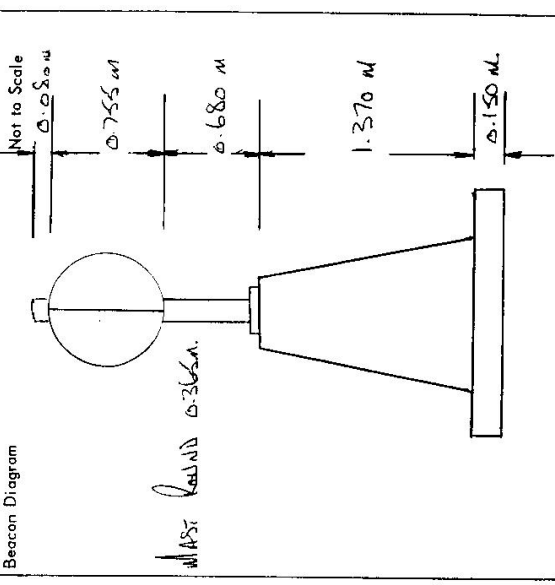

Date	Record of Station
29/1/17	Concrete Pillar Pilled.

Checked

CENTRAL MAPPING AUTHORITY

GEODETIC SURVEY OF N.S.W.

GEODETIC STATION RECONNAISSANCE and MAINTENANCE REPORT

Description:

Note: Cross out word or words which do not apply

1. Cleared by lances bearing..... from Trig. Mast
2. Mast & Vanes have been painted white & black respectively.
3. The station/pillar was unpiled/not unpiled/constructed on..... 19....., dimensions now being:
Description of mark..... should be explicit, e.g., S/Steel Pillar Plate, Steel plug, Brass plug, Bolt, G.I. Pipe
Height of mark.....m. above below rock/concrete; Mark is.....m. above below G.L.
- Height of Top Vanes to Top Mark/Pillar plate.....m. Diameter of Vanes (vertical).....m.
- Height of Cairn.....m. Diameter of Cairn.....m. Name Plate found/not found/placed.
- Length of Mast.....m. (approximate if not unpiled)
4. A..... set in conc/rock has been placed/found, bearing..... from Mast/Plug/Pillar
5. A..... set in conc/rock has been placed/found, bearing..... from Mast/Plug/Pillar
6. A..... set in conc/rock has been placed/found, bearing..... from Mast/Plug/Pillar
7. A..... set in conc/rock has been placed/found, bearing..... from Mast/Plug/Pillar
8. Action required:.....

NEW MAST

STANDPOINT:		STANDPOINT:		STANDPOINT:	
Mark	Direction	Horiz. Distance	Height Difference	Mark	Direction
			above standpt.		
			below standpt.		
			above standpt.		
			below standpt.		
Prepared by: *Piers* 24.3.83 Checked: *Piers* 24.3.83 Noted on U.T.M. Card

S: 2733-1

STATION: *MORILDA G.S.(P)* No: *5675*
 MAP SHEET SCALE 1:250 000
 INSPECTED BY: *Piers* DATE: *16.3.83*
 AUTHORITY: *C.M.A.* FIELD BOOK: *1941*

St. 2739 - 2 D. West, Government Printer	STATION <u>MOEILDA BLD TS 5675</u>	Owner's Name: Address: Phone: Current Occupant: Address: Phone: ACCESS Access Report of/19..... was found suitable/unsuitable.
Beacon Diagram Not to Scale 		Date Record of Station
This section to be completed by officer constructing pillar. Original station mark found/not found. Description of mark: Original beacon found/not found. Description of beacon: Height Top of Vanes to Top Mark:m. Height of mark:m. above G.L. below rock/concm. below Diameter of Vanesm. Height of Cairnm. Original Beacon has/has not been destroyed by me.		