

CENTRAL MAPPING AUTHORITY


GEODETIC SURVEY OF A.S.I.W.
 GEODETIC STATION RECONNAISSANCE and MAINTENANCE REPORT

STATION: SMA 0925 No.: 568

MAP SHEET SCALE 1:250 000 BEGA

INSPECTED BY: G. KEEP. DATE: 17/3/80

AUTHORITY: FIELD BOOK:

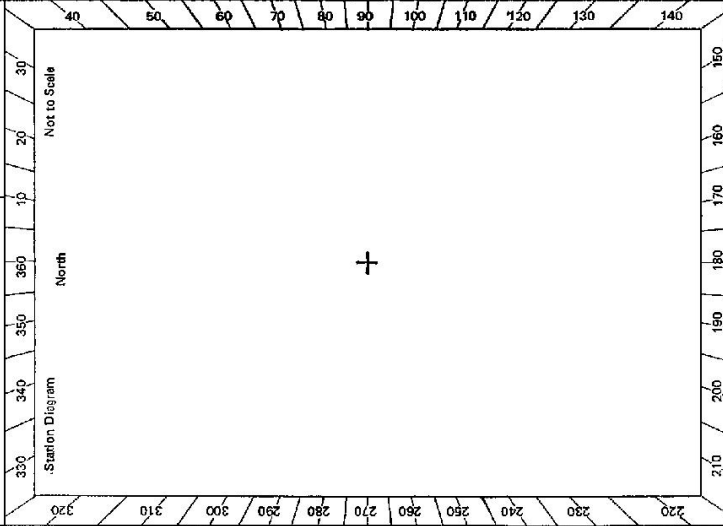

- Description:
1. Cleared by lanes bearing.....
 Note: Cross out word or words which do not apply
2. ~~Mast & Vanes have been painted white & black respectively.~~
3. The station/pillar was unpiled/not unpiled/constructed on..... 19....., dimensions now being:
 Description of mark..... should be explicit, e.g., S/Steel Pillar Plate, Steel plug, Brass plug, Bolt, G.I. Pipe
 Height of mark.....^{above} rock/concrete; Mark is.....^{above}.....^{below} G.L.
 Height of Top Vanes to Top Mark/Pillar plate.....m. Diameter of Vanes (vertical).....m.
 Height of Cairn.....m. Diameter of Cairn.....m. Name Plate found/not found/placed.
 Length of Mast.....m. (approximate if not unpiled)
4. A..... set in conc/rock has been placed/found, bearing.....° M from Mast/Plug/Pillar
5. A..... set in conc/rock has been placed/found, bearing.....° M from Mast/Plug/Pillar
6. A..... set in conc/rock has been placed/found, bearing.....° M from Mast/Plug/Pillar
7. A..... set in conc/rock has been placed/found, bearing.....° M from Mast/Plug/Pillar
8. Action required: New beacon required.

STANDPOINT:			
Mark	Direction	Horiz. Distance	Height Difference
			above standpt.
			below standpt.
			above standpt.
			below standpt.
Prepared by: G. Keep 24/7/80 Checked: Noted on U.T.M. Card

