

GEODETIC SURVEY OF N.S.W.

CENTRAL MAPPING AUTHORITY


GEODETIC STATION RECONNAISSANCE and MAINTENANCE REPORT

STATION: SMA 0927 No.: 570

MAP SHEET SCALE 1:250 000 BEGA

INSPECTED BY: G. KEEP DATE: 17/3/80

AUTHORITY: FIELD BOOK:

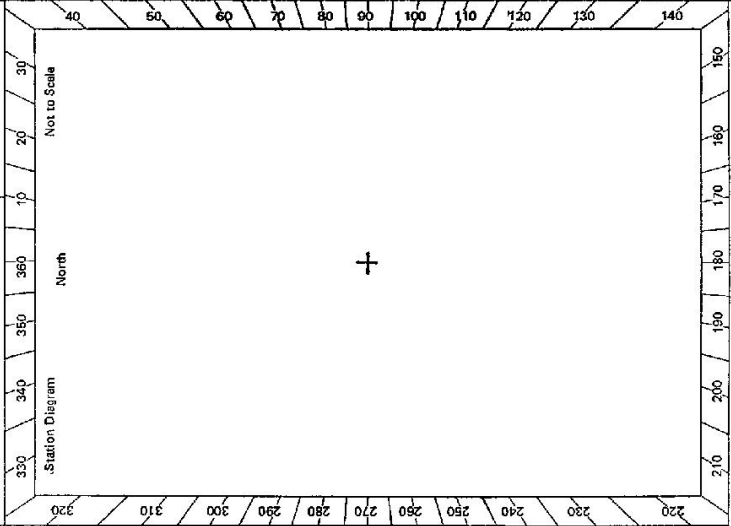

- Description:**
- Cleared by lanes bearing.....  
*Note: Cross out word or words which do not apply*
  - ~~Mast & Vanes have been painted white & black respectively.~~
  - The station/pillar was unpiled/not unpiled/constructed on.....19....., dimensions now being:  
Description of mark.....should be explicit, e.g., S/Steel Pillar Plate, Steel plug, Brass plug, Bolt, G.I. Pipe  
Height of mark.....m. <sup>above</sup> rock/concrete; Mark is.....m. <sup>above</sup> G.L.  
Height of Top Vanes to Top Mark/Pillar plate.....m. Diameter of Vanes (vertical).....m.  
Height of Cairn.....m. Diameter of Cairn.....m. Name Plate found/not found/placed,  
Length of Mast.....m. (approximate if not unpiled)
  - A.....set in conc/rock has been placed/found, bearing.....° M from Mast/Plug/Pillar
  - A.....set in conc/rock has been placed/found, bearing.....° M from Mast/Plug/Pillar
  - A.....set in conc/rock has been placed/found, bearing.....° M from Mast/Plug/Pillar
  - A.....set in conc/rock has been placed/found, bearing.....° M from Mast/Plug/Pillar
  - Action required: *Needs painting black and white, major clearing of trees for all round visibility*

STANDPOINT:			
Mark	Direction	Horiz. Distance	Height Difference
			above standpt.
			below standpt.
			above standpt.
			below standpt.
Prepared by: *G. Keep 24/7/80* Checked: *Checked* Noted on U.T.M. Card

