

CENTRAL MAPPING AUTHORITY
Department of Lands

Trigonometrical Survey of N.S.W.

RECONNAISSANCE and MAINTENANCE REPORT

This Trig. Station has been:-

Note: Cross out word or words which do not apply

1. Completely cleared to permit 360° vision to surrounding Trigs. ✓
2. Cleared by lances bearing lances only from Trig. Mast
3. Trig. Mast & Vanes have been painted white & black respectively. ✓
4. The Trig. was unpiled/~~not unpiled~~, dimensions now being: Original Station Mark found / ~~not found~~

Description of mark. Rock Trig. Observation Pillar should be explicit, e.g. Steel plug, Brass plug, Bell, G.I. Pipe

Height of mark 1.255 m above rock/concrete 0.255 m below G.L.

Height of Top Vanes to Top Mark 1.440 m. Diameter of Vanes (vertical) 0.760 m.

Height of Cap 0.015 m. Diameter of Cap 0.015 m.

Length of Mast 0.015 m. (approximate if not unpiled)

5. A Brass Trig. Slat set in conc./~~soil~~ has been placed 4.537 m. bearing 230° from Trig. Mast

6. A Green Glass set in conc./~~soil~~ has been placed 3.527 m. bearing 190° from Trig. Mast

7. A Green Glass set in conc./soil has been placed 0.000 m. bearing 0° from Trig. Mast

8. A Green Glass set in conc./rock has been placed 0.000 m. bearing 0° from Trig. Mast

9. Connection Trig. Base to Green Glass : 2.742 m. bearing 352° 0M

10. Connection to to to m. bearing 0°

11. Connection to to to m. bearing 0°

12. Connection to to to m. bearing 0°

13. Diff. Ht. Brass Trig. Slat to to to m. above below Trig. Mast

14. Diff. Ht. Green Glass to to to m. above below Trig. Mast

15. Diff. Ht. Green Glass to to to m. above below Trig. Mast

16. Diff. Ht. to to to m. above below Trig. Mast

Prepared by:

Checked:

Noted on U.T.M. Card

Checked

STATION COOPERATIVE IS 5811

Co: Hawkes Ph: MUNNEL

Map Sheet: WEST MOUNTAIN

Inspected by: L.L. HULLUS

Authority


No: 9236

Date: 5 APRIL 1977

Field Book: 61540

Beacon Diagram

Not to Scale

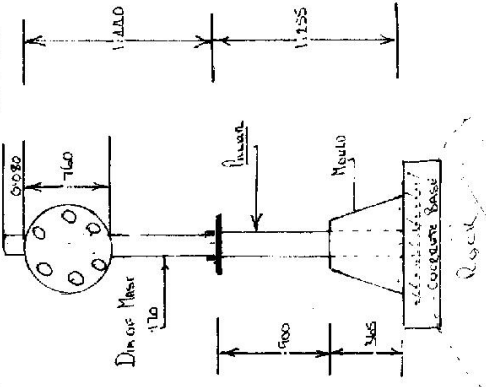

Date

Record of Station

STATION COOPACUQUARA 75-5811

Owners Name Mr. Jee. Linares Current Occupant

Address Coopacucurara Station Address

Coopacucurara


Access 5-4-1977

KILOMETERS FOOTING

- 0.00 COOPACUCURARA PUBLIC SCHOOL TERMINAL TOUWANA HOUNBOC /
- 2.30 GRAD /
- 3.10 CONCRETE CONCRETEWAY
- 5.10 TOWER LIGHT BEYOND GRAD AND RAILWAY FENCE FROM HERE COOPACUCURARA /
- 7.60 HOUNBOC CAN BE SEEN ABT 1/4th MILE AND LEFT
- 9.40 WIDE GRASS
- 9.40 TAKE LEFT HAND TURN /
- 9.45 LOT DUMP
- 9.60 GRASSY COUNTRY
- 10.00 LEAVE VEHICLE AND WALK UPWARDS TO OTHER STATION /

INFORMATION ON OLD STATION

- DIRECTION OF WIND 100
- TOP WINDS TO BOTTOM WIND 500 /
- HIGH 5000
- HEIGHT OF WIND 100
- WIND 500
- HEIGHT OF WIND 1400
- DIA OF WIND 2.000

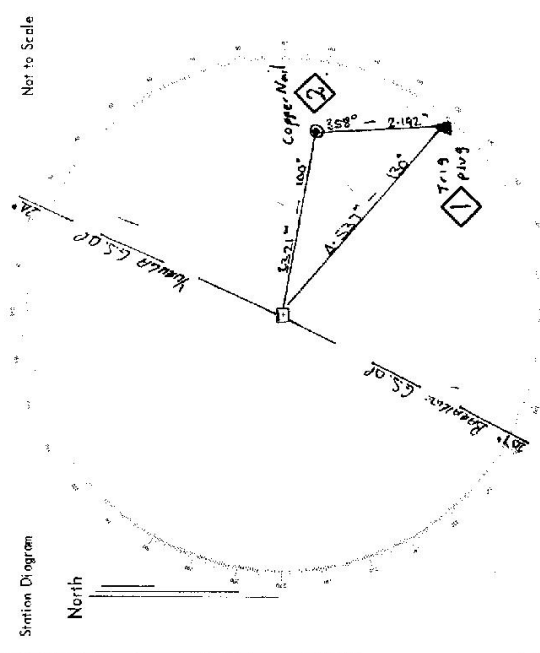

List of Observed Directions:-

Station	Direction	Station	Direction
Brewster 65.00	0 00 00	Brewster 65.00	0 00 00
Yonkers 65.00	181 05 20	Alton Sugar	106 03 20
Genesee Hill (West)	174 04 10	Copper Hill - Hill (West)	100 02 50
Genesee Hill (East)	176 17 50	Yonkers 65.00	171 00 00

Station	Direction	Station	Direction

Standpoint: See Top Observed Point Standpoint: Genesee Hill