

CENTRAL MAPPING AUTHORITY

GEODETTIC SURVEY OF N.S.W.

GEODETTIC STATION RECONNAISSANCE and MAINTENANCE REPORT

STATION: **YUWUGA (P)** No.: **5812**

MAP SHEET SCALE 1:250 000
INSPECTED BY: **G. Jones** DATE: **16/6/81**

AUTHORITY: **CMA** FIELD BOOK: **1915**

Description:
1. Cleared by lanes bearing..... *See Diagram*..... from Trig. Mast

2. Mast & Vanes have been painted white & black respectively.
3. The station/pillar was unpiled/not unpiled/constructed on.....19....., dimensions now being:

Description of mark **5/5 P/PLATE**.....should be explicit, e.g., S/Steel Pillar Plate, Steel plug, Brass plug, Bolt, G.I. Pipe

Height of mark.....m. above below rock/concrete; Mark is.....m. above below G.L.

Height of Top Vanes to Top Mark/Pillar plate.....m. Diameter of Vanes (vertical).....m.

Height of Cairn.....m. Diameter of Cairn.....m. Name Plate found/not found/placed.

Length of Mast.....m. (approximate if not unpiled)


4. A.....set in conc/rock has been placed/found, bearing.....°M from Mast/Plug/Pillar

5. A.....set in conc/rock has been placed/found, bearing.....°M from Mast/Plug/Pillar

6. A.....set in conc/rock has been placed/found, bearing.....°M from Mast/Plug/Pillar

7. A.....set in conc/rock has been placed/found, bearing.....°M from Mast/Plug/Pillar

8. Action required:.....

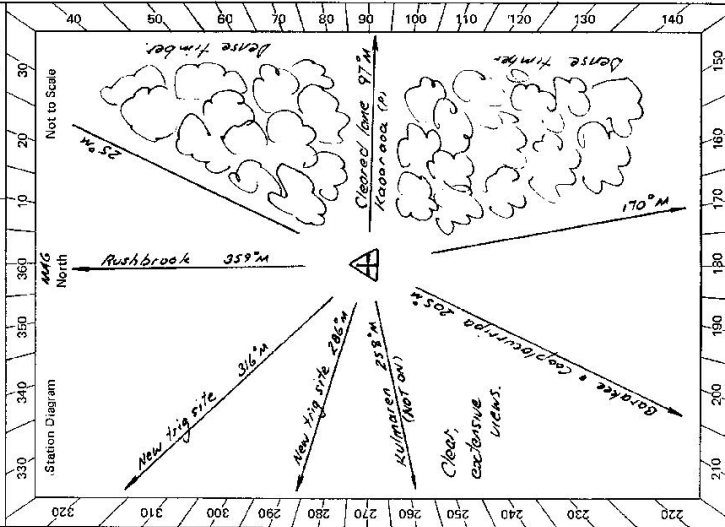

STANDPOINT:		STANDPOINT:	
Mark	Direction	Horiz. Distance	Height Difference
			above standpt.
			below
			above standpt.
			below
Prepared by: *[Signature]* 30/6/81 Checked: *[Signature]*

SI 2733-2 D. West, Government Printer

STATION **YURUGA (P) TS 5812**

Beacon Diagram	Not to Scale
<p><i>Concrete pillar, mast and cross found in good condition.</i></p>	

Owner's Name:
 Address:
 Phone:

Current Occupant:
 Address:
 Phone:

ACCESS

Access Report of 13/2/1971 was found suitable/unavailable, some changes

0-0 **YARONWICH HILL AND SHOWGROUND, TRAVEL SOUTH.**
 (98 km FROM WALCHA . JUST OFF OXLEY HIGHWAY.)

10-0 **GRAD AND PASSING FORESTRY CAMP ON LEFT.**

10-9 **TURN RIGHT AT "ENFIELD FOREST ROAD"**

15-7 **PASS ROAD ON RIGHT TO PORTERS GS.**

18-2 **PASS DICKS HUT FIRE TRAIL ON RIGHT.**

32-6 **PASS GRANT TRAIL ON RIGHT.**

CROSS GRIDS AT : 32.35 , 34.5 , 37.35 , 39.35 , 40.6 .

42-4 **GRAD , AND TURN SHARP LEFT ALONG TRACK UP HILL**

44-3 **YURUGA (P) .**

4WD ALL WEATHER ACCESS.

This section to be completed by officer constructing pillar.

Original station mark found/not found.

Description of mark:

Original beacon found/not found.

Description of beacon:

Height Top of Vanes to Top Markm.

Height of mark.....m. above rock/conc.....m. below G.L.

Diameter of Vanesm. Height of Cairnm.

Original Beacon has/has not been destroyed by me.

Date	Record of Station