

CENTRAL MAPPING AUTHORITY  
Department of Lands

Trigonometrical Survey of N.S.W.

RECONNAISSANCE and MAINTENANCE REPORT

This Trig. Station has been:

Note: Cross out word or words which do not apply

1. Completely cleared to permit 360° vision to surrounding Triang.
2. Cleared by lanes bearing 29° 45' 50" + 238° 6' 28" + 202° 24' 11" from Trig. Mast
3. Trig. Mast & Vanes have been painted white & black respectively. ✓
4. The Trig. was unpiled/~~not unpiled~~, dimensions now being:

Description of mark..... should be explicit, e.g. Steel plug, Brass plug, Batr, G.I. Pipe

Height of mark..... m above rock/concrete ..... m above G.L.

Height of Top Vanes to Top Mark..... m Diameter of Vanes (vertical)..... m.

Height of Cairn..... m. Diameter of Cairn 2.15 m.

Length of Mast 2.7 m. (approximate if not unpiled)

5. A.I.P. set in conc./rock has been placed..... m. bearing.....°M from Trig. Mast

6. A.I.P. set in conc./soil has been placed..... m. bearing.....°M from Trig. Mast

7. A..... set in conc./soil has been placed..... m. bearing.....°M from Trig. Mast

8. A..... set in conc./rock has been placed..... m. bearing.....°M from Trig. Mast

9. Connection..... to..... m. bearing.....°M

10. Connection..... to..... m. bearing.....°M

11. Connection..... to..... m. bearing.....°M

12. Connection..... to..... m. bearing.....°M

13. Diff. Ht. .... is..... m. above below

14. Diff. Ht. .... is..... m. above below

15. Diff. Ht. .... is..... m. above below

16. Diff. Ht. .... is..... m. above below

Prepared by:

Checked:

Noted on U.T.M. Card

2-4-88

STATION METHUEN I.S. TS 5817


Co. R. BULLOCK PH: METHUEN

Map Sheet: BANLUKE No: 8821

Inspected by: P. POTTS Date: 15/10/76

Authority: C.M.A. Field Book: 61/15

Beacon Diagram

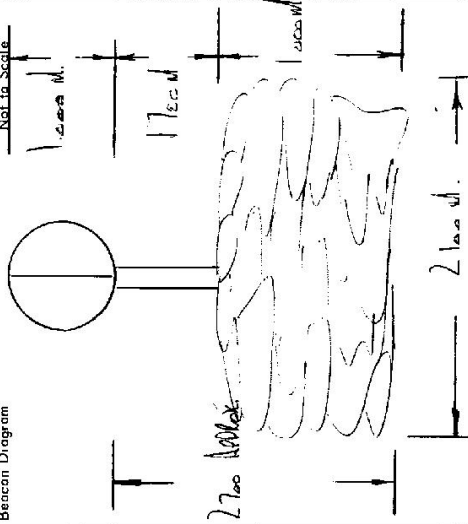

Date	Record of Station

Checked



CENTRAL MAPPING AUTHORITY  
Department of Lands

Trigonometrical Survey of N.S.W.


RECONNAISSANCE and MAINTENANCE REPORT

This Trig. Station has been:-

Note: Cross out word or words which do not apply


1. Completely cleared to permit 360° vision to surrounding Trig.
  2. Cleared by lances bearing 108° to 322 to 279, 168° to 175° back to 102° from Trig. Mast. *Approximate only.*
  3. Trig. Mast & Vanes have been painted white & black respectively. ✓
  4. The Trig. was unpiled/not unpiled, dimensions now being: *Original height Mast found ~~not found~~*  
Description of mark: *Concrete block with black* should be explicit, e.g. Steel plug, Brass plug, Bolt, G.I. Pipe
- Height of mark: 1.375 m above ~~below~~ *each* concrete *each* G.L. *1.525 m above G.L.*
- Height of Top Vanes to Top Mark: ..... m. Diameter of Vanes (vertical): 752 ..... m.
- Height of Cairn: ..... m. Diameter of Cairn: ..... m.
- Length of Mast: ..... m. (approximate if not unpiled)

5. *Found* ~~Found~~ in conc/rock has been placed 3.531 m, bearing 295° from Trig. Mast *found*
6. A.C.I.P. set in conc/soil has been placed 2.505 m, bearing 238° from Trig. Mast *found*
7. A.C.I.P. set in conc/soil has been placed 5.822 m, bearing 283° from Trig. Mast *found*
8. A. set in conc/rock has been placed ..... m, bearing .....° from Trig. Mast *NEAR SURFACE*
9. Connection: to ..... m, bearing .....°M
10. Connection: to ..... m, bearing .....°M
11. Connection: to ..... m, bearing .....°M
12. Connection: to ..... m, bearing .....°M
13. Diff. Ht. *found* ~~found~~ *is* 3.666 m *above* ~~below~~ *Trig. Mast*
14. Diff. Ht. *found* ~~found~~ *is* 1.465 m *above* ~~below~~ *Trig. Mast*
15. Diff. Ht. *found* ~~found~~ *is* 0.088 m *above* ~~below~~ *Trig. Mast*
16. Diff. Ht. *found* ~~found~~ *is* ..... m *above* ~~below~~ *Trig. Mast*

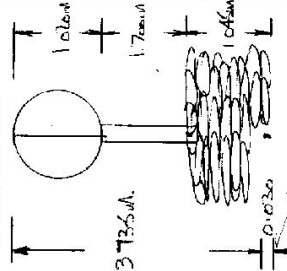

Prepared by: *P. BERTS* 14/3/77 Checked: *P. BERTS* 23/5/77  
Noted on U.T.M. Card

STATION: *TRIGONOMETRIC S.S. KILLARIE TS 5817*  
Co: *REXBURGH* Ph: *WETHELMERE*  
Map Sheet: *BATHURST* No: *8831.5*  
Inspected by: *P. BERTS* Date: *14/3/77*  
Authority: *C.M.L.A.* Field Book: *1665*

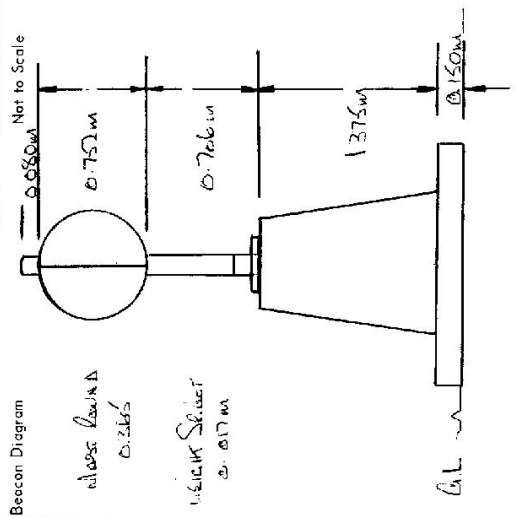

Beacon Diagram  
*class beam*  
*0.761*  
*1.375m*  
*G.L.*  
*0.751m*  
Date: *14/3/77* Record of Station: *RECONNAISSANCE PLATE PLACED*  
*14/3/77* *class beam* *PLATE PLACED*  
Checked

7.4.94

CENTRAL MAPPING AUTHORITY

GEODETIC SURVEY OF N.S.W.

GEODETIC STATION RECONNAISSANCE and MAINTENANCE REPORT

Description:

1. Cleared by lanes bearing.....  
 Note: Cross out word or words which do not apply  
 from Trig, Mast

2. Mast & Vanes have been painted white & black respectively.

3. The station/pillar was unpiled/not unpiled/constructed on..... 19....., dimensions now being:

Description of mark.....should be explicit, e.g., S/Steel Pillar Plate, Steel plug, Brass plug, Bolt, G.I. Pipe

Height of mark.....m. <sup>above</sup> rock/concrete; Mark is.....m. <sup>above</sup> G.L. <sub>below</sub>

Height of Top Vanes to Top Mark/Pillar plate .....m. Diameter of Vanes (vertical).....m.

Height of Cairn.....m. Diameter of Cairn.....m. Name Plate found/not found/placed.

Length of Mast.....m. (approximate if not unpiled)

4. A.....set in conc/rock has been placed/found, bearing.....° M from Mast/Plug/Pillar

5. A.....set in conc/rock has been placed/found, bearing.....° M from Mast/Plug/Pillar

6. A.....set in conc/rock has been placed/found, bearing.....° M from Mast/Plug/Pillar

7. A.....set in conc/rock has been placed/found, bearing.....° M from Mast/Plug/Pillar

8. Action required: Pillar mast - James St. Name Plate has been removed  
Base has not been painted STANDPOINT: Hill requires suchering

Mark	Direction	Horiz. Distance	Height Difference	Mark	Direction	Horiz. Distance	Height Difference
			above standpt.				above standpt.
			below				below
			above standpt.				above standpt.
			below				below
Prepared by:

Checked:

Noted on U.T.M. Card

Sr 2735-1

STATION: Yetholme No.: 5817  
 MAP SHEET Bothurst  
 SCALE 1:250 000  
 INSPECTED BY: J Sudog DATE: 9.3.19  
 AUTHORITY: CMA FIELD BOOK: 1308

Station Diagram  
 Not to Scale

Checked

CENTRAL MAPPING AUTHORITY

GEODETIC SURVEY OF N.S.W.

GEODETIC STATION RECONNAISSANCE and MAINTENANCE REPORT

Description: *Note: Cross out word or words which do not apply*

1. Cleared by lanes bearing.....
2. Mast & Vanes have been painted white & black respectively.
3. The ~~section~~/pillar was ~~unpiled~~/not unpiled/~~constructed~~ on..... 19.81....., dimensions now being:  
 Description of mark: ~~STEEL PILLAR~~ should be explicit, e.g., S/Steel Pillar Plate, Steel plug, Brass plug, Bolt, G.I. Pipe  
 Height of mark..... 1.375.....m. <sup>above</sup> ~~below~~ ~~rock/concrete~~; Mark is..... 5.75.....m. <sup>above</sup> ~~below~~ G.L.  
 Height of Top Vanes to Top Mark/Pillar plate..... 1.450.....m. Diameter of Vanes (vertical)..... 0.750.....m.  
 Height of Cairn.....m. Diameter of Cairn.....m. Name Plate found/not found/placed.  
 Length of Mast.....m. (approximate if not unpiled)
4. A..... set in conc/rock has been placed/found, bearing..... °M from Mast/Plug/Pillar
5. A..... set in conc/rock has been placed/found, bearing..... °M from Mast/Plug/Pillar
6. A..... set in conc/rock has been placed/found, bearing..... °M from Mast/Plug/Pillar
7. A..... set in conc/rock has been placed/found, bearing..... °M from Mast/Plug/Pillar
8. Action required:.....

STANDPOINT:

Mark	Direction	Horiz. Distance	Height Difference	Mark	Direction	Horiz. Distance	Height Difference
			above standpt				above standpt
			below				below
			above standpt				above standpt
			below				below

Prepared by: *A*

Checked: *A*

Noted on U.T.M. Card *3/18/81*

Checked

STATION: *YETHOLME GS (P)* No: *5817*  
 MAP SHEET SCALE 1:250 000  
 INSPECTED BY: *D TURNER* DATE: *21.1.81*  
 AUTHORITY: *C.M.A.* FIELD BOOK:  
 Station Diagram  
 North  
 Not to Scale  
 PILLAR DIMENSIONS ONLY  
 +  
 320 310 300 290 280 270 260 250 240 230 220  
 40 50 60 70 80 90 100 110 120 130 140  
 210 200 190 180 170 160 150

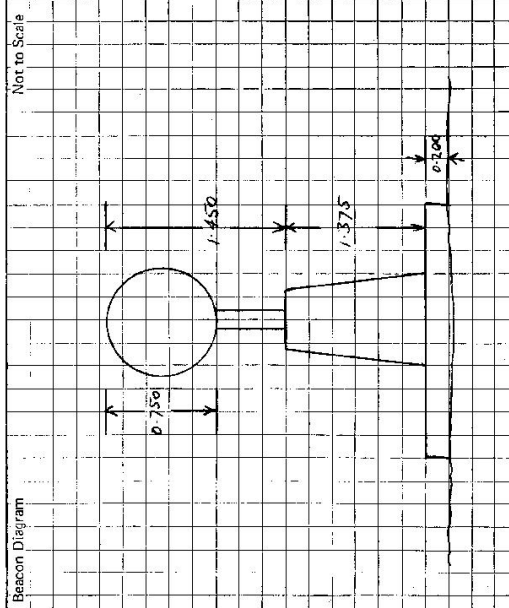STATION <b>YETHOLME GS (P) TS 5817</b>	Owner's Name: ..... Address: ..... Phone: ..... Current Occupant: ..... Address: ..... Phone: ..... Access Report of ...../19..... was found suitable/unsuitable.
Beacon Diagram Not to Scale	 <p>This section to be completed by officer constructing pillar.</p> Original station mark found/not found. Description of mark: ..... Original beacon found/not found. Description of beacon: ..... Height Top of Vanes to Top Mark .....m. Height of mark .....m. above G.L. below rock/conc. ....m. Diameter of Vanes .....m. Height of Cairn .....m. Original Beacon has/has not been destroyed by me.
Date	Record of Station

