


STATION **DIAMOND H.E. 5 75 5822**

Current Occupant... **DEPT. S.E. LANDS.**

Owners Name.....

Address.....

Not to Scale

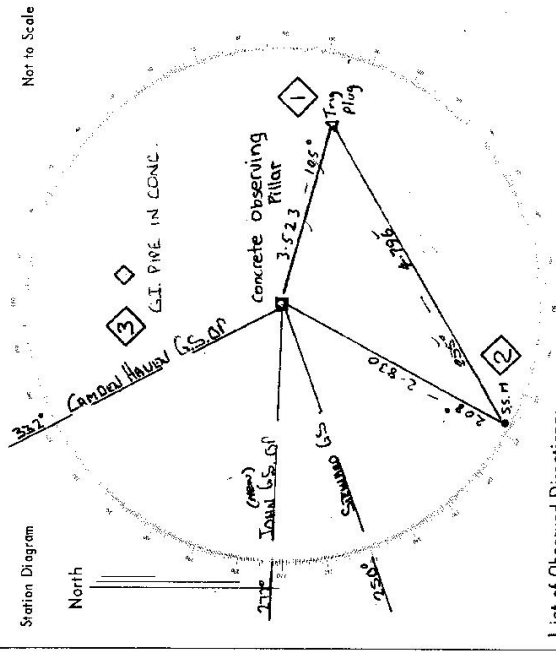

List of Observed Directions:-


Station	Obs. Point	Direction	Station	Direction
STATION: G.S.	STATION: G.S.	0	STATION: G.S.	0
T.M. (New) G.S.O.P.	22	05	S.S.M. in Conc. Id.	04
Cameral Huber G.S.O.P.	83	28	T.M. (Old) G.S.O.P.	28
T.M. Plug	72	30	Plum. Support	10
S.S.M. in Conc. Id.	30	55	Cameral Huber G.S.O.P.	83

Access **15-3-1977**

- ILLUMINATED FEATURE
- 0-00 LAURENCE RD. TUNNEL WEST.
- 0-10 TUNNEL LEFT
- 0-40 TUNNEL LEFT SIGN DIABOLIC
- 1-10 BARRAGE
- 1-40 PASSAGE DIABOLIC TUNNEL OCC
- 1-60 END OF SIGNAL RD
- 4-00 TUNNEL LEFT. FROM HERE TUNNEL UP HILL TO TILLS
- 10-50 GEODETIC STATION.

AVOID DAMAGE - DO NOT DRIVE THROUGH THE STRUT! (MULTI-BITS required 21/190 107)

Old Mast, Vanes and Cairn

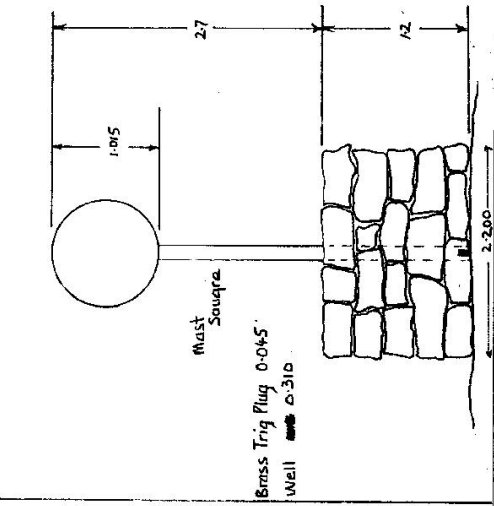

CENTRAL MAPPING AUTHORITY

GEODETIC SURVEY OF N.S.W.

GEODETIC STATION RECONNAISSANCE and MAINTENANCE REPORT

Description:

Note: Cross out word or words which do not apply

1. Cleared by lanes bearing..... from Trig. Mast
2. Mast & Vanes have been painted white & black respectively.
3. The station/pillar was unpiled/not unpiled/constructed on.....19....., dimensions now being:
Description of mark.....should be explicit, e.g., S/Steel Pillar Plate, Steel plug, Brass plug, Bolt, G.I. Pipe
Height of mark.....m, ^{above} rock/concrete; Mark is.....m, ^{above} G.L.
Height of Top Vanes to Top Mark/Pillar plate.....m. Diameter of Vanes (vertical).....m.
Height of Cairn.....m. Diameter of Cairn.....m. Name Plate found/not found/placed.
Length of Mast.....m. (approximate if not unpiled)
4. A.....set in conc/rock has been placed/found, bearing.....°M from Mast/Plug/Pillar
5. A.....set in conc/rock has been placed/found, bearing.....°M from Mast/Plug/Pillar
6. A.....set in conc/rock has been placed/found, bearing.....°M from Mast/Plug/Pillar
7. A.....set in conc/rock has been placed/found, bearing.....°M from Mast/Plug/Pillar
8. Action required.....

STANDPOINT:

STANDPOINT:

Mark	Direction	Horiz. Distance	Height Difference	Mark	Direction	Horiz. Distance	Height Difference
			above standpt				above standpt
			below				below
			above standpt				above standpt
			below				below
Prepared by: *[Signature]*

Checked: *[Signature]* Noted on U.T.M. Card

GS 2733-1

STATION: *Dianore (Rural)* No.: **5822**

MAP SHEET SCALE 1:250 000

INSPECTED BY: *L. R. Hayes* DATE: *22nd Feb '74*

AUTHORITY: *C.M.P.* FIELD BOOK: *1471*

Station Diagram


Not to Scale

STATION DREXDALE HEADS (HURON) TS 5822

Owner's Name:
 Address:
 Phone:

Current Occupant:
 Address:
 Phone:

ACCESS
 Access Report of 24th Dec 1977 was found suitable/unsuitable.

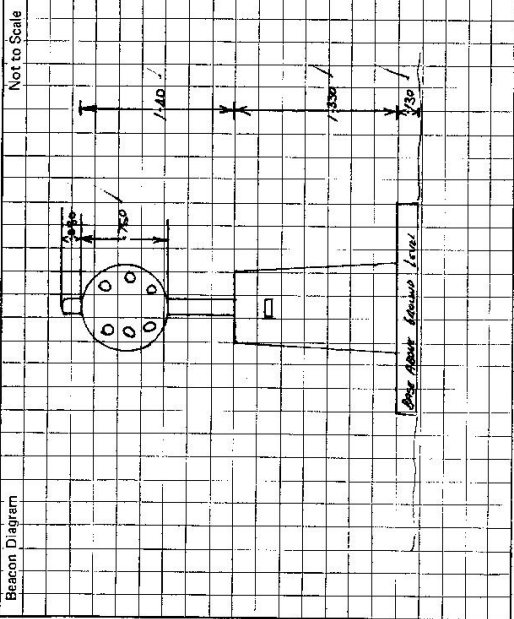

This section to be completed by officer constructing pillar.

Original station mark found/not found.

Description of mark:

Original beacon found/not found.

Description of beacon:

Height Top of Vanes to Top Mark:m.

Height of mark:m. above G.L.
 below rock/conc.m. below

Diameter of Vanesm. Height of Cairnm.

Original Beacon has/has not been destroyed by me.

Date

22.2.79

Record of Station

Mr & Mrs P. ...