



7488

Department of Lands
RECONNAISSANCE and MAINTENANCE REPORT
 Station: **ROUND PILLAR & S.T.S 5826**

Co: **CLARKE** / **South** / No: **9337 S**
 Map Sheet: **R.800**
 Inspected by: **DAVID J. KAIN** / Date: **19th March 1971**
 Authority: **C.M.A.** / Field Book: **01380**

This Trig. Station has been:
 Note: Cross out word or words which do not apply
 1. ~~Completed~~ **re-erected** to permit ~~360°~~ **vision to surrounding fringes**. **D.C.A. BUILDINGS AND RADAR TOWER** obscures a blocks vision and this station visibility as below.
 2. Cleared by lances bearing **108° 28' 12" W** from Trig. Meas. Siller.
 3. Trig. Mast & Vanes have been painted **white & black** respectively.
 4. The Trig. was unpiled / ~~substituted~~ **concrete observation pillar (Pillar)** dimensions now being: Original Station Mast found
 Description of mark... **Concrete observation pillar (Pillar) should be explicit, e.g. Steel plug, Brass plug, Bolt, G.I. Pipe**
 Height of mark... **1.37** m above ~~below~~ **steel/concrete**
 Height of Top Vanes to Top Mark... **1.44** m. Diameter of Vanes (vertical) **0.75** m.
 Height of Cairn... m. Diameter of Cairn... m.

- Length of Mast... m. (approximate if not unpiled)
D.C.A. REMAINT MARK IN CONE HAS BEEN FOUND IS 20.9 m. BEARING 63° 1' 9" FROM TRIG. PILLAR
 5. A. **S.S.M.** set in conc/teek has been placed... **1.74** m. bearing... **174° 1' 9" from Trig. Meas. Pillar**
 6. A. **G.I. PIPE ①** set in conc/teek has been placed... **1.74** m. bearing... **174° 1' 9" from Trig. Meas. Pillar**
 7. A. **TRIG. PLUG** set in conc/teek has been placed... **1.89** m. bearing... **189° 1' 9" from Trig. Meas. Pillar**
 8. A. **G.I. PIPE ②** set in conc/teek has been placed... **1.66** m. bearing... **166° 1' 9" from Trig. Meas. Pillar**
 9. Connection **D.C.A. to TRIG. PLUG** : **19.41** m. bearing **55° 1' 9"**
 10. Connection **S.S.M. to TRIG. PLUG** : **2.289** m. bearing **66° 1' 9"**
 11. Connection **G.I. PIPE ① to TRIG. PLUG** : **2.072** m. bearing **157° 1' 9"**
 12. Connection **G.I. PIPE ② to TRIG. PLUG** : **11.088** m. bearing **266° 1' 9"**
 Diff. Ht. **D.C.A. FROM MARK** IS **2.402** m. above **CONC. PILLAR**
 13. Diff. Ht. IS **1.402** m. below **CONC. PILLAR**
 14. Diff. Ht. **G.I. PIPE ①** IS **1.521** m. above **CONC. PILLAR**
 15. Diff. Ht. **TRIG. PLUG** IS **1.890** m. above **CONC. PILLAR**
 16. Diff. Ht. **G.I. PIPE ②** IS **2.654** m. above **CONC. PILLAR**

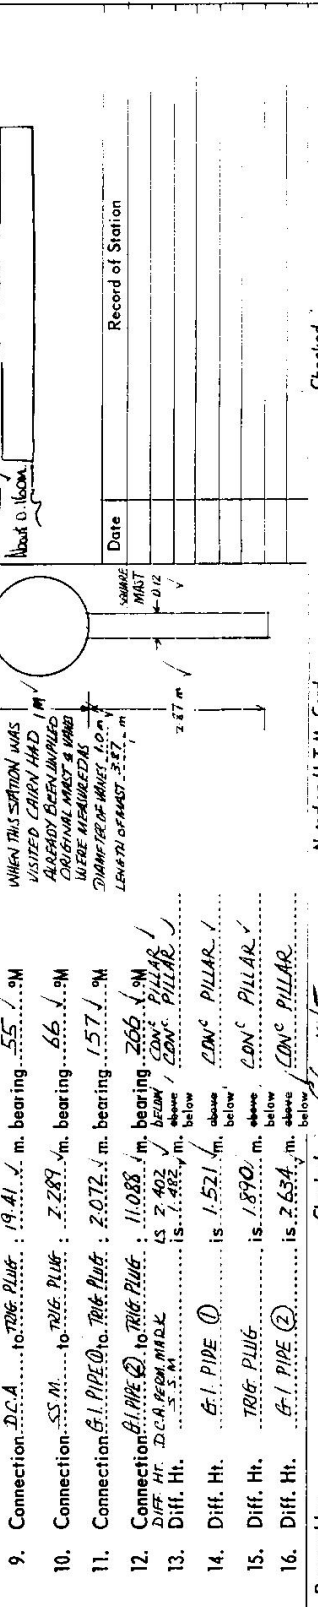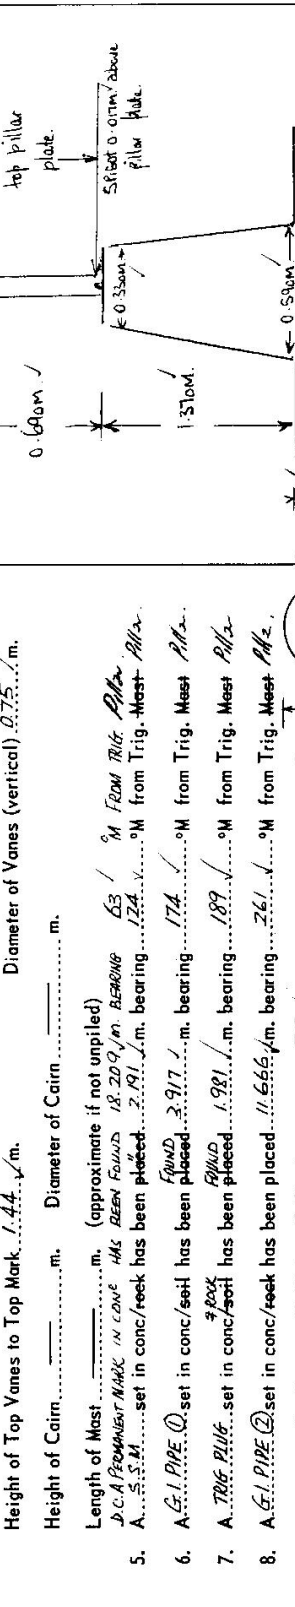

Record of Station
 Date
 Checked
 Prepared by: **4/19/5**
 Noted on U.T.M. Card

CENTRAL MAPPING AUTHORITY

GEODETIC STATION RECONNAISSANCE and MAINTENANCE REPORT


Description: *Note: Cross out word or words which do not apply*

- Cleared by lanes bearing..... from Trig. Mast
- Mast & Vanes have been painted white & black respectively.
- The station/pillar was ~~unplaced~~/~~constructed~~ on..... 9 June 1979, dimensions now being: Description of mark ~~SS. Pillar~~ ~~Plate~~ should be explicit, e.g., S/Steel Pillar Plate, Steel plug, Brass plug, Bolt, G.I. Pipe Height of mark..... m. ~~above~~/~~below~~ concrete; Mark is..... m. ~~above~~/~~below~~ G.I. Height of Top Vanes to Top Mark/Pillar plate ..1.435.....m. Diameter of Vanes (vertical) ..0.150.....m. Height of Girth.....m. Diameter of Girth.....m. Name Plate found/~~not found~~/~~placed~~. Length of Mast ..1.515.....m. (approximate if not unplaced)
- A..... G.I. Pipe..... set in conc/teck has been placed/found, bearing 75.9.....°M from Mast/Plug/Pillar
- A..... D.C.A.P.M..... set in conc/teck has been placed/found, bearing 66.....°M from Mast/Plug/Pillar
- A..... S.S.M..... set in conc/teck has been placed/found, bearing 11.9.....°M from Mast/Plug/Pillar
- A..... G.I. Pipe..... set in conc/teck has been placed/found, bearing 172.....°M from Mast/Plug/Pillar Trig. Plug (189°M from 7/P) not found
- Action required:.....

STANDPOINT:						
Mark	Direction	Horiz. Distance	Height Difference	Mark	Direction	Horiz. Distance
			above standpt.			
			below standpt.			
			above standpt.			
			below standpt.			
Prepared by: *m. vande* Checked: *checked R Cook 6/9/79* *Notepad* U.T.M. Card

St 2793-1

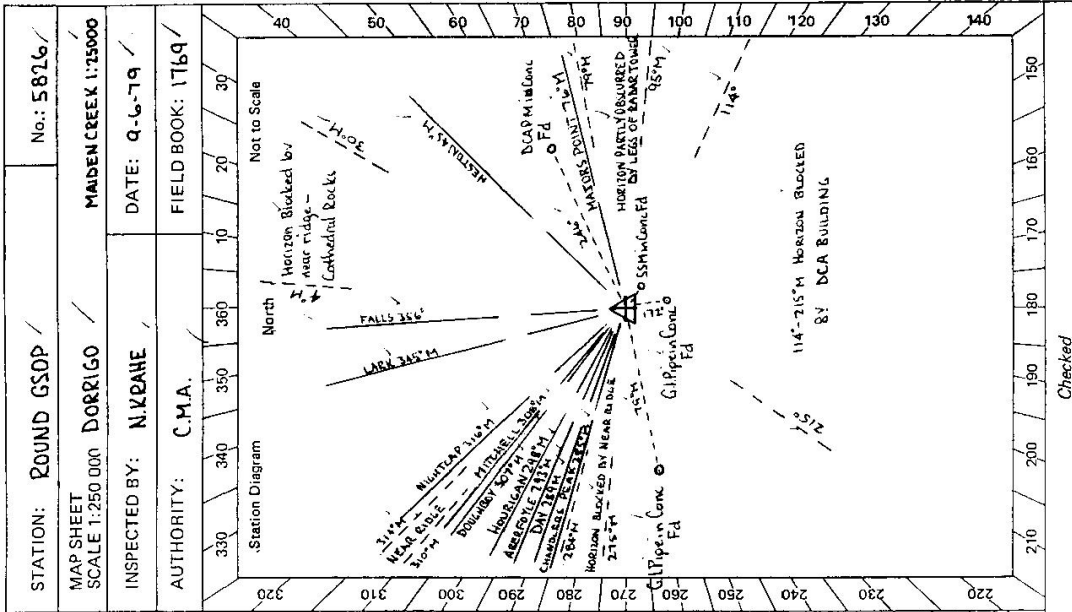

Checked

Sr 2733-2 D. West, Government Printer

Beacon Diagram	Not to Scale	STATION	ROUND GSOP / TS 5826
<p style="font-size: small;">This section to be completed by officer constructing pillar.</p> <p>Original station mark found/not found.</p> <p>Description of mark:</p> <p>Original beacon found/not found.</p> <p>Description of beacon:</p> <p>Height Top of Vanes to Top Mark.....m.</p> <p>Height of mark.....m. above G.L. below</p> <p>Diameter of Vanesm. Height of Cairnm.</p> <p>Original Beacon has/has not been destroyed by me.</p>			<p>Owner's Name:</p> <p>Address:</p> <p>Phone:</p> <p>Current Occupant:</p> <p>Address:</p> <p>Phone:</p> <p><u>ACCESS 9-6-1979</u></p> <p>Access Report of 13/3/1979: [was found suitable/unavailable. Alternate access supplied</p> <p>Ebor Hotel- Head in a S.W. direction towards Guyra and Armidale ✓</p> <p>0.15 Cross bridge over Guy Fawkes Creek ✓</p> <p>0.43 Pass Road on right to Ebor Falls ✓</p> <p>3.48 Take left turn to Wollanambi and Armidale ✓</p> <p>5.73 Turn right onto gravel road ✓</p> <p>6.20 Pass tin sheds on left ✓</p> <p>7.93 and 8.76 Cross Grids ✓</p> <p>11.74 Through locked gate CMA lock placed ✓</p> <p>13.81 Cross Grid ✓</p> <p>16.52 Enter DCA fenced compound -take track around to the left of building ✓</p> <p>16.56 ROUND GSOP ✓</p>
		Date	Record of Station

11