

CENTRAL MAPPING AUTHORITY

Trigonometrical Survey of N.S.W.

Department of Lands

RECONNAISSANCE and MAINTENANCE REPORT

This Trig. Station has been:-

Note: Cross out word or words which do not apply

- 1. Completely cleared to permit 360° vision to surrounding Trigs.
- 2. Cleared by lances bearing . . . . . from Trig. Mast
- 3. Trig. Mast & Vanes have been painted white & black respectively. ✓
- 4. The Trig. was unpiled/~~not unpiled~~, dimensions now being: . . . . .

Description of mark. ~~BRASS PLUG IN CONCRETE~~ should be explicit, e.g. Steel plug, Brass plug, Bolt, G.I. Pipe

Height of mark. . . . . m <sup>above</sup>/<sub>below</sub> G.L.

Height of Top Vanes to Top Mark. 3.572. m. Diameter of Vanes (vertical) 0.925 m.

Height of Cairn. 0.75 m. Diameter of Cairn 2.05 m.

Length of Mast. 3.715 m. (approximate if not unpiled)

- 5. A. 834 set in conc/rock has been placed. 2.685 m. bearing 163° 09' M from Trig. Mast
- 6. A. 674 set in conc/soil has been placed. 2.364 m. bearing 253° 09' M from Trig. Mast
- 7. A. set in conc/soil has been placed. . . . . m. bearing . . . . .°M from Trig. Mast
- 8. A. set in conc/rock has been placed. . . . . m. bearing . . . . .°M from Trig. Mast

9. Connection. . . . . to . . . . . m. bearing . . . . .°M

10. Connection. . . . . to . . . . . m. bearing . . . . .°M

11. Connection. . . . . to . . . . . m. bearing . . . . .°M

12. Connection. . . . . to . . . . . m. bearing . . . . .°M

13. Diff. Ht. 834 in Conc. is 0.203 m. above/ below ~~BRASS PLUG~~ BRASS PLUG

14. Diff. Ht. 674 in Conc. is 0.325 m. above/ below ~~BRASS PLUG~~ BRASS PLUG


15. Diff. Ht. . . . . is . . . . . m. above/ below

16. Diff. Ht. . . . . is . . . . . m. above/ below

Prepared by: M.L. HARRISON Checked

Noted on U.T. Mt. Card

STATION STYX A.S. TS 5827  
 Co: CLARKE / Ph: GEORGE /  
 Map Sheet: CARPAI / No: 933G N  
 Inspected by: M.L. HARRISON Date: 16.12.76  
 Authority: Field Book: 46

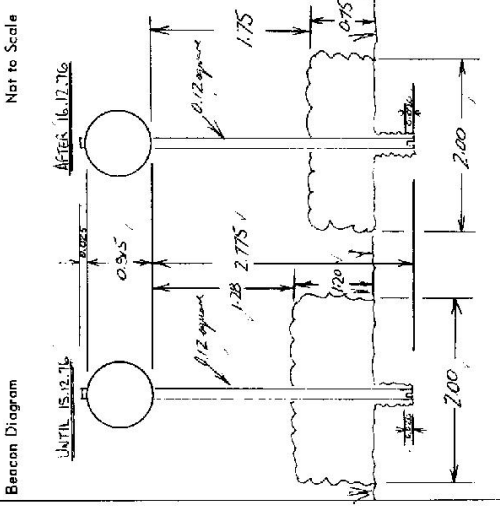

Date

Record of Station


Checked





STATION Sixx (Pillar) G.S. TS 5827


Owners Name... CROWN LAND

Address.....

Current Occupant.....

Not to Scale

Station Diagram

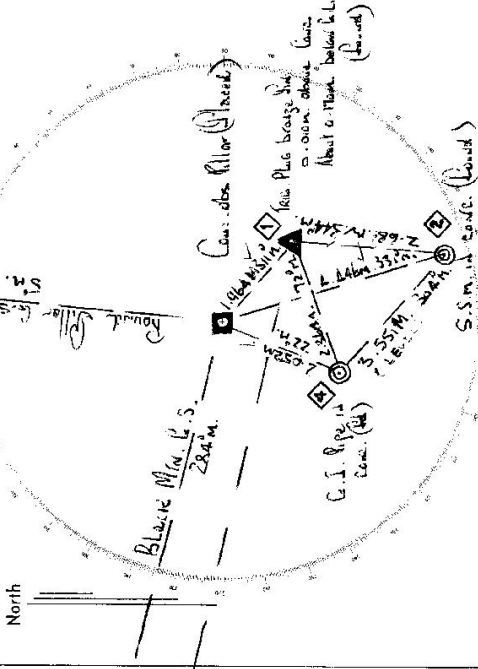

List of Observed Directions:-

Station	Direction	Station	Direction
Black Mt. G.S.	142 20	Black Mt. G.S.	22 38
C.I. (Pillar)	202 26	C.I. (Pillar)	234 43
C.I. (Pillar)	220 26	C.I. (Pillar)	324 57
C.I. (Pillar)	272 47		

Standpoint: Sixx (Pillar)

Access 25<sup>th</sup> / 3 / 1977  
 At Post Office Wollombi, AT 0.0 KILOMETRES LEAVE  
 TOWARD EBUR.

- Kilometres**
- 2-20 Cross Road bridge over Charlotte River.
  - 2-25 TAKE KEMPSEY Road to your RIGHT.
  - 9-10 Cross Road bridge over DAKEY CREEK.
  - 17-80 Cross Road bridge over STAY RIVER.
  - 21-70 PASS Honey Gully Road, to your RIGHT.
  - 22-25 TAKE RASPBERRY Road to your RIGHT.
  - 22-70 CONCRETE observation Pillar About 35 METRES ON LEAVE  
 hand side of Road.

This station is of very easy access & could be  
 driven to by station sedan type vehicle even  
 during heavy rain.