

GEODETTIC SURVEY OF N.S.W.

CENTRAL MAPPING AUTHORITY

GEODETTIC STATION RECONNAISSANCE and MAINTENANCE REPORT

Description:

1. Cleared by lanes bearing..... *Note: Cross out word or words which do not apply*

2. Mast & Vanes have been painted white & black respectively.

3. The station/pillar was unpiled/not unpiled/constructed on..... 19..... dimensions now being:

Description of mark..... should be explicit, e.g., S/Steel Pillar/Plater/Steel plug, Brass plug, Bolt, G.I. Pipe

Height of mark..... m. ^{above} rock/concrete; Mark is..... m. ^{above} G.L. _{below}

Height of Top Vanes to Top Mark/Pillar plate..... m. Diameter of ~~Vanes~~ ^(S) (Vertical)..... m.

Height of Cairn..... m. Diameter of Cairn..... m. ~~Platine~~ ^{PLATINE} Plate found/not found/placed.

Length of Mast..... m. (approximate if not unpiled)

4. A..... set in conc/rock has ~~been~~ ^{been} placed/found, bearing..... ° M from Mast/Plug/Pillar

5. A..... set in conc/rock has ~~been~~ ^{been} placed/found, bearing..... ° M from Mast/Plug/Pillar

6. A..... set in ~~conc~~ ^{conc} rock has ~~been~~ ^{been} placed/found, bearing..... ° M from Mast/Plug/Pillar

7. A..... set in conc/rock has ~~been~~ ^{been} placed/found, bearing..... ° M from Mast/Plug/Pillar

8. Action required.....

STANDPOINT: ~~.....~~

STANDPOINT: ~~.....~~

Mark	Direction	Horiz. Distance	Height Difference	Mark	Direction	Horiz. Distance	Height Difference
			above standpt below				above standpt below
			above standpt below				above standpt below
Prepared by: *P. Berts* 19. 11. 84 Checked: *A.S.* 2-11-11 *Noted on U.T.M. Card* *MB*


SR 2733-1

STATION: *Yarric Essel* No: *5829*
 MAP SHEET SCALE 1:250 000
 INSPECTED BY: *P. Berts* DATE:
 AUTHORITY: *C.M.A* FIELD BOOK: *1984*

Station Diagram
 North
 Not to Scale

Checked: *P.A.* 1-12-84

GS 24

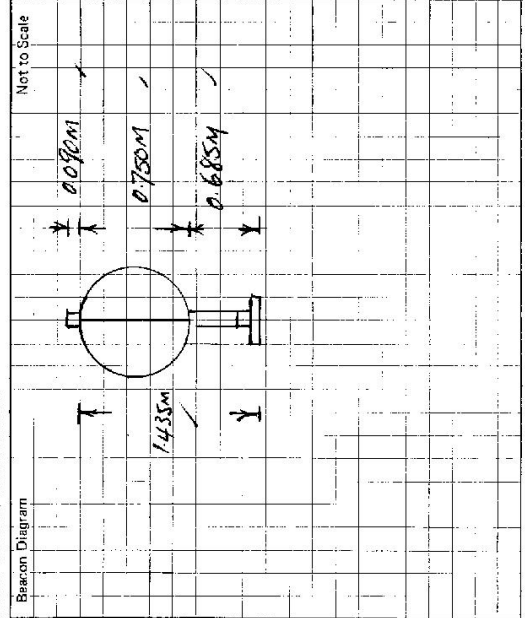STATION <u>Yaric 510</u> TS <u>5829</u>	Owner's Name: Address: Phone: Current Occupant: Address: Phone: Access Report of...../19.....was found suitable/unsuitable.
Beacon Diagram Not to Scale 	This section to be completed by officer constructing pillar. Original station mark found/not found. Description of mark: Original beacon found/not found. Description of beacon: Height Top of Vanes to Top Mark.....m. Height of mark.....m. above G.L. below rock/cone.....m. below Diameter of Vanes.....m. Height of Cairn.....m. Original Beacon has/has not been destroyed by me.
	Date Record of Station

CENTRAL MAPPING AUTHORITY

GEODETIC SURVEY OF NLS W.

GEODETIC STATION RECONNAISSANCE and MAINTENANCE REPORT

STATION: YARIC (P) No.: 5829

MAP SHEET SCALE 1:250 000 NEWCASTLE

INSPECTED BY: B. J. MITCHELL DATE: 20/8/82

AUTHORITY: DEPT. OF MAIN ROADS FIELD BOOK:

Description: *Note: Cross out word or words which do not apply*

1. Cleared by lanes bearing $230^\circ - 235^\circ$ $354^\circ - 20^\circ$ from Trig. Mast

2. Mast & Vanes have been painted white & black respectively.

3. The station/pillar was unpiled/not unpiled/constructed on 19 dimensions now being:

Description of mark should be explicit, e.g., S/Steel Pillar Plate, Steel plug, Brass plug, Bolt, G.I. Pipe

Height of mark m. ^{above} rock/concrete; Mark is m. ^{above} G.L.

Height of Top Vanes to Top Mark/Pillar plate m. Diameter of Vanes (vertical) m.

Height of Cairn m. Diameter of Cairn m. Name Plate found/not found/placed.

Length of Mast m. (approximate if not unpiled)

4. A. set in conc/rock has been placed/found, bearing M from Mast/Plug/Pillar

5. A. set in conc/rock has been placed/found, bearing M from Mast/Plug/Pillar

6. A. set in conc/rock has been placed/found, bearing M from Mast/Plug/Pillar

7. A. set in conc/rock has been placed/found, bearing M from Mast/Plug/Pillar

8. Action required:

STANDPOINT:

STANDPOINT:


Mark	Direction	Horiz. Distance	Height Difference	Mark	Direction	Horiz. Distance	Height Difference
			above standpt				above standpt
			below				below
			above standpt				above standpt
			below				below
Prepared by: B. MITCHELL


Checked: R. WEDER

Checked

S: 2783-1

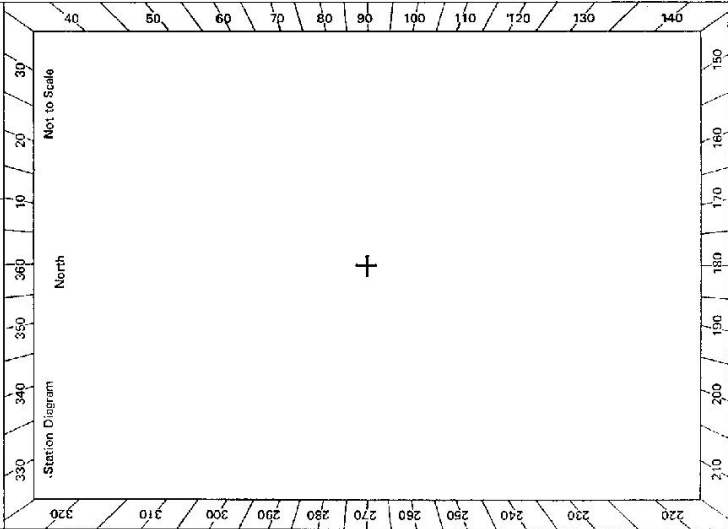

GS 24

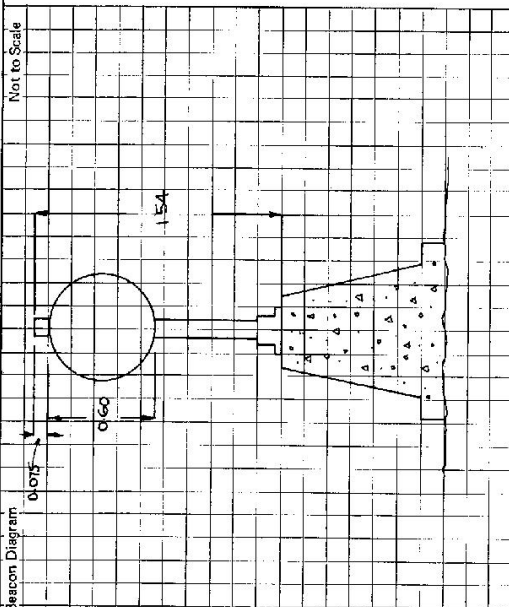STATION GS5829 YARIC(P) JS 5829	Owner's Name: Address: Phone: Current Occupant: Address: Phone: Access Report of 17/3/1977 was found suitable/..... ACCESS
Beacon Diagram  <p style="text-align: right;">Not to Scale</p>	This section to be completed by officer constructing pillar. Original station mark found/not found. Description of mark: Original beacon found/not found. Description of beacon: Height Top of Vanes to Top Markm. Height of markm. above below G.L. Diameter of Vanesm. Height of Cairnm. Original Beacon has/has not been destroyed by me.
	Date 20/8/82 Mast Replaced - new dimensions attached
Record of Station	

STATION Ypke TS 5829

Owners Name.....
 Current Occupant...Ma. Lores... Reyes.....

Address.....
 Address...B. FERNANDEZ, S......
THANZON

Access 17-3-1977


WMS - FERRARI

- 0-00 FERRARI P.O. TANGUALI, SM
- 0-70 TOWN BLVD SWAY LANE KWAK LOOK OUT
- 4-00 PERSPECTIVE RD TANGUALI TO (LEFT) HANG ON LEFT
- 15-40 TOWN BLVD SWAY LANE
- 22-60 TOWN LEFT SWAY BLUES BENCH
- 23-30 TOWN BLVD OPPOSITE GENERAL QUINCY
- 23-70 SWAY QUINCY OLD LEFT
- 24-75 TOWN BLVD HANGS BIDGE
- 24-90 WMS FENCE
- 25-40 FENCE LEFT DOWN MAIN BLVD OVER
- 25-40 CIRCUMFERENCE STRUCTURE

INTERNATIONAL OLD OLD SPANION

- VALUES: 7100
- DIAMETER OF RIVER 130
- DN' OF CAVEL 3000
- HEIGHT AT CAVEL 1000
- TOP VALUES TO TOP CAVEL 2000
- HEIGHT OF TELL TUB: 1022
- BEAL TUBE 300

Station Diagram
 Not to Scale

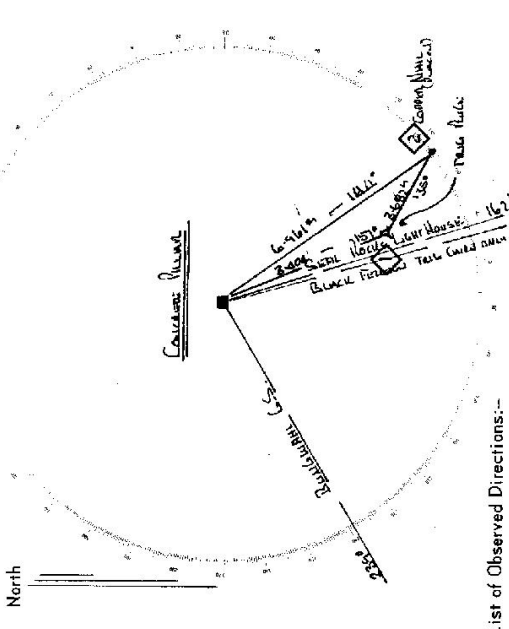

List of Observed Directions:-

Station	Direction	Station	Direction
Black Building	0 00 00	Black Building	0 00 00
General Quin. of Quin. (Bench)	296 05 00	House Street	197 20 50
Black Fence	277 25 10	General Quin. of Quin. (Bench)	252 58 00
Sway Quin. of Quin. (Bench)	283 09 20	Some Rocks	283 09 20
Black Fence	283 13 10	Black Fence	283 13 10