

CENTRAL MAPPING AUTHORITY

GEODETIC SURVEY OF N.S.W.

GEODETIC STATION RECONNAISSANCE and MAINTENANCE REPORT

STATION: **ADAMINABY** No.: **587**

Description:

1. Cleared by lanes bearing.....  
 Note: *Cross out word or words which do not apply*

2. ~~Mast & Vanes have been painted white & black respectively~~

3. The station/pillar was unpiled/not unpiled/constructed on..... 19....., dimensions now being:

Description of mark.....should be explicit, e.g., S/Steel Pillar Plate, Steel plug, Brass plug, Bolt, G.I. Pipe

Height of mark.....m. above below rock/concrete; Mark is.....m. above below G.L.

Height of Top Vanes to Top Mark/Pillar plate.....m. Diameter of Vanes (vertical).....m.

Height of Cairn.....m. Diameter of Cairn.....m. Name Plate found/not found/placed.

Length of Mast.....m. (approximate if not unpiled)

4. A. Brass plate..... set in conc/rock has been placed/found, bearing. 240° M from Mast/Plug/Pillar @ 9.3 m

5. A..... set in conc/rock has been placed/found, bearing.....° M from Mast/Plug/Pillar

6. A..... set in conc/rock has been placed/found, bearing.....° M from Mast/Plug/Pillar

7. A..... set in conc/rock has been placed/found, bearing.....° M from Mast/Plug/Pillar

8. Action required: Station needs painting black and while some minor clearing necessary for good all-round visibility


STANDPOINT:

Mark	Direction	Horiz. Distance	Height Difference	Mark	Direction	Horiz. Distance	Height Difference
			above standpt				above standpt
			below standpt				below standpt
			above standpt				above standpt
			below standpt				below standpt
Prepared by: G. Keep 24/7/00

Checked: Noted on U.T.M. Card

St 2733-1

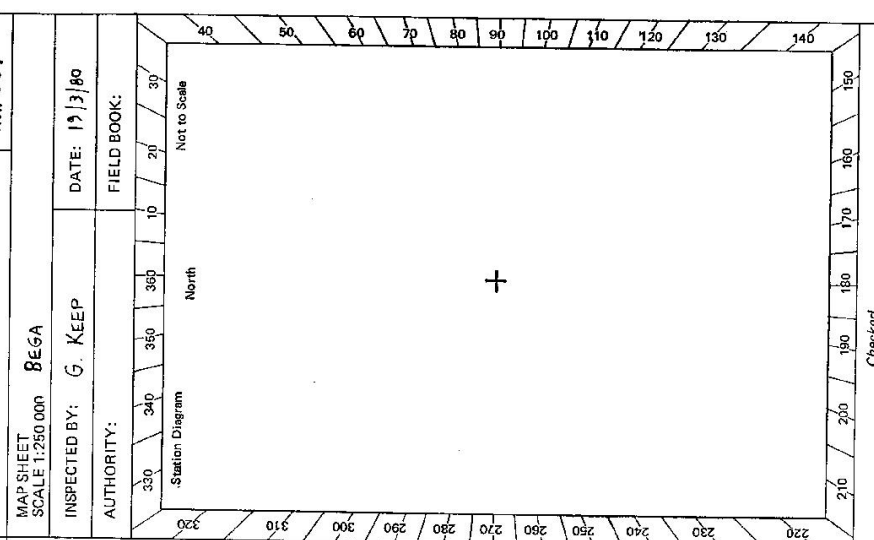


STATION **ADAMINABY** **587**

Owner's Name: .....  
 Address: .....  
 Phone: .....  
 Current Occupant: .....  
 Address: .....  
 Phone: .....

**ACCESS**

Access Report of 19/3/19 was found suitable/unsuitable.  
 From Dindabyne P.O. travel towards Cooma for 13.2 km and turn left toward Eucumbene Dam. Travel to Eucumbene Dam. From pumphouse on western side of dam, these milages.  
 km  
 0-00 Pumphouse  
 0-42 Take road on right after left hand corner  
 1-16 Tar road changes to dirt road.  
 1-36 Kosciusko National Parks' locked gate (K18 key needed)  
 2-27 Grid.  
 6-89 Cutting  
 7-93 Grid  
 9-93 Track to left to Adams Hut  
 15-47 Adaminaby T.S on left, 5 mins walk from road.

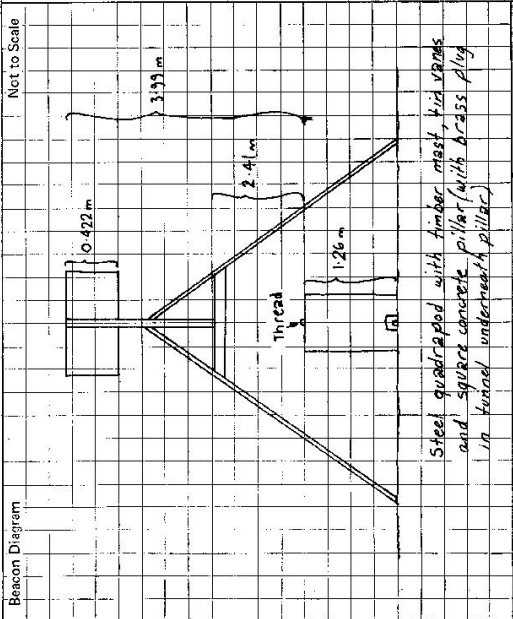

This section to be completed by officer constructing pillar.

Original station mark found/not found.

Description of mark: .....

Original beacon found/not found.

Description of beacon: .....

Height Top of Vanes to Top Mark.....m.

Height of mark.....m. above G.L. below

Diameter of Vanes .....m. Height of Callm .....m.

Original Beacon has/has not been destroyed by me.

Date	Record of Station