

STATION Blue Mountain (Pillar) G.S. 5873


Owners Name: Situated on Crown Land
 forty (40) Acre leg. reserve.
 Address: Mountain View
 Current Occupant: Lessee, Mr. Bill Hamill
 Address: Mountain View

Access 26-4-77
Access to Blue Mountain (Pillar) G.S.
at Malabar Post Office at 0.0 Kilometres, Road toward Ureila, Araratvale.

Kilometres

- 0.75 Turn Right along sealed Road at Signposts, Mount Plains 37 Km
- 8.15 Emu Creek 13 km, WINTERBOURNE 24KM.
- 11.30 TAKE LEFT FORK IN SEMIED ROADS AT SIGNPOSTS, WINTERBOURNE, EMU CREEK 5 KM.
- 15.80 TAKE RIGHT FORK AT SIGNPOSTS, WINTERBOURNE 11 KM, BLUE MOUNTAIN 8 KM.
- 23.60 BEAR LEFT AT SIGN, Blue Mountain 5 KM.
- 23.65 AT MAIL BOXES ON YOUR RIGHT, TAKE LEFT FORK IN GRAVEL ROADS.
- 24.25 TURN RIGHT INTO PROPERTY, Mountain View, follow track to homestead.
- 24.30 THROUGH IRON GATE ON YOUR RIGHT BELOW SHEARING SHEET.
- 24.75 THROUGH IRON GATE, FOLLOW TRACK.
- 25.60 THROUGH WOOD GATE, FOLLOW TRACK.
- 26.30 THROUGH WOOD GATE, FOLLOW TRACK.
- 26.60 TAKE TRACK ALONG RIDGE TO YOUR RIGHT.
- 26.85 CONCRETE OBSERVATION PILLAR.

Note: In Dry weather, it is possible to Drive a Station Sedan type vehicle onto this station.

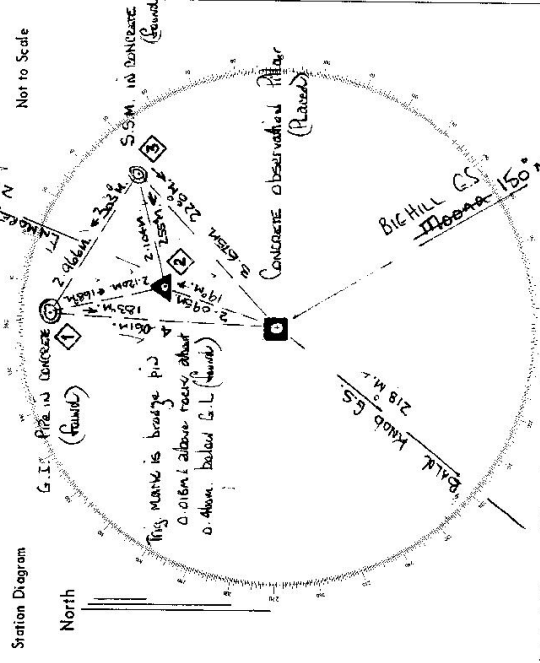

List of Observed Directions:-

Station	Direction	Station	Direction
BALD Knob G.S.	0 00 00	BALD Knob G.S.	0 00 00
G.I. Pipe	145 52 44	G.I. PIPE	178 22 34
TRIG. PLUG	159 53 49	EMUDS G.S.	164 06 06
EMUDS G.S.	164 06 13	BIG HILL G.S.	217 32 05
S.S.M.	188 51 51	MOONRA	287 25 11
BIG HILL G.S.	287 22 55	CONC. OBSERVATION PILLAR (top of sight)	334 34 44