

Department of Lands
 Reconnaissance and Maintenance Report
 Integral Survey of N.S.W.

Station Monument Hill 75 5880

Co: Map Sheet: No:
 Inspected by: L.M. Hayes Date: Dec. 1974
 Authority: Dept of Lands Field Book: GBL 32
 Beacon Diagram: Not to Scale

This Trig. Station has been:

1. Completely cleaned to permit 360° vision to surrounding Trig.
2. Cleared by lances bearing from Trig. Mast
3. Trig. Mast & Vanes have been painted white & black respectively.
4. The Trig. was unpiled/not unpiled, dimensions now being:

Description of mark: Obelisk should be explicit, e.g. Steel plug, Brass plug, Bolt, Concrete Pillar

Height of mark: m above rock/concrete m below G.L.

Height of Top Vanes to Top Mark/Top pillar plate m Diameter of Vanes (vertical) m.

Height of Cairn m Diameter of Cairn m.

Length of Mast m. (approximate if not unpiled)

5. A.M.32520 set in conc. ~~rock~~ has been placed/fd ^{Obelisk} 13.155 m. bearing 132° from Trig. Mast/pillar

6. Copper Spikes set in conc./soil has been placed/fd ^{Net} 67 m. bearing 67° from Obelisk

7. A set in conc./soil has been placed/fd m. bearing m. from Trig. Mast/pillar

8. A set in conc./rock has been placed/fd m. bearing m. from Trig. Mast/pillar

9. Connection: P.M.32520 to Copper Spike: 3.588 m. bearing 132° m.

10. Connection: to m. bearing m.

11. Connection: to m. bearing m.

12. Connection: to m. bearing m.

13. Diff. Ht. P.M.32520 is level ^{with} Copper Spike

14. Diff. Ht. is m. above below

15. Diff. Ht. is m. above below

16. Diff. Ht. is m. above below

Prepared by: L.M. Hayes Checked: P. Roberts Bay

Date	Record of Station

LAND INFORMATION CENTRE

GEODETIC SURVEY OF N.S.W.

GEODETIC STATION RECONNAISSANCE and MAINTENANCE REPORT

STATION: **MONUMENT HILL** No.: **S880**

MAP SHEET SCALE 1:250 000 **WANGARATTA**

INSPECTED BY: **A. Sivertsen** DATE: **5 Feb 92**

AUTHORITY: **LIC** FIELD BOOK: **2110**

Description:

1. Cleared by lanes bearing..... Note: *Cross out word or words which do not apply*

2. Mast & Vanes have been painted white & black respectively.

3. The station/pillar was unpiled/not unpiled/constructed on..... 19..... dimensions now being:

Description of mark..... should be explicit, e.g., S/Steel Pillar Plate, Steel plug, Brass plug, Bolt, G.I. Pipe

Height of mark.....m. ^{above} rock/concrete; Mark is **ON**.....m. ^{above} G.L.

Height of Top Vanes to Top Mark/Pillar plate.....m. Diameter of Vanes (vertical).....m.

Height of Cairn.....m. Diameter of Cairn.....m. Name Plate found/not found/placed.

Length of Mast.....m. (approximate if ~~not~~ unpiled)


4. A..... set in conc/rock has been placed/found, bearing.....°M from Mast/Plug/Pillar

5. A..... set in conc/rock has been placed/found, bearing.....°M from Mast/Plug/Pillar

6. A..... set in conc/rock has been placed/found, bearing.....°M from Mast/Plug/Pillar

7. A..... set in conc/rock has been placed/found, bearing.....°M from Mast/Plug/Pillar

8. Action required:.....

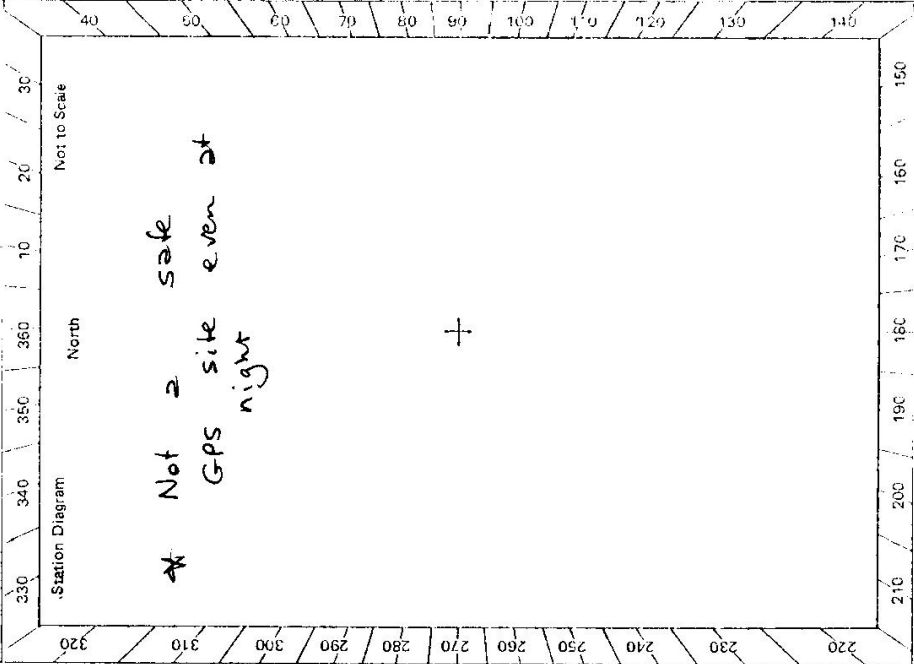

STANDPOINT:				STANDPOINT:			
Mark	Direction	Horiz. Distance	Height Difference	Mark	Direction	Horiz. Distance	Height Difference
			above standpt.				above standpt.
			below				below standpt.
			above standpt.				above standpt.
			below				below standpt.
Prepared by: *[Signature]* Checked: *[Signature]*

Noted on U.T.M. Card

Checked

