

CENTRAL MAPPING AUTHORITY

GEODETTIC SURVEY OF N.S.W.
GEODETTIC STATION RECONNAISSANCE and MAINTENANCE REPORT

Description: *Note: Cross out word or words which do not apply*

1. Cleared by lances bearing..... from Trig. Mast
2. Mast & Vanes have been painted white & black respectively.
3. The station/pillar was unpiled/not unpiled/constructed on..... 19....., dimensions now being: Description of mark..... should be explicit, e.g., S/Steel/Pillar Plate, Steel plug, Brass plug, Bolt, G.I. Pipe
- Height of mark..... m. ^{above} _{below} rock/concrete; Mark is..... m. ^{above} _{below} G.L.
- Height of Top Vanes to Top Mark/Pillar plate..... m. Diameter of Vanes (vertical)..... m.
- Height of Cairn..... m. Diameter of Cairn..... m. Name Plate found/not found/placed.
- Length of Mast..... m. (approximate if not unpiled)
4. A..... set in conc/rock has been placed/found, bearing.....°M from Mast/Plug/Pillar
5. A..... set in conc/rock has been placed/found, bearing.....°M from Mast/Plug/Pillar
6. A..... set in conc/rock has been placed/found, bearing.....°M from Mast/Plug/Pillar
7. A..... set in conc/rock has been placed/found, bearing.....°M from Mast/Plug/Pillar
8. Action required.....

STANDPOINT:

Mark	Direction	Horiz. Distance	Height Difference	Mark	Direction	Horiz. Distance	Height Difference
			above standpt.				above standpt.
			below standpt.				below standpt.
			above standpt.				above standpt.
			below standpt.				below standpt.
			above standpt.				above standpt.
			below standpt.				below standpt.
			above standpt.				above standpt.
			below standpt.				below standpt.

Prepared by: *[Signature]*

Checked: *[Signature]*

Noted on U.T.M. Card

St 2733-1

STATION: **JAMBEROO G.S.** No.: **5898**

MAP SHEET SCALE 1:250 000

INSPECTED BY: **M.L. HARRISON** DATE: **12-1-79**

AUTHORITY: **C.M.A.** FIELD BOOK: **1720**

Station Diagram

Not to Scale

Roof top Pillar found in good cond.
Small stainless steel pin in conc. fet.
Two A in rock found
One Copper nail in conc. fet.
Nameplate found. Only clearing required would be a couple of screws

Checked

Department of Lands

Triangometrical Survey of N.S.W.

RECONNAISSANCE and MAINTENANCE REPORT

This Trig. Station has been:-

Note: Cross out word or words which do not apply

1. Completely cleared to permit 360° vision to surrounding Trig.
2. Cleared by lines bearing 25° to 320°m Lane 360°m from Trig. Mast
3. Trig. Mast & Vanes have been painted white & black respectively. ✓
4. The Trig. was unplied/not unplied, dimensions now being: ✓

Description of mark: **Steel R.T.B** should be explicit, e.g. Steel plug, Brass plug, Bolt, G.I. Pipe
 Height of **Spigot** 0.016 m above **Pillar Plate** above G.L.
 rock/concrete
 Height of Top Vanes to Top Mark 1.210 m. Diameter of Vanes (vertical) 0.755 m.
 Height of **Pillar** 1.220 m. Diameter of **Cap** m.

- Length of Mast: m. (approximate if not unplied)
5. **Drill Hole** No. 1 **A** set in ~~conc~~/**rock** has been placed **3.448** m. bearing **53** °M from Trig. **Steel Mast Pillar**
 6. **Drill Hole** No. 2 **A** **rock** set in ~~conc~~/**soil** has been placed **3.672** m. bearing **58** °M from Trig. **Steel Mast Pillar**
 7. **A/S Pin** set in ~~conc~~/**soil** has been placed **3.410** m. bearing **60** °M from Trig. **Steel Mast Pillar**
 8. **Copper Nail** set in ~~conc~~/**rock** has been placed **4.013** m. bearing **113** °M from Trig. **Steel Mast Pillar**
 9. Connection: **S/S Pin** to **Copper Nail** **3.332** m. bearing **160** °M
 10. Connection: **S/S Pin** to **Drill Hole** **0.425** m. bearing **330** °M
 11. Connection: **S/S Pin** to **Drill Hole** **0.290** m. bearing **35** °M
 12. Connection: **Drill Hole** to **Drill Hole** **0.400** m. bearing °M
 13. Diff. Ht. **S/S Pin** is **1.743** m. below **Pillar Plate**
 14. Diff. Ht. **Copper Nail** is **1.918** m. below **Pillar Plate**
 15. Diff. Ht. **Copper Nail** is **0.176** m. below **S/S Pin**
 16. Diff. Ht. **Drill Hole** No. 2 is **1.832** m. below **Pillar Plate**

Prepared by: **H.C. BORDER** Checked: _____

Noted on U. T. M. Card

STATION **JAMBEROO 5898**


Co: **CAMDEN** Ph: **KIAMA**

Map Sheet: **KIAMA** No. **9028**

Inspected by: **H.C. BORDER** Date: **4-5-17**

Authority: **C.M.A** Field Book: **O1535**

Beacon Diagram Not to Scale

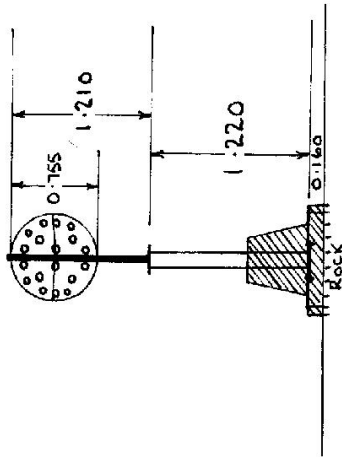

Date _____ Record of Station _____


S/STEEL PIN APPARENTLY PLACED BY WATERBOARD 16.8.66

Checked _____

STATION JAMBEROO TS 5898


Owners Name..... *L.M. Welch*
 Current Occupant.....
 Address..... *25 Cowell Crescent Mirrabooka*
 Address..... *957-1653*

Station Diagram
 mag, North

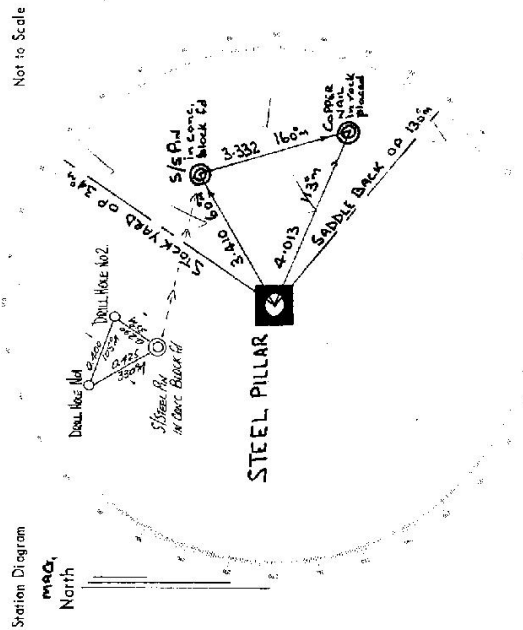

List of Observed Directions:-

Station	Direction	Station	Direction
SADDLE BACK OP	0 00	SADDLE BACK OP	0 00
COPPER NAIL in rock placed	31 10	STOCK YARD OP	748 01 35
STEEL PILLAR	113 33	DRILL HOLE N02 in rock f.d.	286 34 35
DRILL HOLE N02 in rock f.d.	201 07 35	DRILL HOLE N02 in rock f.d.	291 55 25
STOCK YARD OP	268 04 20	S/S PILLAR in cont. f.d.	293 35 30
DRILL HOLE N02 in rock f.d.	271 52 00	COPPER NAIL in rock placed	346 11 30

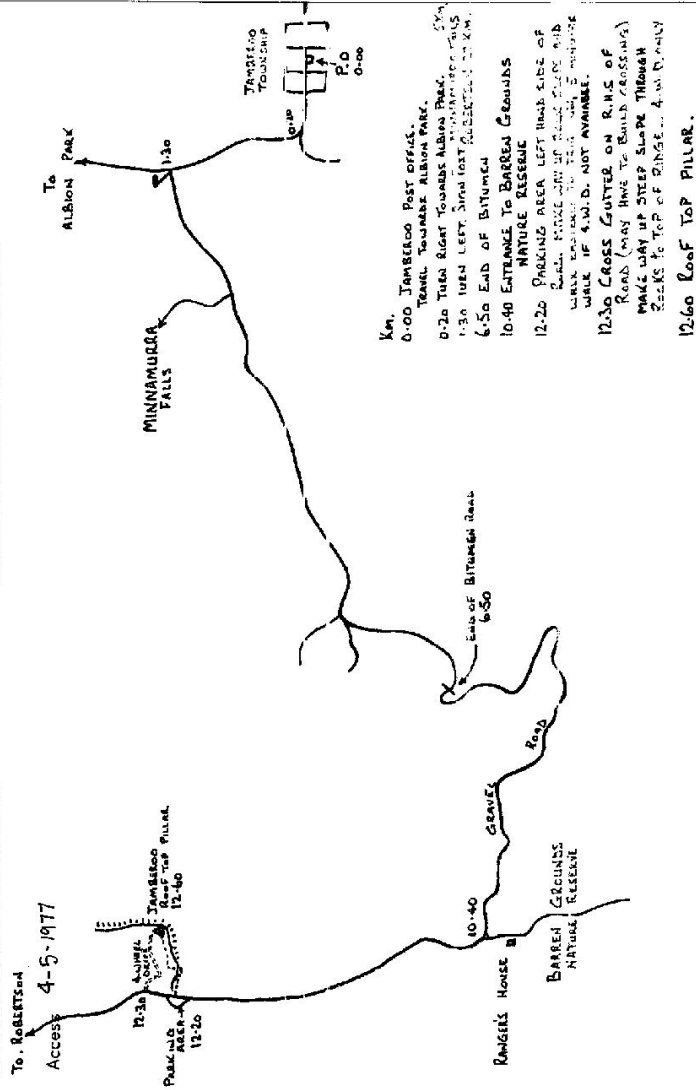


Km.
 0-00 JAMBEROO POST OFFICE.
 TRAVEL TOWARDS ALBION PARK.
 0-20 TURN RIGHT TOWARDS ALBION PARK.
 1-30 TURN LEFT SHIRT TAIL ROAD ALBION PARK.
 6-50 END OF BITUMEN
 10-40 ENTRANCE TO BARRETT'S NATURAL RESERVE
 12-20 PARKING AREA LEFT HAND SIDE OF ROAD. PARKING AREA OF ROAD TO BE MARKED WITH SIGNAGE. MARKING TO BE DONE BY 31/05/2022.
 12-30 CROSS CUTTER ON RAILS OF ROAD (MAY HAVE TO BUILD CROSSING)
 MAKE WAY UP STEEP SLOPE THROUGH TREES TO TOP OF RANGE... 4.000 MMS.
 12-60 LOAF TOP PILLAR.

ACCESS AS :- KIAMA and KANGAROO VALLEY 1:25000 MMS.

SI 2735-2 G. West Government Printer

Bacon Diagram

Not to Scale

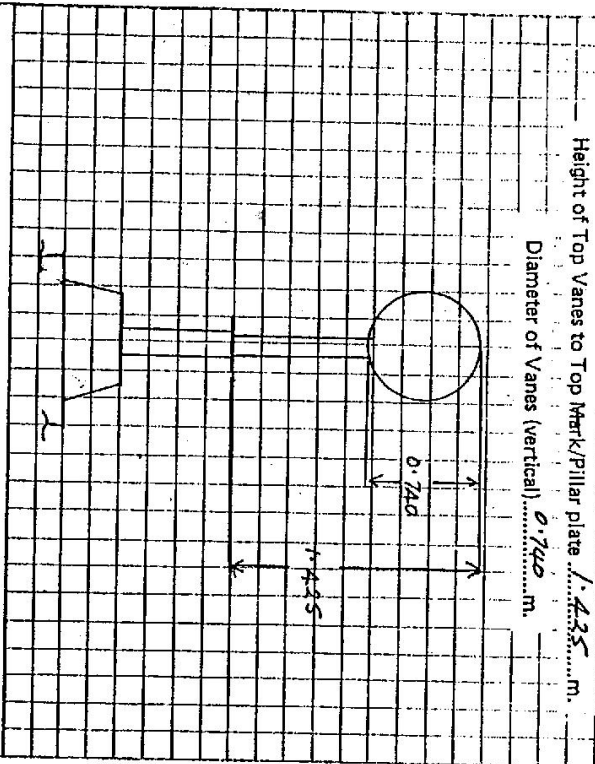

This section to be completed by officer constructing pillar.

Original station mark found/not found.

Description of mark:

Original beacon found/not found.

Description of beacon:

Height Top of Vanes to Top Mark:m.

Height of mark:m. above rock/cont.m. above G.L.
m. belowm. below

Diameter of Vanesm. Height of Cairnm.

Original Beacon has/has not been destroyed by me.

STATION **JAMBEROO (P)** **5898**

Owner's Name: **N.P. x WS**
 Address: **FITZROY FALLS**
TAM STAKE TR
 Phone: **4 88 77 244**

Current Occupant:
 Address:
 Phone:

Access Report of:/19..... was found suitable/unsuitable. **NEW ACCESS**

- 0.0 INTERSECTION OF ELLIWARANA H.WAY, JAMBEROO MT ROAD
- 9.6 PASS TRANS ROAD TO JAMBEROO HILL ROAD ON LEFT
- 10.8 PASS BUDDEROO TRACK ON RIGHT + SIGN SIGNS
- 11.9 PARK AT SIGN SIGNS ON CREST OF HILL
- WALK SIGN EAST TO TRIG

Date

INSPECTED BY: **G FORD** DATE: **6-6-2000**

Cleared by lanes bearing: **FOR G.R.** from Trig. Mast

NEW MAST & VANES