

CENTRAL MAPPING AUTHORITY

Department of Lands

Trigonometrical Survey of N.S.W.

RECONNAISSANCE and MAINTENANCE REPORT

This Trig. Station has been:

Note: Cross out word or words which do not apply

1. Completely cleared to permit 360° vision to surrounding Trigs.
 2. Cleared by lanes bearing..... from Trig. Mast
 3. Trig. Mast & Vanes have been painted white & black respectively ✓
 4. The Trig. was unpiled/~~not unpiled~~, dimensions now being: ~~Original~~ Station Mark found ~~.....~~
- Description of mark: Concrete Spheroidal Beacon should be explicit, e.g. Steel plug, Brass plug, Bolt, G.I. Pipe
- Height of mark..... m above rock/concrete m above G.L.
- Height of Top Vanes to Top Mark 1.435 m. Diameter of Vanes (vertical) 0.750 m.
- Height of Cairn..... m. Diameter of Cairn..... m.

Length of Mast 1.525 m. (approximate if not unpiled)

5. A ~~Brass Trig. Plug~~ set in conc/rock has been placed 1.098 m. bearing 234° from Trig. Mast Pillar
6. A ~~G.I. Pipe~~ set in conc/soil has been placed 1.98 m. bearing 198° from Trig. Mast Pillar
7. A..... set in conc/soil has been placed..... m. bearing.....° from Trig. Mast
8. A..... set in conc/rock has been placed..... m. bearing.....° from Trig. Mast

9. Connection..... to..... m. bearing 95°
10. Connection..... to..... m. bearing.....°
11. Connection..... to..... m. bearing.....°
12. Connection..... to..... m. bearing.....°
13. Diff. Ht. Brass Trig. Plug is 1.184 m. above Brass Plug
14. Diff. Ht. G.I. Pipe is 1.337 m. above Brass Plug
15. Diff. Ht. is..... m. above.....
16. Diff. Ht. is..... m. above.....

Prepared by: M.L. Morrison Checked: 22-6-77 Noted on U.T.M. Card

STATION COPELAND GS TS-5903


Co: GLoucester / Pk: BANDERA

Map Sheet: UPPER MANNING SOUTH / No: 9234-S

Inspected by: M.L. Morrison / Date: 14.6.77

Authority..... / Field Book: 01580, 01403

Beacon Diagram..... Not to Scale

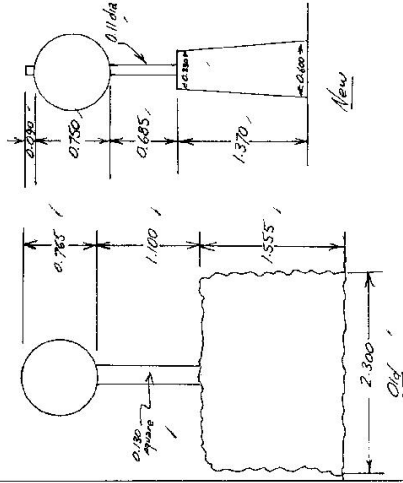

Date..... Record of Station

16-6-78 SSM could not be found. Assembly destroyed. Old mast and vanes - dimensions - see diagram.

Checked

STATION *CORRELAND G.S. TS 5903*


Owners Name..... Current Occupant.....

Address..... Address.....

Access *14-6-1977*

DIRECTION
 0.0 BARRINGTON RD. TRAVELING WEST TOWARDS MOUNEVILLE.
 1.00 WOODEN BRIDGE OVER BARRINGTON RIVER
 1.40 TURN LEFT SIGN 'BARRINGTON TOWNS FORESTLAND' 'CORRELAND G.S.' 'CORRELAND B'
 5.30 CAUSEWAY
 7.70 WOODEN BRIDGE
 8.70 CAUSEWAY
 8.85 WOODEN BRIDGE
 8.95 TURN RIGHT SIGN 'BARRINGTON TOWNS FORESTLAND' 'CORRELAND G.S.' 'CORRELAND B'
 15.05 TURN RIGHT ONTO TRACK OPPOSITE PICNIC AREA AND TAKE RIGHT HAND BANK
 15.55 TAKE LEFT FORK.
 16.65 IRON GATE (KEY CAN BE OBTAINED AT FORESTRY OFFICE GLENKILSTER)
 16.90 WIRE GATE AND CATTLE YARDS ON RIGHT FOLLOW ALONG LEADING OF FENCE
 17.20 PAST HUT AT 16.95
 17.35 WIRE GATE
 18.30 TRIG

Station Diagram
 1:40 North
 Not to Scale

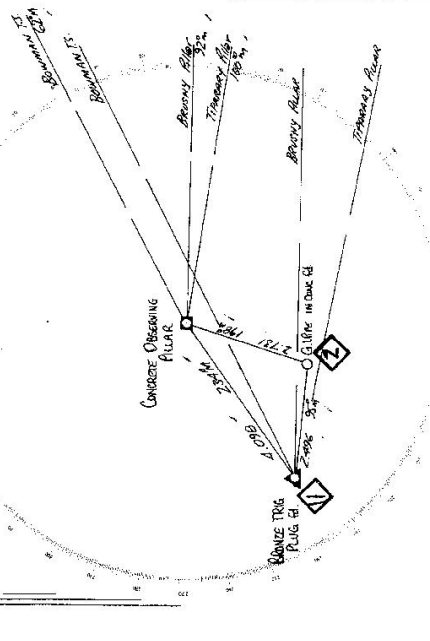

List of Observed Directions:-

Station	Direction	Station	Direction
Barrington TS (Corner, Acc. Dist.)	0	Barrington TS (Corner, Acc. Dist.)	0
BRISBY FILLAR	29 25 10	BRISBY FILLAR	29 25 00
TIPARARY FILLAR	37 27 10	TIPARARY FILLAR	33 10 40
GUPPE W CONCRETE	136 19 30	TIPARARY FILLAR	37 27 00
BRONZE TRIG ALG GA.	172 42 35	CONC OBS FILLAR	352 44 25

Station	Direction	Station	Direction