

CENTRAL MAPPING AUTHORITY
Department of Lands

Trigonometrical Survey of N.S.W.

RECONNAISSANCE and MAINTENANCE REPORT

This Trig. Station has been:-

Note: Cross out word or words which do not apply

1. Completely cleared to permit 360° vision to surrounding Trigs.
2. Cleared by lones bearing..... from Trig. Mast
3. Trig. Mast & Vanes have been painted white & black respectively ✓
4. The Trig. was unpiled/~~not unpiled~~, dimensions now being: ~~Original~~ ^{Original} ~~Spigots~~ ^{Spigots} ~~Mark~~ ^{Mark} ~~found~~ ^{found}


Description of mark..... ~~Concrete~~ ^{Concrete} ~~Recess~~ ^{Recess} ~~Base~~ ^{Base} should be explicit, e.g. Steel plug, Brass plug, Bolt, G.I. Pipe
 Height of mark..... m ^{above} ~~below~~ rock/concrete m ^{above} ~~below~~ G.L.
 Height of Top Vanes to Top ~~Mark~~ ^{Mark} 1.430 m. Diameter of Vanes (vertical) 0.730 m.
 Height of Cairn..... m. Diameter of Cairn..... m.

- Length of Mast 4.520 m. (approximate if not unpiled)
5. A ~~Recess~~ ^{Recess} ~~200~~ ²⁰⁰ ~~feet~~ ^{feet} in ~~conc~~ ^{conc}/~~rock~~ ^{rock} has been ~~placed~~ ^{placed} 2.958 m. bearing 352° M from Trig. ~~Mast~~ ^{Pillar}
 6. A ~~Concrete~~ ^{Concrete} ~~base~~ ^{base} set in ~~conc~~ ^{conc}/~~soil~~ ^{soil} has been placed 3.250 m. bearing 293° M from Trig. ~~Mast~~ ^{Pillar}
 7. A..... set in ~~conc~~ ^{conc}/~~soil~~ ^{soil} has been placed..... m. bearing.....°M from Trig. Mast
 8. A..... set in ~~conc~~ ^{conc}/~~rock~~ ^{rock} has been placed..... m. bearing.....°M from Trig. Mast

9. Connection ~~between Trig. to Concrete~~ ^{between Trig. to Concrete} ~~base~~ ^{base} is 3.058 m. bearing 237° M
10. Connection..... to..... m. bearing.....°M
11. Connection..... to..... m. bearing.....°M
12. Connection..... to..... m. bearing.....°M
13. Diff. Ht. ~~Spigot Trig Base~~ ^{Spigot Trig Base} is 1.151 m. ~~above~~ ^{above} ~~below~~ ^{below} ~~Pillar~~ ^{Pillar} ~~Base~~ ^{Base}
14. Diff. Ht. ~~Concrete~~ ^{Concrete} ~~Mast~~ ^{Mast} is 1.480 m. ~~above~~ ^{above} ~~below~~ ^{below} ~~Pillar~~ ^{Pillar} ~~Base~~ ^{Base}
15. Diff. Ht. is..... m. ~~above~~ ^{above} ~~below~~ ^{below}
16. Diff. Ht. is..... m. ~~above~~ ^{above} ~~below~~ ^{below}

Prepared by: M.L. Morrison Checked: [Signature] 27/5/22 Noted on U.T.M. Card

STATION CRAWEN G.S. TS 5904
 Co: GADGUESTER / Ph: A.A. Cox's Grant
 Map Sheet: BULAHDELDAH NORTH No: 9333-N
 Inspected by: M.L. Morrison Date: 13. 6. 77
 Authority: Field Book: 01549, 01403

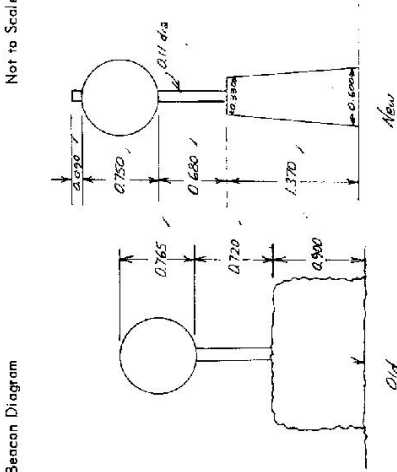

Date	Record of Station

STATION **CRANEN G.S. TS 5904**

Current Occupant

Owners Name

Address

Access **13-6-1977**


Time Direction

- 0.00 CRANEN RD. TURNER SOUTH TOWARDS STRAITS
- 0.40 TURN LEFT SIGN CRANEN STATE FOREST
- 7.20 GRID
- 8.55 TAKE LEFT FORK
- 10.90 TURN LEFT SIGN TRIG RD
- 11.10 CREEK
- 13.20 TURN RIGHT UP HILL SIGN CRANEN TRIG LOOKOUT
- 14.00 TRIG

Not to Scale

Station Diagram

MAG. North

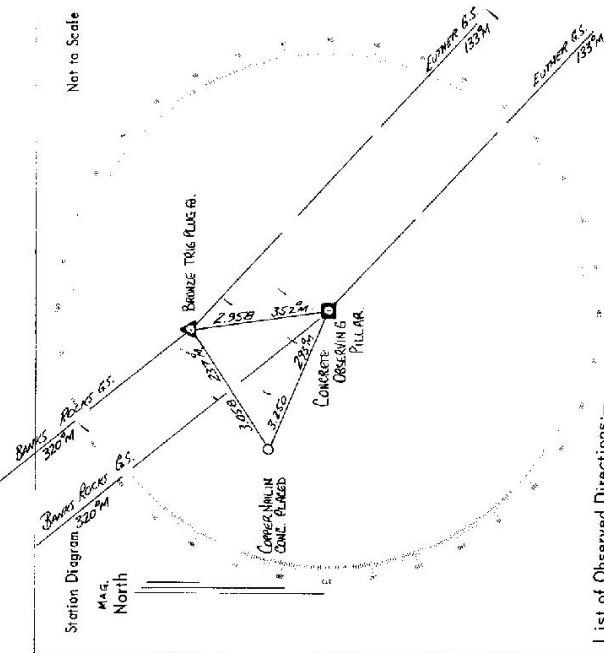

List of Observed Directions:-

Station	Direction	Station	Direction
CRANEN G.S.	0 00 00	CRANEN G.S.	0 00 00
CONCRETE PILLAR	180 19 40	CONCRETE PILLAR	180 19 40
BANKS ROCKS PILLAR	180 05 55	BANKS ROCKS PILLAR	180 05 55
BANKS ROCKS PILLAR	219 06 00	BANKS ROCKS PILLAR	219 06 00

Station	Direction	Station	Direction