

CENTRAL MAPPING AUTHORITY
 Department of Lands

Trigonometrical Survey of N.S.W.

RECONNAISSANCE and MAINTENANCE REPORT

This Trig. Station has been:-

Note: Cross out word or words which do not apply

1. Completely cleared to permit 360° vision to surrounding Trigs. ✓
2. Cleared by lanes bearing..... from Trig. Mast
3. Trig. Mast & Vanes have been painted white & black respectively. ✓
4. The Trig. was unpiled ~~met-impiled~~ dimensions now being: ~~Concrete~~ ^{Concrete} ~~Obscuring Pillar~~ should be explicit, e.g. Steel plug, Brass plug, Bolt, G.I. Pipe


Description of mark.....
 Height of mark..... m above rock/concrete
 Height of Top Vanes to Top ~~Mark~~ ^{Pillar} m above G.L.
 Height of Cairn..... m. Diameter of Cairn..... m.
 Diameter of Vanes (vertical) ~~0.750~~ m.

5. A ~~Brass Trig. Plug~~ ^{Pillar} set in ~~conc/rock~~ ^{found} has been placed..... m. bearing..... m from Trig. Mast
6. A ~~Brass Trig. Plug~~ ^{Pillar} set in conc/soil has been placed..... m. bearing..... m from Trig. Mast
7. A..... set in conc/soil has been placed..... m. bearing..... m from Trig. Mast
8. A..... set in conc/rock has been placed..... m. bearing..... m from Trig. Mast

9. Connection ~~Brass Trig. Plug to Cairn~~ ^{Brass Trig. Plug to Cairn} : 2.804' m. bearing..... m
10. Connection..... to..... : m. bearing..... m
11. Connection..... to..... : m. bearing..... m
12. Connection..... to..... : m. bearing..... m
13. Diff. Ht. ~~Brass Trig. Plug~~ ^{Brass Trig. Plug} is 2.082' above ~~Brass Trig. Plug~~ ^{Brass Trig. Plug}
14. Diff. Ht. ~~Cairn~~ ^{Cairn} is 1.544' above ~~Brass Trig. Plug~~ ^{Brass Trig. Plug}
15. Diff. Ht. is m. above
 is m. below
16. Diff. Ht. is m. above
 is m. below

Prepared by: M.L. Morrison Checked: R. J. ... Noted on U.T.M. Card

74-88
 STATION THEBARY G.S. TS 5906
 Co: GLoucester Ph: M/M
 Map Sheet: BULLADELAH NORTH No: 9333-N
 Inspected by: M.L. Morrison Date: 15.6.77
 Authority Field Book: 01640, 04623

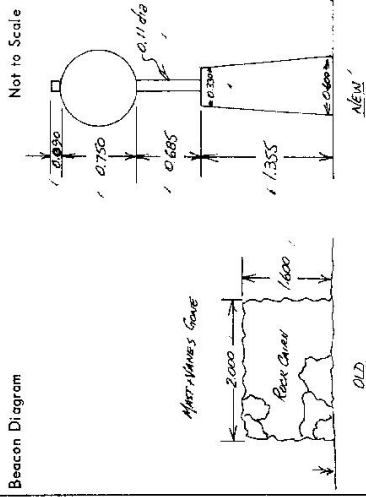

Date	Record of Station

Checked


STATION TIPARARY G.S. TS 5906

Owners Name..... Current Occupant.....

Address..... Address.....

15-6-1977

Access	Direction
0.0	KOMBACK RD. TRAVEL WEST TOWARDS GLOUCESTER
14.75	TURN LEFT SIGN 'MIMI WILSON'
15.05	TURN LEFT
15.10	IRON GATE
15.45	CATTLE YARDS ON LEFT.
16.10	HIDDEN GATE
16.30	TAKE RIGHT PAST FARK
16.45	IRON GATE
16.60	CATTLE YARDS ON RIGHT.
17.10	TAKE LEFT PAST RIVER WOODEN BRIDGE
18.05	IRON GATE
18.35	TAKE RIGHT PAST CATTLE YARDS
18.40	IRON GATE
19.20	HOUSE AND SHEDS ON LEFT.
19.70	IRON GATE
19.80	IRON GATE
19.90	TAKE LEFT PAST THROUGH IRON GATE
21.30	TURN LEFT ALONG RIDGE
21.80	TURN LEFT DOWN ALONG RIDGE
22.30	WIRE GATE
22.90	TRIG

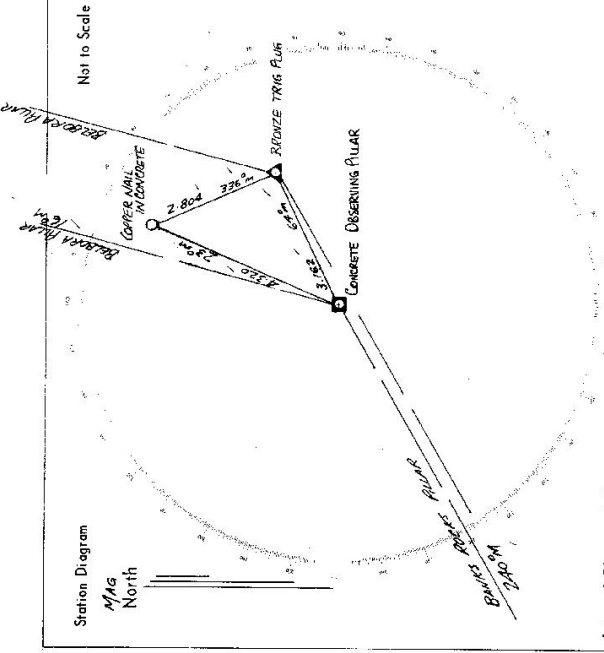

List of Observed Directions:-

Standpoint: CONCRETE OBSERVING PILLAR Standpoint: BRONZE TRIG PILLAR

Station	Direction	Station	Direction
BRONZE TRIG PILLAR	0 00	BRONZE TRIG PILLAR	0 00
CONCRETE PILLAR	134 49	CONCRETE PILLAR	3 51
CONCRETE PILLAR	143 26	CONCRETE PILLAR	96 26
CONCRETE PILLAR	183 47	CONCRETE PILLAR	134 49

Station	Direction	Station	Direction

CENTRAL MAPPING AUTHORITY

GEODETIC SURVEY OF N.S.W.

GEODETIC STATION RECONNAISSANCE and MAINTENANCE REPORT

Description:

1. Cleared by lanes bearing 316.0° *Note: Cross out word or words which do not apply*

2. Mast & Vanes have been painted white & black respectively. ✓
 Mast & Vanes from Trig, Mast

3. The station/pillar was unpiled/not unpiled/constructed on..... 19....., dimensions now being:

Description of mark..... should be explicit, e.g. S/Steel Pillar Plate, Steel plug, Brass plug, Bolt, G.I. Pipe

Height of mark.....m, above rock/concrete; Mark is.....m, above G.L.

Height of Top Vanes to Top Mark/Pillar plate.....m. Diameter of Vanes (vertical).....m.

Height of Cairn.....m. Diameter of Cairn.....m. Name Plate found/~~not found~~/placed.

Length of Mast.....m. (approximate if not unpiled)

4. A..... set in conc/rock has been placed/found, bearing.....°M from Mast/Plug/Pillar

5. A..... set in conc/rock has been placed/found, bearing.....°M from Mast/Plug/Pillar

6. A..... set in conc/rock has been placed/found, bearing.....°M from Mast/Plug/Pillar

7. A..... set in conc/rock has been placed/found, bearing.....°M from Mast/Plug/Pillar

8. Action required:.....

STANDPOINT:

STANDPOINT:

Mark	Direction	Horiz. Distance	Height Difference	Mark	Direction	Horiz. Distance	Height Difference
			above standpt.				above standpt.
			below				below
			above standpt.				above standpt.
			below				below
Prepared by:

Checked: *AK*

Noted on U.T.M. Card

Checked

SI 2733-1

STATION: **TIPPERARY (P)** No.: **5906**

MAP SHEET SCALE 1:250 000 **NEWCASTLE**

INSPECTED BY: **C. PARKES** DATE: **25/9/81**

AUTHORITY: **C.M.A.** FIELD BOOK: **1923**

Station Diagram

