

GEODETTIC SURVEY OF N.S.W.

CENTRAL MAPPING AUTHORITY

GEODETTIC STATION RECONNAISSANCE and MAINTENANCE REPORT

Description:

Note: Cross out word or words which do not apply

1. Cleared by lanes bearing..... from Trig. Mast
2. Mast & Vanes have been painted white & black respectively.
3. The station/pillar was unpiled/hot unpiled/constructed on.....19....., dimensions now being:
 - Description of mark.....should be explicit, e.g., S/Steel Pillar Plate, Steel plug, Brass plug, Bolt, G.I. Pipe
 - Height of mark.....m. ^{above}/_{below} rock/concrete; Mark is.....m. ^{above}/_{below} G.L.
 - Height of Top Vanes to Top Mark/Pillar platem. Diameter of Vanes (vertical).....m.
 - Height of Cairn.....m. Diameter of Cairn.....m. Name Plate found/not found/placed.
 - Length of Mast.....m. (approximate if not unpiled)
4. A.....set in conc/rock has been placed/found, bearing.....° M from Mast/Plug/Pillar
5. A.....set in conc/rock has been placed/found, bearing.....° M from Mast/Plug/Pillar
6. A.....set in conc/rock has been placed/found, bearing.....° M from Mast/Plug/Pillar
7. A.....set in conc/rock has been placed/found, bearing.....° M from Mast/Plug/Pillar
8. Action required:.....

STANDPOINT:

Mark	Direction	Horiz. Distance	Height Difference	Mark	Direction	Horiz. Distance	Height Difference
			above standpt.				above standpt.
			below				below
			above standpt.				above standpt.
			below				below
Prepared by:

Checked:

Noted on U.T.M. Card


St 2733-1

Checked

STATION: BELL (P)	No.: 5908
MAP SHEET SCALE 1:250 000 SYDNEY	DATE: 1978
INSPECTED BY: C.M.A.	FIELD BOOK:
AUTHORITY:	

St 2733-2 D. West, Government Printer

STATION BILL (P) 5908

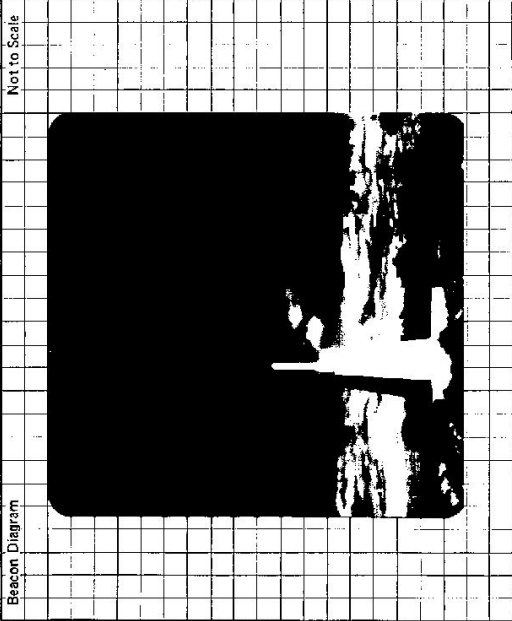

Owner's Name:
 Address:
 Phone:
 Current Occupant:
 Address:
 Phone:
 Access Report of/18.11 was found suitable/unsuitable. **ACCESS**

This section to be completed by officer constructing pillar.

Original station mark found/not found.

Description of mark:

Original beacon found/not found.

Description of beacon:

Height Top of Vanes to Top Markm.

Height of markm. above G.L. below

Diameter of Vanesm. Height of Cairnm.



Original Beacon has/has not been destroyed by me.

Date	Record of Station

STATION **BELL TS 5908**

Owners Name:
 Current Occupant:
 Address:
 Address:

Access 6-6-78
 600m
 GO BELL & TAKE ROAD TO WINDSOR.
 25. CUTTING AT CREST OF ROAD JUST PAST
 OLD STONE HOUSE "HOLLY LODGE" (on left)

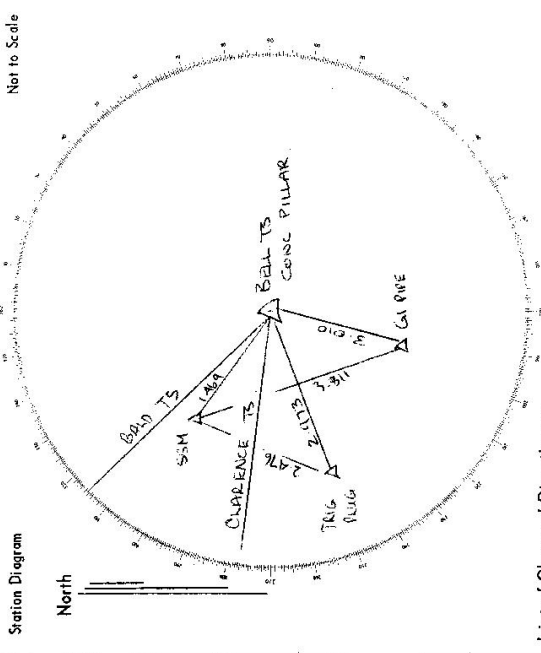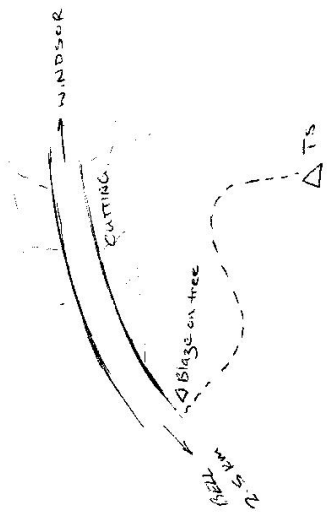

List of Observed Directions:-

Station	Direction	Station	Direction
BELL TS	315° 44' 10"	PILLAR	0° 00' 00"
CLARENCE TS	271° 05' 38"	GI PIPE	170° 12'
SSM	305° 54' 45"	TRIG PLUG	94° 17' 05"
GI PIPE	193° 56' 58"		
TRIG PLUG	249° 46' 56"		


Station	Direction	Station	Direction

STATION **TS 5908 BELL**


Owners Name..... Current Occupant.....

Address..... Address.....

Access 14-5-81
 AT BELL TAKE ROAD TO WINDSOCK
 AT 2.5 KM TURN ONTO TRACK ON RIGHT

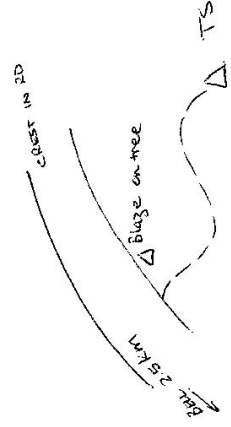

Station Diagram Not to Scale

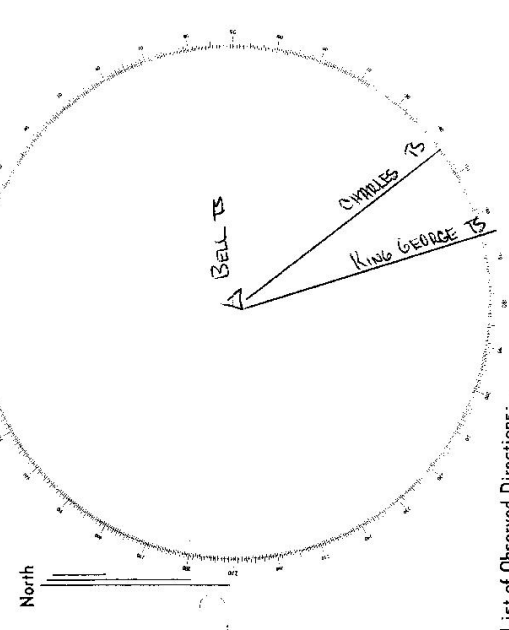

List of Observed Directions:-

Standpoint: FALLAR		Standpoint:	
Station	Direction	Station	Direction
CHARLES TS	144 10.36		
KING GEORGE TS	165 26.09		