

TS 5929
STATION TABER CONC OBS PILLAR

Owners Name: NATIONAL PARKS... WILD LIFE Current Occupant:

Address: KUL-RINGS-G.I...CLOSE NATIONAL PARK Address:

Access: 19-8-1977 TERRY HILLS

0-0 INTERSECTIONS: MONA VALLE ROAD + WESTHEAD ROAD
TRAVEL ALONG WESTHEAD RD.


2-0 PASS TURN OFF TO WESTHEAD + CHURCH POINT.

2-2 RANGER TOLL GATE.

5-8 TURN LEFT ONTO COTTAGE POINT ROAD.

7-4 CREST OF HILL TURN RIGHT ONTO BUSH TRACK.

7-7 T.S.

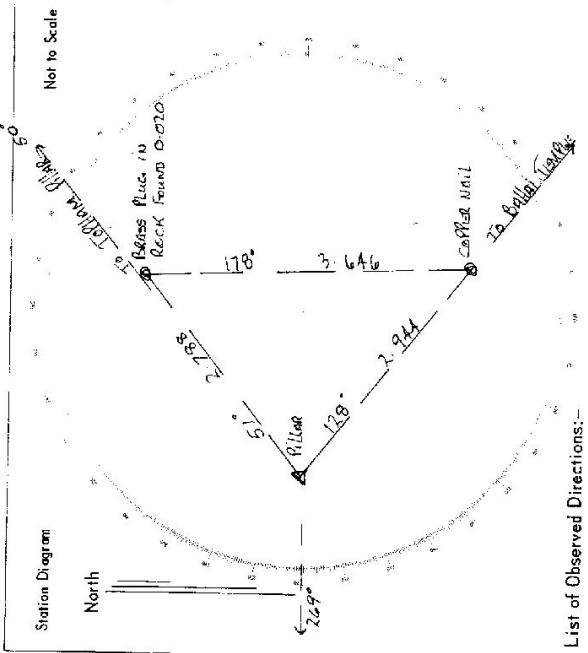

List of Observed Directions:-

Station	Direction	Station	Direction
Standpoint: <u>CONC OBS PILLAR</u>		Standpoint: <u>BRASS TRIG PLUG</u>	
<u>TO PHAM RT. PILLAR</u>	<u>359.59.60</u>	<u>TO PHAM PILLAR</u>	<u>359.59.60</u>
<u>COPPER NAIL</u>	<u>177.43.20</u>	<u>BAHAI TEMPLE</u>	<u>177.47.35</u>
<u>BAHAI TEMPLE</u>	<u>177.46.20</u>	<u>COPPER NAIL</u>	<u>176.20.45</u>
<u>RES 65</u>	<u>217.53.20</u>	<u>PILLAR</u>	<u>178.46.15</u>
<u>TRIG PLUG</u>	<u>358.47.15</u>	<u>RES 65</u>	<u>217.52.05</u>