

GEODETTIC SURVEY OF N.S.W.

CENTRAL MAPPING AUTHORITY

GEODETTIC STATION RECONNAISSANCE and MAINTENANCE REPORT

Description:

1. Cleared by lanes bearing $183^{\circ} 19' 30''$ 206.46 ± 0.11 348.36 ± 0.10 from Trig. Mast
Note: Cross out word or words which do not apply
2. Mast & Vanes have been painted white & black respectively.
3. The ~~standpoint~~/pillar was ~~replaced~~/replaced/constructed on $4.12.10$, dimensions now being:
sh. base ~~1.385~~ 1.385 m. ~~above~~ ^{below} ~~concrete~~/concrete; Mark is 1.385 m. ~~above~~ ^{below} G.L.
Diameter of Vanes (vertical) 0.75 m.
- Height of Top Vanes to Top ~~standpoint~~/Pillar plate 1.061 m. Diameter of Cairn ~~replaced~~/replaced/placed.
- Length of Mast ~~replaced~~ m. (approximate if not unriped)
4. A. ~~G.I. Nail~~ set in conc/~~rock~~ has been placed/~~replaced~~, bearing 239° M from ~~standpoint~~/Pillar
5. A. ~~BOLT~~ set in conc/~~rock~~ has been placed/~~replaced~~, bearing 335° M from ~~standpoint~~/Pillar
6. A. ~~Copper Nail~~ set in conc/~~rock~~ has been ~~replaced~~/found, bearing 340° M from ~~standpoint~~/Pillar
7. A. ~~CONC OBS NAILE~~ set in conc/~~rock~~ has been placed/~~replaced~~, bearing 340° M from Mast/Plug/Pillar
8. Action required: ~~CONC OBS NAILE~~

Mark	Direction	Horiz. Distance	Height Difference	Mark	Direction	Horiz. Distance	Height Difference
BYRON VIEW G.P.	0 00 00		above standpoint	BYRON VIEW G.P.	0 00 00		above standpoint
G.I. NAIL	0 00 00	2.289	1.071	CHALCOAN G.P.	S 11 20		above standpoint
CHALCOAN G.P.	S 11 00		below	BOLT IN CONC	92 37 10	2.751	0.060
BOLT IN CONC	S 41 10	4.034	1.000	CONC OBS NAILE	275 57 05	2.285	1.598
COPPER NAIL	N 02 00	1.287	1.400	LENNON HEAD G.P.	300 07 00		above standpoint
LENNON HEAD G.P.	300 06 20		below	G.I. NAIL IN CONC	332 11 20	2.738	0.269


STANDPOINT: ~~CONC OBS NAILE~~ *Copper Nail*

Prepared by: *PHS* 12.12.10

Checked:

Noted on U.T.M. Card

ST 2736-1

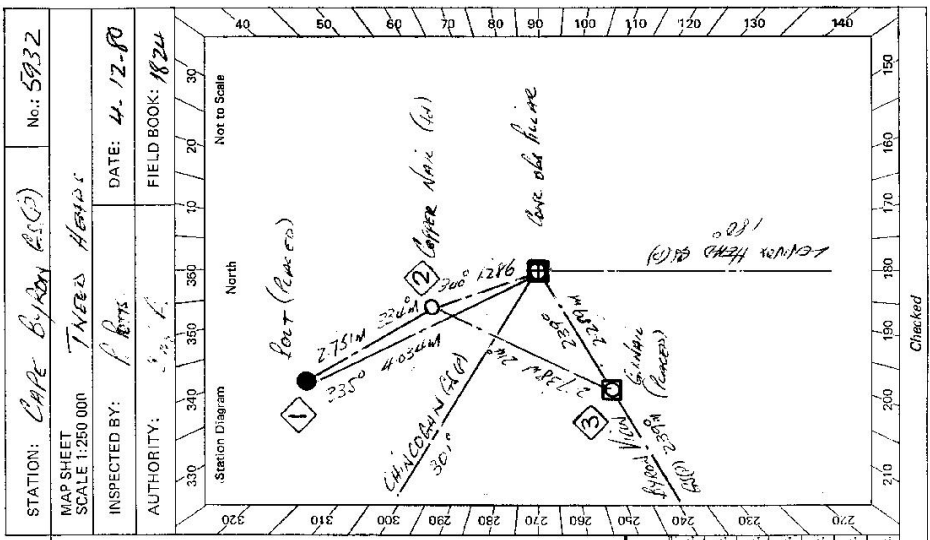

Checked

STATION: CAPE BYRON G.S.C. No.: 5932

MAP SHEET SCALE 1:250 000 TNEES A5542.C

INSPECTED BY: P. HYS DATE: 4.12.10


AUTHORITY: *PHS* FIELD BOOK: 1824

STATION CAPE BYRON (10) TS 5932

Owner's Name: *Dept. of Transport*
 Address: *Light House Keepers Cape Byron*
 Phone: *066 656503*
 Current Occupant:
 Address:
 Phone:

ACCESS

Access Report of: *4/12/1980* was found suitable/unsuitable.
 KM FEATURE
 0.00 *AST OFFICE BYRON DAY HEAD NORTH*
 0.20 *TOWN RIGHT 400 LAMING STREET FOLLOW SIGN TO LIGHTHOUSE*
 2.90 *MAIN ENTR TO LIGHTHOUSE*
 3.20 *SIGN ON AST PEDIESTALAS (NEW T MARK AST CAN DE*
 3.40 *REMOVED (SEE KEYS) MONUMENT STATION CAPE BYRON*

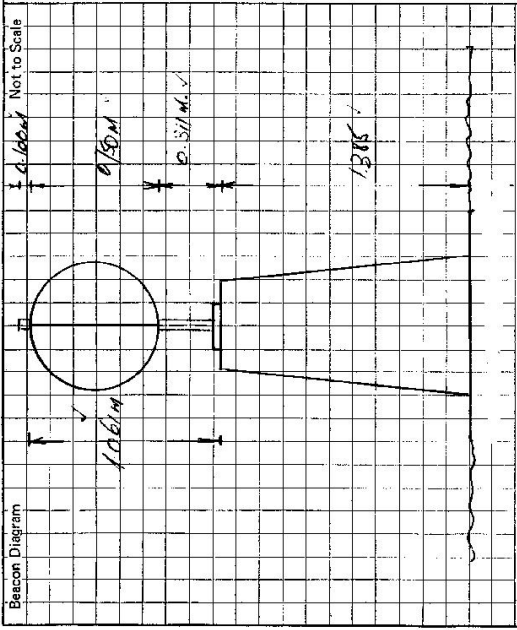

This section to be completed by officer constructing pillar.

Original station mark found/not found.

Description of mark:

Original beacon found/not found.

Description of beacon:

Height Top of Vanes to Top Markm.

Height of markm. above G.L. below

Diameter of Vanesm.

Height of Cairnm.

Original Beacon has/not been destroyed by me.

Date	Record of Station

CENTRAL MAPPING AUTHORITY

GEODETIC SURVEY OF M.S.W.

GEODETIC STATION RECONNAISSANCE and MAINTENANCE REPORT

Description:

1. Cleared by lanes bearing.....
Note: Cross out word or words which do not apply
2. Mast & Vanes have been painted white & black respectively.
3. The station/pillar was unpiled/not unpiled/constructed on.....
19..... dimensions now being:

Description of mark..... should be explicit, e.g., S/Steel Pillar Plate, Steel plug, Brass plug, Bolt, G.I. Pipe

Height of mark..... m. above rock/concrete; Mark is..... m. above below G.I.

Height of Top Vanes to Top Mark/Pillar plate..... m. Diameter of Vanes (vertical)..... m.

Height of Cairn..... m. Diameter of Cairn..... m. Name Plate found/not found/placed.

Length of Mast..... m. (approximate if not upretd) *OM*

4. A..... set in conc/rock has been placed/found/bearing..... M from Mast/Plug/Pillar

5. A..... set in conc/rock has been placed/found, bearing..... M from Mast/Plug/Pillar

6. A..... set in conc/rock has been placed/found, bearing..... M from Mast/Plug/Pillar

7. A..... set in conc/rock has been placed/found, bearing..... M from Mast/Plug/Pillar

8. Action required.....

STANDPOINT:

Mark	Direction	Horiz. Distance	Height Difference	Mark	Direction	Horiz. Distance	Height Difference
			above standpt				above standpt
			below				below
			above standpt				above standpt
			below				below
Prepared by: *P. BOTS* 13.11.84 Checked: *27*

ST 2733-1

Noted on U.T.M. Card *412184*

Checked *10/12/84*

STATION: *Cape Byron* No.: *5932*
 MAP SHEET SCALE 1:250 000
 INSPECTED BY: *P.P. BOTS* DATE: *13.11.84*
 AUTHORITY: *C.M.A.* FIELD BOOK: *1944*

Station Diagram

STATION <u>Cape Byron TS 5932</u>	Owner's Name: <u>DEPARTMENT OF TRANSPORT</u> Address: <u>11 GREAT HOUSE ROAD</u> <u>Cape Byron</u> Phone: <u>02626 236503</u> Current Occupant: Address: Phone: ACCESS Access Report of <u>13/11/1984</u> was found suitable/unsuitable.
Beacon Diagram Not to Scale	<p>This section to be completed by officer constructing pillar.</p> Original station mark found/not found. Description of mark: Original beacon found/not found. Description of beacon: Height Top of Vanes to Top Markm. Height of markm. above G.L. / below rock/conc.m. below Diameter of Vanesm. Height of Cairnm. Original Beacon has/has not been destroyed by me.
	Date Record of Station

GEODETTIC SURVEY OF N.S.W.

CENTRAL MAPPING AUTHORITY


GEODETTIC STATION RECONNAISSANCE and MAINTENANCE REPORT

STATION: CAPE BYRON (P) No.: 5932

MAP SHEET SCALE 1:250 000 TWEED HEADS

INSPECTED BY: B. MITCHELL DATE: 1/3/85

AUTHORITY: DEPT. MAIN ROADS FIELD BOOK:

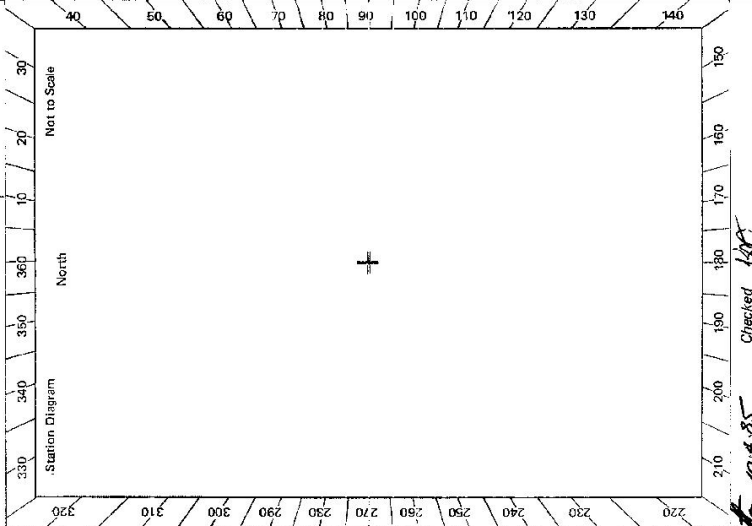

Description: *Note: Cross out word or words which do not apply*


1. Cleared by Janes bearing..... from Trig. Mast
2. Mast & Vanes have been painted white & black respectively.
3. The station/pillar was unpiled/not unpiled/constructed on.....19....., dimensions now being: Description of mark.....should be explicit, e.g., S/Steel Pillar Plate, Steel plug, Brass plug, Bolt, G.I. Pipe Height of mark.....m. ^{above}/_{below} rock/concrete; Mark is.....m. ^{above}/_{below} G.L.
4. A.....m. Diameter of Top Vanes to Top Mark/Pillar plate ...1.190.....m. Diameter of Vanes (vertical). 0.75.....m.
5. A.....m. Diameter of Cairn.....m. Name Plate found/not found/placed.
6. Length of Mast.....m. (approximate if not unpiled)
7. A.....set in conc/rock has been placed/found, bearing.....° M from Mast/Plug/Pillar
8. A.....set in conc/rock has been placed/found, bearing.....° M from Mast/Plug/Pillar
9. A.....set in conc/rock has been placed/found, bearing.....° M from Mast/Plug/Pillar
10. A.....set in conc/rock has been placed/found, bearing.....° M from Mast/Plug/Pillar
8. Action required:.....

STANDPOINT:

Mark	Direction	Horiz. Distance	Height Difference	Mark	Direction	Horiz. Distance	Height Difference
			above standpt.				above standpt.
			below				below
			above standpt.				above standpt.
			below				below
Prepared by: B.M. L. G. M. 1/4/85 Checked: [Signature]

Checked 1/4/85 [Signature]

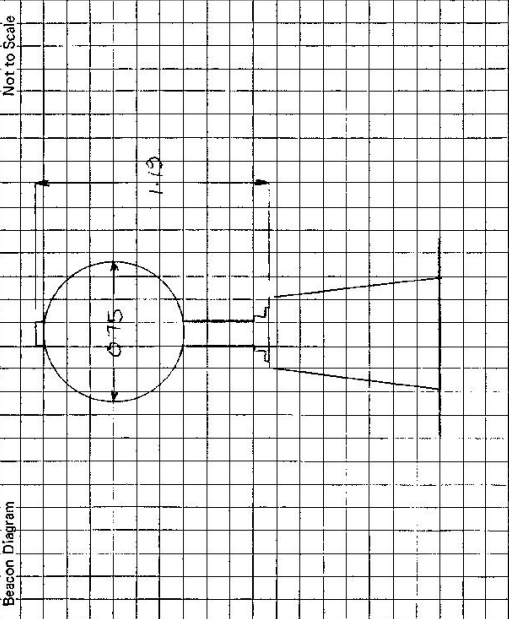ST 2733-2 D. West Government Printer Beacon Diagram	Not to Scale 	STATION CAPE BYRON (P) TS-5932 Owner's Name: Address: Phone: Current Occupant: Address: Phone: ACCESS Access Report of <u>1.2.1985</u> was found suitable/unsuitable.
This section to be completed by officer constructing pillar. Original station mark found/not found. Description of mark: Original beacon found/not found. Description of beacon: Height Top of Vanes to Top Mark:m. Height of mark:m. above G.L. below Diameter of Vanesm. Height of Cairnm. Original Beacon has/has not been destroyed by me.		Date Record of Station