

RECONNAISSANCE and MAINTENANCE REPORT 5-4

STATION HADDISON TS

This Trig. Station has been:-

Note: Cross out word or words which do not apply

1. Completely cleared to permit 360° vision to surrounding Trigs.
2. Cleared by lanes bearing 360° CLEARING IS NEEDED from Trig. Mast
3. Trig. Mast & Vanes have been painted white & black respectively.
4. The Trig. was unpiled/not unpiled, dimensions now being: Original Station Mast 1.00m and Vanes

Description of mark..... should be explicit, e.g. Steel plug, Brass plug, Bolt, G.I. Pipe
 Height of mark..... m above rock/concrete m above G.L.
 Height of Top Vanes to Top Mark..... m. Diameter of Vanes (vertical)..... m.

Height of Cairn..... m. Diameter of Cairn..... m.
 Length of Mast..... m. (approximate if not unpiled)
 5. A..... set in conc/rock has been placed..... m. bearing.....°M from Trig. Mast
 6. A..... set in conc/soil has been placed..... m. bearing.....°M from Trig. Mast
 7. A..... set in conc/soil has been placed..... m. bearing.....°M from Trig. Mast
 8. A..... set in conc/rock has been placed..... m. bearing.....°M from Trig. Mast


9. Connection..... to..... m. bearing.....°M
 10. Connection..... to..... m. bearing.....°M
 11. Connection..... to..... m. bearing.....°M
 12. Connection..... to..... m. bearing.....°M
 13. Diff. Ht. is..... m. above below
 14. Diff. Ht. is..... m. above below
 15. Diff. Ht. is..... m. above below
 16. Diff. Ht. is..... m. above below

Prepared by: Robert Handley Checked: Noted on U.T.M. Card

Co: CUMBERLAND Ph: NARRABEEN.
 Map Sheet: Sydney No: 9130
 Inspected by: R LANDEL Date: 3-8-77
 Authority: C.M.A. Field Book:

Beacon Diagram

Not to Scale

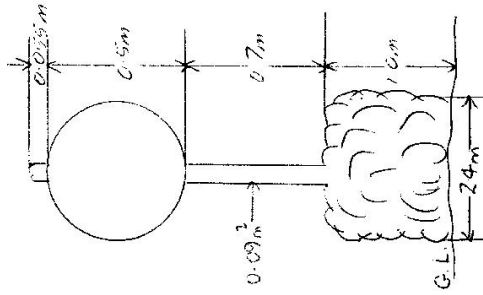

Date: 3-8-77
 Record of Station
 CAIRN IS IN GOOD CONDITION, BUT IS
 ROTTEN VANES HAVE BEEN
 SHUT UP AND NEED REPAIRING
 VISIBILITY IS ZERO, 300° CLEARANCE
 NEEDED.

Non-Geodetic.

