


Department of Lands
 STATION GALORE (P) IS 5944
 Co: URANA Ph: GALORE
 Map Sheet: LOCKHART 1:100000 No: 8227

2/28
 RECONNAISSANCE and MAINTENANCE REPORT
 This Trig. Station has been:-
 Note: Cross out word or words which do not apply

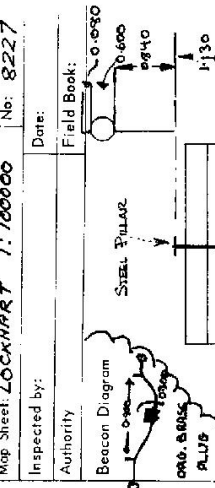

Inspected by:
 Authority:
 Date:
 Field Book:

Note:
 Post and GI Rod Vanes stored at
 LABD BOARD OFFICE WAGGA WAGGA

1. Completely cleared to permit 360° vision to surrounding Trigs.
 2. Cleared by lines bearing 155° m. to 146° m. from Trig. Mast Tower.
 3. Trig. Mast & Vanes have been painted white & black respectively.
 4. The Trig. was unpiled/net-unpiled, dimensions now being:
 Description of mark... STEEL PILLAR on TOWER... should be explicit, e.g. Steel plug, Brass plug, Brass plug, Bolt-Concrete Pillar
 Height of mark... 0.86 m above rock/concrete ... 8.86 m above G.L.
 Height of Top Vanes to ~~Top pillar plate~~ Top pillar plate... 1.520 m Diameter of Vanes (vertical) 0.600 m.
 Height of Cairn... m. Diameter of Cairn... m.
 Length of Mast... m. (approximate if not unpiled)

5. A. Brass hole set in cone/rock has been placed/4 12.314m. bearing 261.471. 50° M from Trig. Mast pillar
 6. A. G. I. Brass set in cone/soil has been placed/4 15.35 m. bearing 133.24. 30° M from Trig. Mast pillar
 7. A. IRON SPIKE set in cone/soil has been placed/4 12.815 m. bearing 189° 34' M from Trig. Mast pillar
 8. A. set in conc/rock has been placed/4 6.205 m. bearing 182.34 M from Trig. Mast pillar
 9. Connection Drill hole to Iron spike... 15.125 m. bearing 55° 22' 30° M
 10. Connection Drill hole to Brass Plug... 14.512 m. bearing 40 M
 11. Connection... 55 M to Brass Plug... 7.073 m. bearing 290 M
 12. Connection... 55 M to Iron spike... 7.121 m. bearing 244° 01' M
 13. Diff. Ht. Brass Plug is 0.142 m. above below
 14. Diff. Ht. Brass Plug is 0.206 m. above below
 15. Diff. Ht. Brass Plug is 0.08 m. above below
 16. Diff. Ht. Brass Plug is 7.66 m. above below

Prepared by: [Signature]
 Checked: [Signature]
 These heights are suspect
 Drill hole in rock
 Iron spike in soil
 Brass Plug

STATION GA E TS 5944

Owners Name.....


Current Occupant.....

Address.....

Address.....

Access.....

Station Diagram
Not to Scale

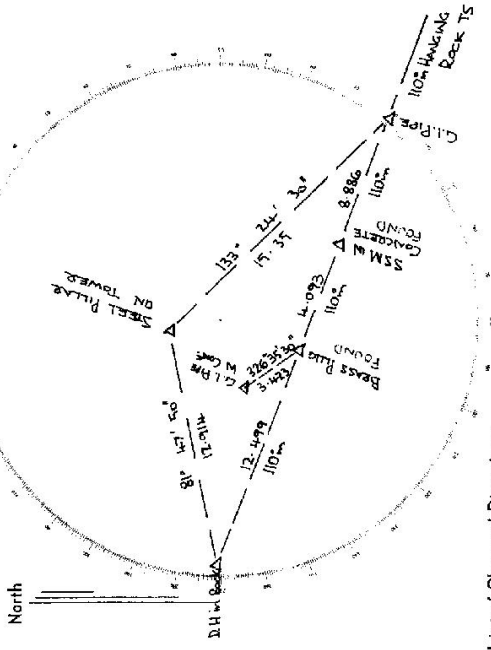

List of Observed Directions:-

Standpoint: Iron Spike		Standpoint: SSM	
Station	Direction	Station	Direction
SSM	00°00'00"	Iron Spike	00°00'00"
Pillar Plate	325°34'12"	D.H in Rock	46°02'12"
D.H in Rock	270°21'38"	TS HANGING ROCK	486°02'12"
Brass Plug	325°24'12"	Brass Plug	66°02'31"
D.H in Rock		Pillar Plate	
Pillar Plate	00°00'00"	TS HANGING ROCK	00°00'00"
Brass Plug	28°10'51"	Iron spike	79°34'48"
SSM	28°10'51"	D.H in rock	151°48'09"
TS HANGING ROCK	28°10'51"		
Iron spike	53°34'40"		


STATION GALORE TOWER TS 5944

Owners Name: **CREWAS HAND** Current Occupant: **---**

Address: **---**
 Address: **---**
 Address: **---**

Access 30-8-1977
 00 km ROCKHARDT PO.
 13-07 TURN RIGHT ON NARBUNGERA RD, ON CRANWATER DR
 15-16 THRU GATE
 15-82 TURN LEFT INTO SUMMIT RD
 18-64 TRIG.
 ALL CONVENTIONAL WHEELS.

Station Diagram Not to Scale

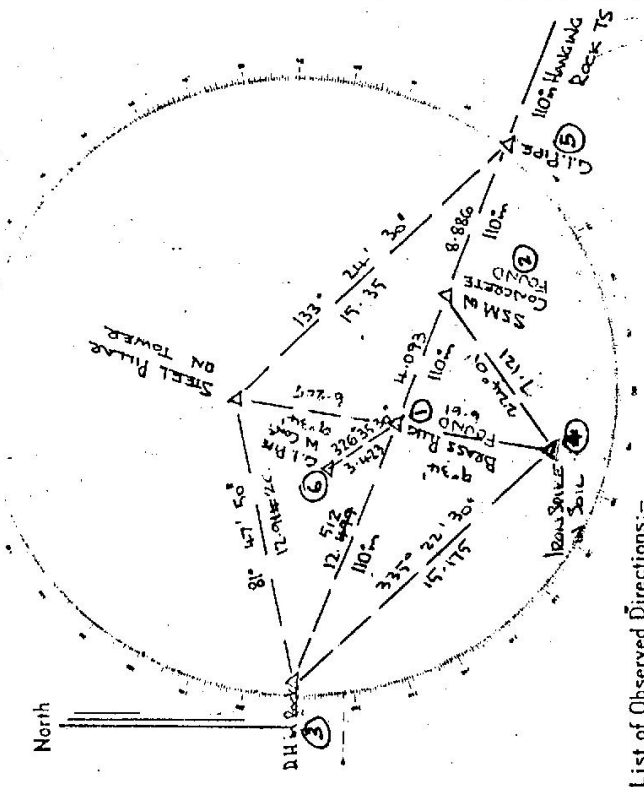

List of Observed Directions:-

Station	Direction	Station	Direction
S.M.	00° 00' 00"	TOWER FOUNDATION	09° 00' 00"
PURAD PLATE	325° 34' 18"	D.H. IN DOCK	66° 02' 27"
D.H. IN DOCK	271° 21' 40"	T.S. HANGING ROCK	146° 02' 12"
T.S. HANGING ROCK	325° 34' 18"	BEARS PUIC	166° 02' 27"
PURAD PLATE	00° 00' 00"	T.S. HANGING ROCK	09° 00' 00"
BEARS PUIC	28° 11' 00"	100m SPIKE	79° 35' 00"
S.M.	28° 11' 00"	D.H. IN DOCK	151° 41' 20"
T.S. HANGING ROCK	28° 11' 00"		
100m SPIKE	53° 34' 40"		

LAND INFORMATION CENTRE

GEODETIC SURVEY OF N.S.M.

GEODETIC STATION RECONNAISSANCE and MAINTENANCE REPORT

STATION: **GALORE (P)** No.: **5944**

MAP SHEET: **JERIDERIE** SCALE 1:250 000

INSPECTED BY: **J. SUTTON** DATE: **10.2.98**

AUTHORITY: **LIC** FIELD BOOK: **-**

Description: **Cleared ~~area~~ 360°** Note: Cross out word or words which do not apply

1. **Mast & Vanes have been painted white & black respectively;**

2. **The ~~stations~~ /pillar was ~~existing~~ /not unplied/ ~~existing~~ on **10th Feb 19.98**, dimensions now being:**

Description of mark: **Direction Pylots** should be explicit, e.g., S/Steel Pillar Plate, Steel plug, Brass plug, Bolt, G.I. Pipe

Height of mark:m. above rock/concrete; Mark is:m. above G.L. **No Spigot**

Height of Top Vanes to Top Mark/Pillar plate:m. Diameter of Vanes (vertical):m.

Height of Cairn:m. Diameter of Cairn:m. Name Plate found/ ~~not found~~ ~~placed~~

Length of Mast:m. (approximate if not unplied)

4. A. **Brass Plug** set in conc/~~rock~~ has been ~~found~~ /found, bearing:° M from ~~Brass Plug~~ /Pillar

5. A. **SSM** set in conc/~~rock~~ has been ~~found~~ /found, bearing:° M from ~~SSM~~ /Pillar

6. A. set in conc/rock has been placed /found, bearing:° M from Mast/Plug/Pillar

7. A. set in conc/rock has been placed /found, bearing:° M from Mast/Plug/Pillar


8. Action required: **Painting of pillars**

STANDPOINT:				STANDPOINT:			
Mark	Direction	Horiz. Distance	Height Difference	Mark	Direction	Horiz. Distance	Height Difference
			above standpt.				above standpt.
			below				below
			above standpt.				above standpt.
			below				below
Prepared by: **J. Sutton** 17.2.98 Checked:

Noted on U.T.M. Card

Checked

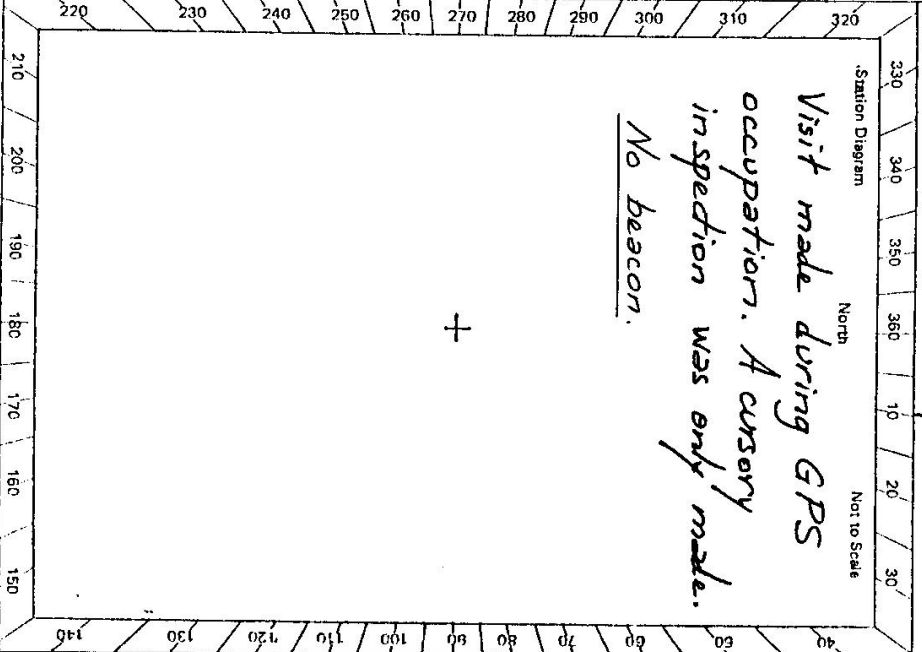

Beacon Diagram Not to Scale This section to be completed by officer constructing pillar. Original station mark found/ not found . Description of mark: Original beacon found/not found. Description of beacon: Height Top of Vanes to Top Markm. Height of mark.....m. above rock/consm. above G.L. below below Diameter of Vanesm. Height of Cairnm. Original Beacon has/has not been destroyed by me.	<table border="1" style="width:100%; border-collapse: collapse;"> <tr> <td style="text-align: center;">STATION</td> <td style="text-align: center;">GALORE (P)</td> </tr> <tr> <td>Owner's Name:</td> <td>Current Occupant:</td> </tr> <tr> <td>Address:</td> <td>Address:</td> </tr> <tr> <td>Phone:</td> <td>Phone:</td> </tr> <tr> <td>Access Report of 30.8.77 30.8.77 was found suitable/unsuitable.</td> <td style="text-align: center;">ACCESS</td> </tr> <tr> <td colspan="2" style="text-align: center;">Date</td> </tr> <tr> <td colspan="2" style="text-align: center;">Record of Station</td> </tr> </table>	STATION	GALORE (P)	Owner's Name:	Current Occupant:	Address:	Address:	Phone:	Phone:	Access Report of 30.8.77 30.8.77 was found suitable/ unsuitable .	ACCESS	Date		Record of Station	
STATION	GALORE (P)														
Owner's Name:	Current Occupant:														
Address:	Address:														
Phone:	Phone:														
Access Report of 30.8.77 30.8.77 was found suitable/ unsuitable .	ACCESS														
Date															
Record of Station															