

STATION GLEESON / PILLAR TS-5948

Owners Name.....
 Current Occupant.....
 Address.....
 Address.....


Access 27-6-1977

COOMA SNOWY MOUNTAINS H254
 M.B.8
 ME BARRTOWS HOUSE
 12.9KM
 MILTON PARK

BEGA P.O. 0.0KM
 take Hwy north towards Narooma
 6.6km turn left onto Cooma (S.M.Hwy) Rd.
 at 12.9km "Milton Park" Rd on right
 at 13.1km turn left into property
 at 13.2 Me Barrtows House
 13.9 through gate
 14.1 through gate
 14.5 through fence
 14.7 past fig tree
 14.9 through gate
 15.0 Trig Station
 (4. W.D in wet)

Not to Scale

Station Diagram
 MAG.
 North

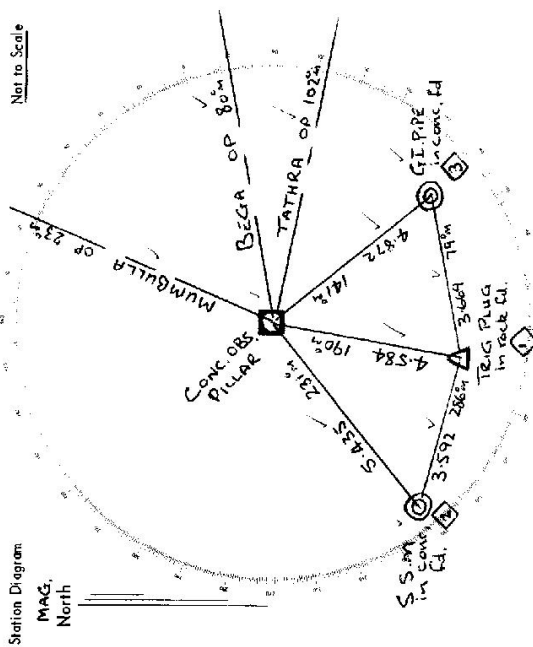

List of Observed Directions:-

Station	Direction	Station	Direction
MUMGULLA TS	0 00 00	MUMGULLA TS	0 00 00
G.I. PIPE in conc. fd.	53 00 33	BEGA OP	55 58 25
BEGA OP	55 57 40	TATHRA OP	11 13 10
TATHRA OP	11 22 40	G.I. PIPE in conc. fd.	116 04 40
S.S.M in conc. fd.	254 16 40	TRIG PLUG in track fd.	161 38 00

Station	Direction	Station	Direction
Conc. Obs. Pillar	341 57 20	S.S.M in conc. fd.	202 37 50

