

CENTRAL MAPPING AUTHORITY

Department of Lands

Trigonometrical Survey of N.S.W.

RECONNAISSANCE and MAINTENANCE REPORT

This Trig. Station has been:-

Note: Cross out word or words which do not apply

1. Completely cleared to permit 360° vision to surrounding ~~Trig~~
2. Cleared by lanes bearing 166° to 215° 291° 343° to 350° from Trig. Mast
 0° to 14° 61° to 74° ✓
3. Trig. Mast & Vanes have been painted white & black respectively.
4. The Trig. was unpiled/~~not unpiled~~, dimensions now being: ~~Original Station Mark found~~

Description of mark 5/Steel Plate should be explicit, e.g. Steel plug, Brass plug, Bolt, G.I. PipeHeight of mark 1.34 m above rock/concrete m below G.L.Height of Top Vanes to Top Mark 1.365 m. Diameter of Vanes (vertical) 0.155 m.Height of Cairn 1.23 m. Diameter of Cairn m.

Length of Mast m. (approximate if not unpiled)

5. A Trig. Peg set in ~~conc/rock~~ has been placed Found 3.812 m. bearing 273° from Trig. Mast Plate
6. A SSM set in ~~conc/rock~~ has been placed Found 6.189 m. bearing 286° from Trig. Mast Plate
7. A set in conc/soil has been placed m. bearing $^{\circ}$ from Trig. Mast
8. A set in conc/rock has been placed m. bearing $^{\circ}$ from Trig. Mast

9. Connection Trig. Peg to SSM 2.671 m. bearing 302° m10. Connection to m. bearing $^{\circ}$ m11. Connection to m. bearing $^{\circ}$ m12. Connection to m. bearing $^{\circ}$ m13. Diff. Ht. Trig. Peg in rock is 1.188 m. Plate14. Diff. Ht. SSM in rock is 1.193 m. Plate

15. Diff. Ht. is m. above below

16. Diff. Ht. is m. above below

Prepared by: Phyllis & H. Bender Checked:

Noted on U.T.M. Card

Checked

74-08

TS 5950

STATION

BELLWOMBRA G.S. (Plate)

Co: ST. VINCENT

Ph: TOMAGA

Map Sheet:

BAYENANS BAY

No: 8926

Inspected by:

P. NAYLOR

Date: 22.10.77


Authority:

C.M.A.

Field Book: O/S35

Beacon Diagram

Not to Scale

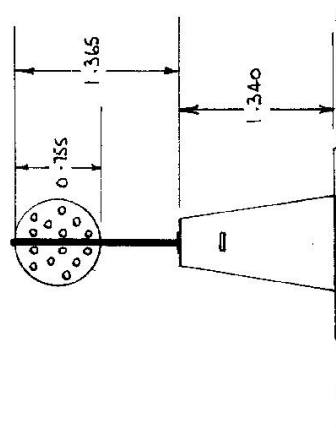


Record of Station

Date 15/10/77 Conc'd. plate established at station.


Owners Name Forestry Commission } SEE
16/6/98
Address Mogo State Forest (AND)
Current Occupant.....
Address.....

Not to Scale

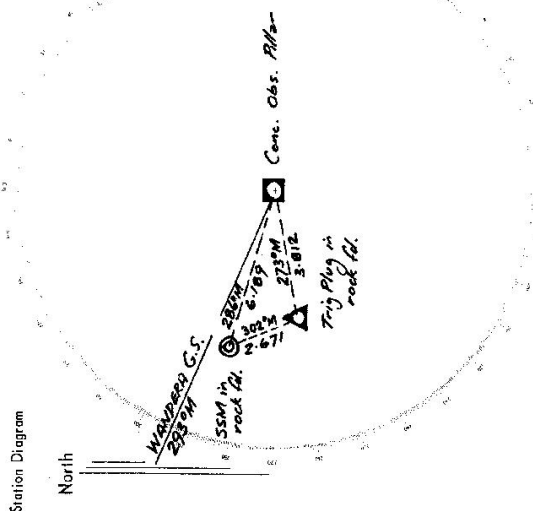

List of Observed Directions:—

Station	Direction	Station	Direction
WANDERA G.S.	0° 00' 00"	WANDERA G.S.	0° 00' 00"
Trig. Ply. in rock fl.	337° 55' 40"	SSM in rock fl.	18° 00' 50"
SSM in rock fl.	352° 16' 10"	Cons. Obs. Pkwy.	157° 50' 20"

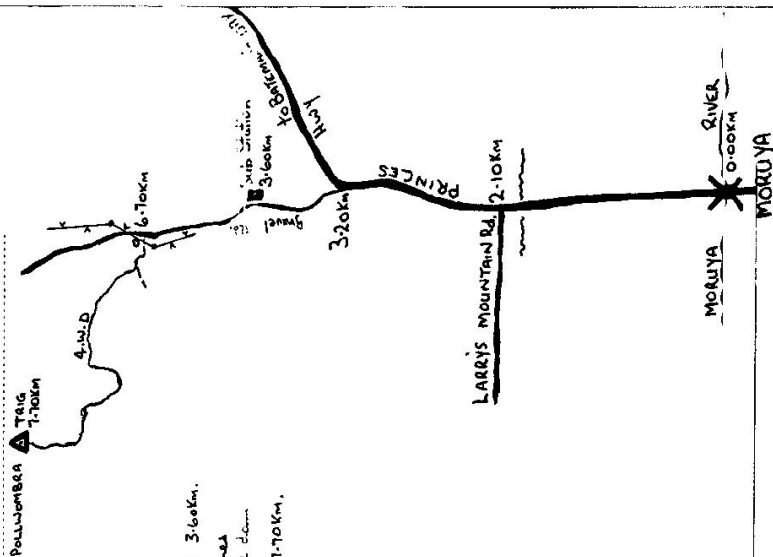[illegible]

Access 22-10-1977
from: Monkey River Bridge 0.00km Travel north along
Pinces Hwy. towards Bateman's Bay, passing
Larry's Mountain Rd. on U.N.S. at 2.10km.
turn left onto gravel ls. at 3.0km.
follow gravel road passing sub. station on R.N.S. at 3.60km.
turn off gravel ls. at 6.70km on U.N.S. power lines
cross the road at this point and there is a small dam
near the road side.
follows track back up ridge to the trig at 7.70km.

CENTRAL MAPPING AUTHORITY

GEODETIC SURVEY OF N.S.W.

GEODETIC STATION RECONNAISSANCE and MAINTENANCE REPORT

Description:

1. Cleared by lanes bearing 70° , 148° , $170^\circ \rightarrow 235^\circ$, 259° , 296° M. ~~exit~~ from Trig. Mast
 Note: Cross out word or words which do not apply
2. Mast & Vanes have been painted white & black respectively.
3. The station/pillar was ~~unplaced~~/not unplaced/~~constructed~~ on ~~10~~ dimensions ~~new~~ being:

Description of mark: ~~S (Steel) Plug~~ S/Steel Pillar Plate, Steel plug, Brass plug, Bolt, G.I. Pipe
 Height of mark: ~~0.1 m~~ above rock/concrete; Mark is ~~0.1 m~~ above G.L.

Height of Top Vanes to Top Mark/Pillar plate m. Diameter of Vanes (vertical) m.

Height of Cairn m. Diameter of Cairn m. Name Plate found/not found/placed.

Length of Mast m. (approximate if not unplaced)

4. A set in conc/rock has been placed/found, bearing ° M from Mast/Plug/Pillar

5. A set in conc/rock has been placed/found, bearing ° M from Mast/Plug/Pillar

6. A set in conc/rock has been placed/found, bearing ° M from Mast/Plug/Pillar

7. A set in conc/rock has been placed/found, bearing ° M from Mast/Plug/Pillar

8. Action required: Clear out lanes 148° , $170^\circ \rightarrow 235^\circ$, 296° m. Sockering only

STANDPOINT:

STANDPOINT:

Mark	Direction	Horiz. Distance	Height Difference	Mark	Direction	Horiz. Distance	Height Difference
			above standpt.				above standpt.
			below				below
			above standpt.				above standpt.
			below				below
Prepared by: *[Signature]*Checked: *[Signature]*Noted on U.T.M. Card *[Signature]*

St 2739-1

STATION: POLLUMBARA		No: 5950	
MAP SHEET SCALE 1:250 000 ULLADULLA			
INSPECTED BY: K HADDON		DATE: 3-2-81	
AUTHORITY: C.M.A		FIELD BOOK: C 59	
330		320	
340		350	
360		370	
380		390	
5940		5950	

NOTE: Name plate reads POLLUMBARA
 Now reads correctly 28/8/81

Light timber

Heavy timber

Heavy timber

STATION

POLLWOMBERA IS 5950

Owner's Name:

Address:

Phone:

Current Occupant:

Address:

Phone:

Access Report of 23/10/1979 was found suitable/unsuitable.

ACCESS

Beacon Diagram

This section to be completed by officer constructing pillar.

Original station mark found/not found.

Description of mark:

Original beacon found/not found.

Description of beacon:

Height Top of Vanes to Top Mark:m.

Height of mark:m. above G.L. below

Diameter of Vanesm. Height of Calmm.

Original Beacon has/not been destroyed by me.

Date

Record of Station

28.0.81

Brass plug gone but drill hole in rock still exists in old position ✓

CENTRAL MAPPING AUTHORITY		GEODETTIC SURVEY OF N.S.W.	
GEODETTIC STATION RECONNAISSANCE and MAINTENANCE REPORT		STATION: POLLWOMBRA (P)	
Description: 1. Cleared by lanes bearing..... <i>Note: Cross out word or words which do not apply</i> 2. Mast & Vanes have been painted white & black respectively. 3. The station/pillar was unpiled/not unpiled/constructed on.....19..... dimensions now being: Description of mark.....should be explicit, e.g., S/Steel Pillar Plate, Steel plug, Brass plug, Bolt, G.I. Pipe Height of mark..... ^{above} _{below} rock/concrete; Mark is..... ^{above} _{below} G.L. Height of Top Vanes to Top Mark/Pillar plate.....m. Diameter of Vanes (vertical).....m. Height of Cairn.....m. Diameter of Cairn.....m. Name Plate found/not found/placed. Length of Mast.....m. (approximate if not unpiled) 4. A.....set in conc/rock has been placed/found, bearing.....°M from Mast/Plug/Pillar 5. A.....set in conc/rock has been placed/found, bearing.....°M from Mast/Plug/Pillar 6. A.....set in conc/rock has been placed/found, bearing.....°M from Mast/Plug/Pillar 7. A.....set in conc/rock has been placed/found, bearing.....°M from Mast/Plug/Pillar 8. Action required:.....		MAP SHEETS SCALE 1:250 000 ULLADULLA INSPECTED BY: A. Siverksen AUTHORITY: CMA FIELD BOOK: 2031 SCALE 1:100 000 BATHYMANS SHOT DATE: Sept 1987	
Prepared by: A. Siverksen		Checked:	

S.O. 1407

STATION

POLLWOMBRA (P) IS 5950

Owner's Name:

Address:

Phone:

Current Occupant:

Address:

Phone:

ACCESS

4WD

Sept 1987

Access Report of...../19.....was found suitable/unsuitable.

0.0

On PRINCES HWY about 3.2 km north of MCGUYA.

Take SHELLEY ROAD into Industrial Park.

0.03

Turn Right

0.30

Pass sub-station on R

2.86

Pass tennis court on R

3.23

Turn L just after power pole where power line crosses road.

3.29

Take R fork

3.34

Track goes to R

3.80

Track goes to L around side of hill

3.98

Turn R up hill

4.30

POLLWOMBRA (P)

Date

Record of Station

Beacon Diagram

Not to Scale

This section to be completed by officer constructing pillar.

Original station mark found/not found.

Description of mark:

Original beacon found/not found.

Description of beacon:

Height Top of Vanes to Top Mark.....m.

Height of mark.....m. above G.L. below

Diameter of Vanes.....m. Height of Calm.....m.

Original Beacon has/has not been destroyed by me.

GEODETTIC STATION RECONNAISSANCE and MAINTENANCE REPORT

Description:

- Description: *Note: Cross out word or words which do not apply*
1. Cleared by lanes bearing, *290° to 298°, 345° to 350°, 70° to 78°*, from Trig. Mast
285° to 290°, 284°, to 291°.
2. Mast & Vanes have been painted white & black respectively. *YES*
3. The ~~station~~/pillar was ~~inspected~~ *INSPECTED* on *16th JUNE* 19*68*, dimensions now being:
- Description of mark, *5 1/2 Pine Ritz*, should be explicit, e.g., S/Steel Pillar Plate, Steel plug, Brass plug, Bolt, G.I. Pipe
- Height of mark, *1.345* m. ^{above} ~~below~~ *level* Mark is *1.345* m. ^{above} ~~below~~ *level* G.L.
- Height of Top Vanes to Top ~~mark~~/Pillar plate *1.60* m. Diameter of Vanes (vertical) *0.755* m.
- Height of Cairn..... m. Diameter of Cairn..... m. Name Plate found/~~not found~~/placed.
- Length of Mast..... m. (approximate if not unplied)
4. *A. Devil Hole*..... set in ~~conc~~/rock has been ~~placed~~/found, bearing, *273* °M from ~~Mast~~/~~Trig~~/Pillar *3810 M*
5. A..... set in conc/rock has been placed/found, bearing..... °M from Mast/Plug/Pillar
6. A..... set in conc/rock has been placed/found, bearing..... °M from Mast/Plug/Pillar
7. A..... set in conc/rock has been placed/found, bearing..... °M from Mast/Plug/Pillar
8. Action required: *PLEASE NOTE: SS.M HAS BEEN DESTROYED.*

STANDPOINT:

Mark	Direction	Horiz. Distance	Height Difference	Mark	Direction	Horiz. Distance	Height Difference
			standpt				above standpt
			below				below
			above				above
			standpt				standpt
			below				below
			above				above
			standpt				standpt
			below				below
			above				above

Prepared by:

Checked: 2/20/08

Noted on U.T.M. Card by ~~W~~

88

Checked

STATION: <i>Bellnembera (2)</i>	No.: <i>5950</i>
MAP SHEETS SCALE 1:250 000 <i>ULLADULLA</i>	SCALE 1:100 000
INSPECTED BY: <i>P.D. 1.10.78</i>	DATE: <i>16/6/88</i>
AUTHORITY: <i>C.M.A</i>	FIELD BOOK: <i>1964</i>

Station Diagram

North

Not to Scale

320 310 300 290 280 270 260 250 240 230 220

40 50 60 70 80 90 100 110 120 130 140

330 340 350 360 370 380 390 400 410 420 430 440

150 160 170 180 190 200 210 220 230 240 250 260

42

Check

GS 24

STATION BELLNOMBRA (P) TS 5950	
<p>Owner's Name: FORESTRY COMMISSION</p> <p>Address: BATEMAN'S BAY</p> <p>Mr. MERV HARRIS DISTRICT FORESTER</p> <p>Phone: 044-776211</p> <p>Current Occupant:</p> <p>Address: SEE BELOW</p> <p>Phone:</p> <p>Access Report of 16/6/1988 was found suitable/unsuitable.</p> <p>ACCESS</p> <p>FEATURE</p> <p>KM</p> <p>0.00 On PRICES HIGHWAY ABOUT 32 KM NORTH OF MORUYA</p> <p>0.03 TAKE SHELLEY ROAD INTO INDUSTRIAL PARK</p> <p>0.03 TURN RIGHT</p> <p>0.30 PASS SUB STATION ON RIGHT</p> <p>2.86 PASS TENNIS COURT ON RIGHT</p> <p>3.23 TURN LEFT JUST AFTER POWER PLE WHERE POWER LINE CROSSES ROAD</p> <p>3.29 TAKE RIGHT FARK</p> <p>3.34 TRACK GOES TO RIGHT</p> <p>3.86 TRACK GOES TO LEFT AROUND SIDE OF HILL</p> <p>3.98 TURN RIGHT UP HILL</p> <p>4.30 BELLNOMBRA (P)</p>	<p>ACCESS LANDOWNER</p> <p>D. DO BRIDGE OVER MURRAY RIVER</p> <p>HIGH MOUNTAIN</p> <p>2.14 LEFT INTO LAURENCE MT. ROAD</p> <p>2.34 LEFT INTO DANK FARM</p> <p>MORUYA 2577</p> <p>LOT 10</p> <p>→ RITA + CLETUS</p> <p>HEFFERNAN</p> <p>PO BOX 77</p> <p>MORUYA 2577</p> <p>LOT 7</p> <p>M. L. MACKAY</p> <p>PO BOX 2772</p> <p>COLD FRUIT</p> <p>MAIL EXCHANGE</p> <p>FORESTRY COMMISSION LAND</p> <p>CONV. PILLAR</p> <p>BELLNOMBRA</p> <p>CORNER PEN 1988</p> <p>1988</p>
<p>section to be completed by officer constructing pillar.</p> <p>nal station mark found/not found.</p> <p>ription of mark:</p> <p>nal beacon found/not found.</p> <p>ription of beacon:</p> <p>it Top of Varies to Top Mark.....m.</p> <p>it of mark.....m. above rock/conc.....m. below G.L.</p> <p>eter of Varies.....m. Height of Cairn.....m.</p> <p>nal Beacon has/not been destroyed by me.</p>	
<p>Not to Scale</p>	
<p>Date</p> <p>Record of Station</p>	