


STATION **TERRA CONSULTANTS TS 5960**

Owners Name... **TERRA CONSULTANTS**
 Current Occupant... **JOHN McGEARIN**
 Address... **EVERGREEN**
 Address... **EVERGREEN**
 Address... **MT. GEORGE**

Access **6-9-1977**

- REMARKS**
- 0-00 MT GEORGE Post Office + Small Tunnel West Mount Monaghan Rd. ✓
 - 6-40 End of Sealed Rd. Over Bridge, Tunnel Left. ✓
 - 6-45 RT House (McGEARIN) First Inclusion Lead Gate ✓
 - 7-00 AT HANDS GO THROUGH 2 Wooded Gates, Cross To-Ground ✓
 - 7-05 CARTEL CROSSING ✓
 - 7-20 " " ✓
 - 7-30 Wooded Gate ✓
 - 7-40 CARTEL CROSSING ✓
 - 7-45 TUNNEL GATE, SMALL CA, THROUGH TUNNEL BUILT IN CONCRETE ✓
 - 8-10 " " ✓
 - 8-25 " " ✓
 - 8-60 " " ✓
 - 8-45 " " ✓
 - 9-00 LET DOWN FENCE ✓
 - LEAVE VEHICLE AT FENCE TO MAKE WORK. ✓

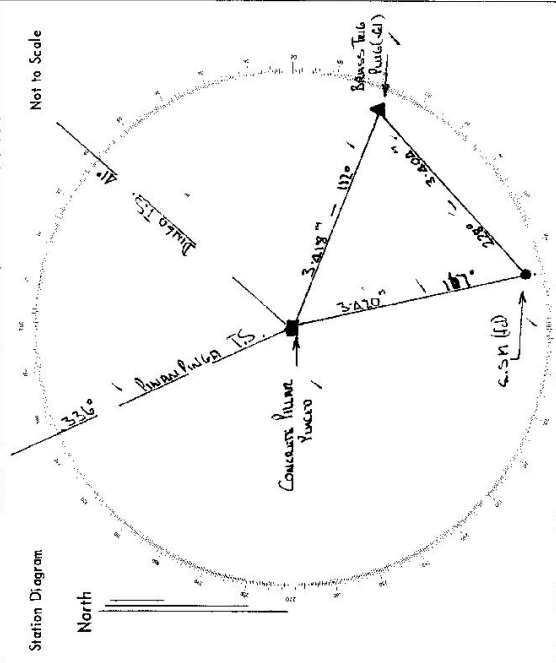

List of Observed Directions:-

Station	Direction	Station	Direction
Dunmurris TS.	9 00 00	Dunmurris TS.	9 00 00
Dunmurris TS.	66 55 50	Dunmurris TS.	66 55 50
Dunmurris TS.	153 46 30	Dunmurris TS.	153 46 30
Dunmurris TS.	193 27 40	Dunmurris TS.	193 27 40

Station	Direction	Station	Direction

