

CENTRAL MAPPING AUTHORITY
Department of Lands

Trigonometrical Survey of N.S.W.

RECONNAISSANCE and MAINTENANCE REPORT

This Trig. Station has been:-

Note: Cross out word or words which do not apply

1. ~~Cleared by lones bearing 20 to 28° at 100 ft. 194 to 144° at 200 ft. 330 to 330 ft from Trig. Mast~~
2. Cleared by lones bearing 20 to 28° at 100 ft. 194 to 144° at 200 ft. 330 to 330 ft from Trig. Mast
3. Trig. Mast & Vanes have been painted white & black respectively. ✓
4. The Trig. was unpiled/~~unpiled~~, dimensions now being:
 - Description of mark: ~~Concrete~~ ~~Observed~~ ~~Block~~ should be explicit, e.g. Steel plug, Brass plug, Bolt, G.I. Pipe
 - Height of mark: 1.35 m above rock/concrete
 - Height of Top Vanes to Top Mark: 1.30 m above G.L.
 - Height of ~~Mark~~ ^{Stone}: 0.16 m Diameter of Cairn: 0.16 m Diameter of Vanes (vertical): 0.15 m.
5. ~~Address~~ ^{From} ~~the~~ ~~set~~ in conc/rock has been placed 7.196 m bearing 209° from Trig. Mast
6. ~~A~~ ^{Concrete} ~~Mark~~ ^{set} in conc/soil has been placed 5.118 m bearing 238° from Trig. Mast
7. ~~A~~ ^{set} in conc/soil has been placed 0 m bearing 0° from Trig. Mast
8. ~~A~~ ^{set} in conc/rock has been placed 0 m bearing 0° from Trig. Mast
9. Connection: ~~Two~~ ~~sets~~ ~~together~~ ~~has~~ ~~been~~ ~~placed~~ 3.43 m bearing 343°
10. Connection: to 0 m bearing 0°
11. Connection: to 0 m bearing 0°
12. Connection: to 1.490 m bearing 0°
13. Diff. Ht. ~~Between~~ ~~the~~ ~~two~~ ~~stations~~ ~~is~~ ~~1.490~~ m. above ~~the~~ ~~lower~~ ~~station~~
14. Diff. Ht. ~~Between~~ ~~the~~ ~~two~~ ~~stations~~ ~~is~~ ~~1.490~~ m. above ~~the~~ ~~lower~~ ~~station~~
15. Diff. Ht. ~~Between~~ ~~the~~ ~~two~~ ~~stations~~ ~~is~~ ~~1.490~~ m. above ~~the~~ ~~lower~~ ~~station~~
16. Diff. Ht. ~~Between~~ ~~the~~ ~~two~~ ~~stations~~ ~~is~~ ~~1.490~~ m. below ~~the~~ ~~lower~~ ~~station~~

Prepared by: K. H. ... Checked: 1/19/77 Noted on U.T.M. Card

STATION: **KIMARRA** **TS** **5961**

Co: **GOVERNMENT**

Map Sheet: **41/1000**

Inspected by: **L. A. ...**

Authority: **L. A. ...**

Beacon Diagram

PH: **KUMDIRAH**

No: **932A**

Date: **10th September 1977**

Field Book: **01651**

Not to Scale

Checked: M. ... 7/10/77

STATION KIWARRIE C.S. HILLAGE TS 5961

Current Occupant:

Address:

Owners Name: Moore, Mervyn

Address:



FOUNDED

Access 10 - 9 - 1977

- REMARKS
- 0.00 Through (D) Tower to Tower - (thouresten Q)
 - 0.70 Tower Hill Sign (thouresten Q)
 - 5.60 Turn Left Sign Hillville
 - 9.65 Turn Right
 - 11.70 Turn Left
 - 12.00 Turn Left Sign (thouresten Q)
 - 18.05 Turn Right
 - 18.20 Turn Right Through Hill Gate
 - 20.10 Tower R.H. Foot
 - 20.80 Hill Gate
 - 21.90
 - 22.50

Geometric Station:

Remarks Note: Direction is Den bearing only as defined
2.00 into 22.50 there is a turn 'STEEP'
Section

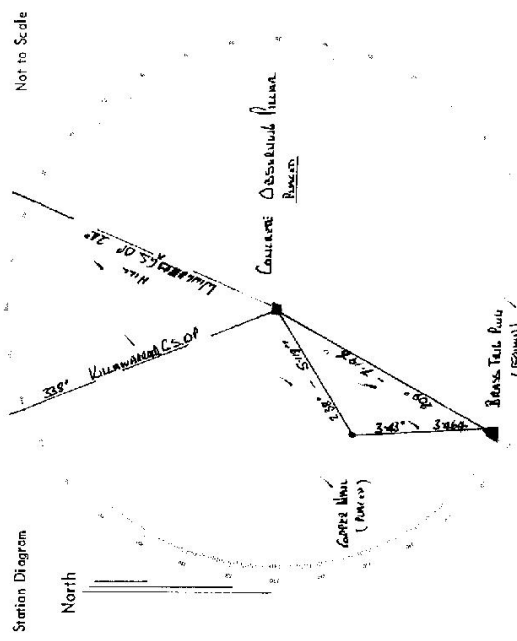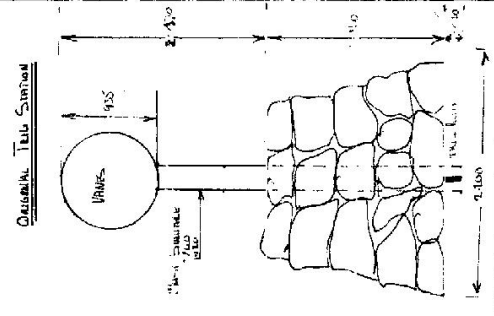

List of Observed Directions:

Station	Direction	Station	Direction
KILLARRIE C.S. OP	0 00 00	KILLARRIE C.S. OP	0 00 00
KILLARRIE C.S. HILLAGE	06 00 00	KILLARRIE C.S. HILLAGE	12 00 00
TOWER HILL SIGN	233 07 00	TOWER HILL SIGN	46 43 00
TOWER R.H. FOOT	259 31 40	TOWER R.H. FOOT	43 02 30

Station	Direction	Station	Direction