



STATION BOENBU 5978

Current Occupant..... FORESTRY COMMISSION

Address..... BULAHDELPHI


Owners Name.....

Address.....

Access 17-10-1977

- 0-00 CONCRETE RD THROUGH SW ROAD MOUNTAIN
- 3-60 TRAIL LEFT SW SW KENNEDY'S CAMP RD
- A-10 WOODEN BRIDGE
- A-10 GRIP
- S-30 TRAIL LEFT AND RIGHT THROUGH BONES TRAIL
- 6-00 TRAIL HIGH SW SW RESERVE TRAIL
- 8-00 TRAIL RIGHT
- 9-10 GEOMETRIC STATION

Station Diagram

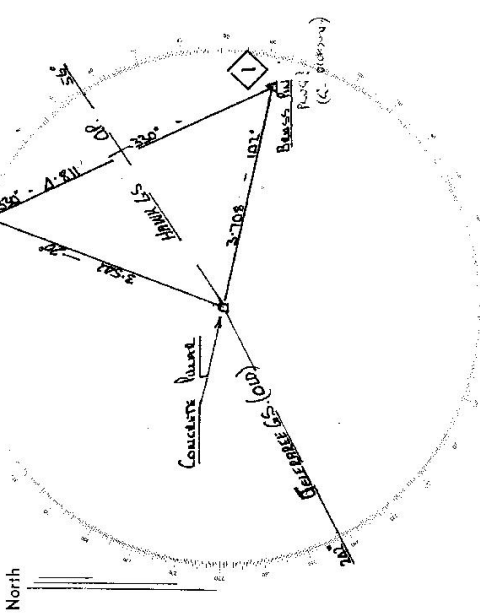

List of Observed Directions:-

Station	Concrete Observed	Direction	Station	Bearing	Dist	Concrete Obs	Direction
HAWK C.S. OP	0	00	KENNY C.S. OP	0	00	0	00
BONES TRAIL OP	45	17	TRAILER C.S. OP	185	20	185	20
TRAILER C.S. OP	185	20	BONES TRAIL	225	10	225	10
CONCRETE ROAD (OLD)	322	09	CONCRETE ROAD (NEW)	322	15	322	15

MEASUREMENTS OF ORIGINAL STATION

- VALUES 0-100
- MINI SQUARE 0-150
- HELMET OR CHALK 0-10
- DIR. OF CHALK 3-000
- TRAILERS TO BONES TRAIL 2-120
- TRAILER OF BONES TRAIL -0-10

Station	Direction	Station	Direction

GEODETIC SURVEY OF N.S.I.W.

CENTRAL MAPPING AUTHORITY


GEODETIC STATION RECONNAISSANCE and MAINTENANCE REPORT

STATION: BREARICK / No.: 5978

MAP SHEET SCALE 1:250 000 NEWCASTLE

INSPECTED BY: C. Parkes DATE: 18-9-81

AUTHORITY: C.M.A. FIELD BOOK: 1923

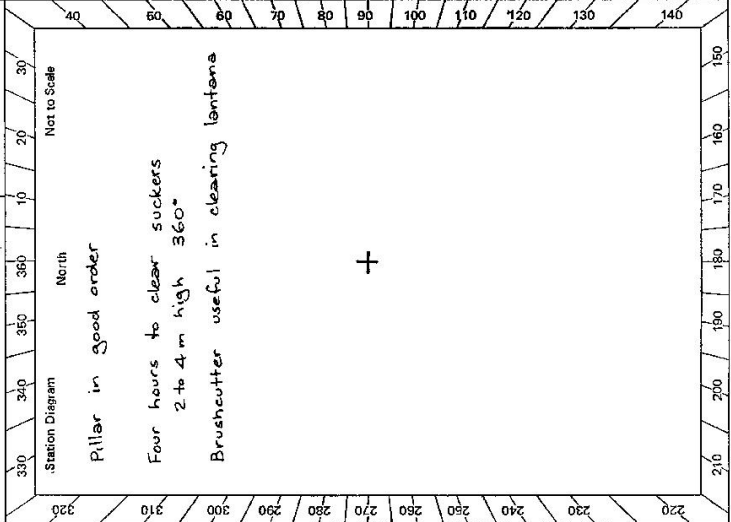

- Description:
- Cleared by lanes bearing..... 317 - 275° M. *Note: Cross out word or words which do not apply*
  - Mast & Vanes have been painted white & black respectively. ✓
  - The station/pillar was unpiled/hot unpiled/constructed on..... 19....., dimensions now being:
    - Description of mark..... should be explicit, e.g., S/Street Pillar Plate, Steel plug, Brass plug, Bolt, G.I. Pipe
    - Height of mark.....m. <sup>above</sup>/<sub>below</sub> rock/concrete: Mark is.....m. <sup>above</sup>/<sub>below</sub> G.L.
    - Height of Top Vanes to Top Mark/Pillar plate.....m. Diameter of Vanes (vertical).....m.
    - Height of Cairn.....m. Diameter of Cairn.....m. Name Plate found/not found/placed.
    - Length of Mast.....m. (approximate if not unpiled)
  - A.....set in conc/rock has been placed/found, bearing.....°M from Mast/Plug/Pillar
  - A.....set in conc/rock has been placed/found, bearing.....°M from Mast/Plug/Pillar
  - A.....set in conc/rock has been placed/found, bearing.....°M from Mast/Plug/Pillar
  - A.....set in conc/rock has been placed/found, bearing.....°M from Mast/Plug/Pillar
  - Action required.....


STANDPOINT:				STANDPOINT:			
Mark	Direction	Horiz. Distance	Height Difference	Mark	Direction	Horiz. Distance	Height Difference
			above standpt.				above standpt.
			below standpt.				below standpt.
			above standpt.				above standpt.
			below standpt.				below standpt.
Prepared by: *KS* Checked: *KS* Noted on U.T.M. Card

St 2735-2 D. West. Government Printer

STATION **BREARICK** 5978

Owner's Name: Francis J. Curran  
 Address: 5410 16th St  
 Phone: 049 - 974206  
 Current Occupant:  
 Address:  
 Phone:  
ACCESS 18-9-81  
 Access Report of 17/10/1977 was found suitable/unsuitable.

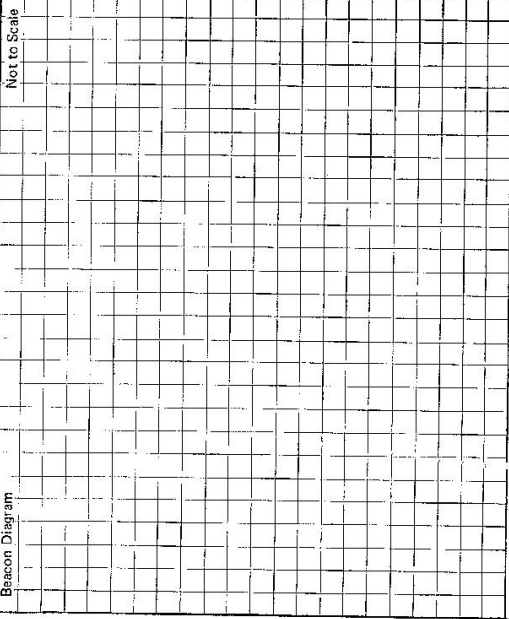

This section to be completed by officer constructing pillar.

Original station mark found/not found.

Description of mark: .....

Original beacon found/not found.

Description of beacon: .....

Height Top of Vanes to Top Mark .....m.

Height of mark .....m. above rock/conc .....m. above G.L.  
 below

Diameter of Vanes .....m. Height of Cairn .....m.

Original Beacon has/has not been destroyed by me.

Date	Record of Station