

74-08

Trigonometrical Survey of N.S.W.

CENTRAL MAPPING AUTHORITY  
Department of Lands

RECONNAISSANCE and MAINTENANCE REPORT

STATION

5981

This Trig. Station has been:-

Note: Cross out word or words which do not apply

1. Completely cleared to permit 360° vision to surrounding triggs.
2. Cleared by lanes bearing.  $112^{\circ} 51' 30''$  to  $58^{\circ} 41' 30''$ ,  $118^{\circ} 10' 30''$  to  $32^{\circ} 35' 30''$  from Trig. Mast
3. Trig. Mast & Vanes have been painted white & black respectively. ✓
4. The Trig. was unpiled/~~not unpiled~~, dimensions now being: Original Station Mark found/~~not found~~


Description of mark..... Concrete..... should be explicit, eg. Steel plug, Brass plug, Bolt, G.I. Pipe  
 Height of mark.....  $1.335$ ..... m above rock/concrete ..... m below G.L.  
 Height of Top Vanes to Top Mark.  $1.435$ ..... m. Diameter of Vanes (vertical):  $2.255$ ..... m.  
 Height of <sup>Signal</sup> Cairn.....  $0.115$ ..... m. Diameter of Cairn..... m.  
 Length of Mast.....  $1.515$ ..... m. (approximate if not unpiled)

5. A Brass ~~W.M.~~ set in conc/rock has been placed  $4.255$ ..... m. bearing.....  $296$ ..... °M from Trig. Mast  
 Pillar  
 Found
6. A Brass ~~W.M.~~ set in conc/soil has been placed  $4.125$ ..... m. bearing.....  $335$ ..... °M from Trig. Mast  
 Pillar  
 Mast
7. A..... set in conc/soil has been placed..... m. bearing..... °M from Trig. Mast
8. A..... set in conc/rock has been placed..... m. bearing..... °M from Trig. Mast  
 ORIGINAL DIMENSIONS

9. Connection Brass ~~W.M.~~ to Signal ~~W.M.~~.....  $2.502$ ..... m. bearing.....  $45$ ..... °M
10. Connection..... to..... m. bearing..... °M
11. Connection..... to..... m. bearing..... °M
12. Connection..... to..... m. bearing..... °M
13. Diff. Ht. Brass ~~W.M.~~ to Signal ~~W.M.~~..... is  $2.602$ ..... m. above below
14. Diff. Ht. Concrete ~~W.M.~~ to Signal ~~W.M.~~..... is  $1.534$ ..... m. above below
15. Diff. Ht. .... is..... m. above below
16. Diff. Ht. .... is..... m. above below

Prepared by: L. R. Hollis Checked: M.L. Morrison Noted on U.T.M. Card

Co: Staunton  
 Map Sheet: BULLMANSIA  
 Inspected by: L.R. Hollis  
 Authority: L.R. Hollis  
 No: 1333  
 Date: 4.7.1962  
 Field Book: 5981

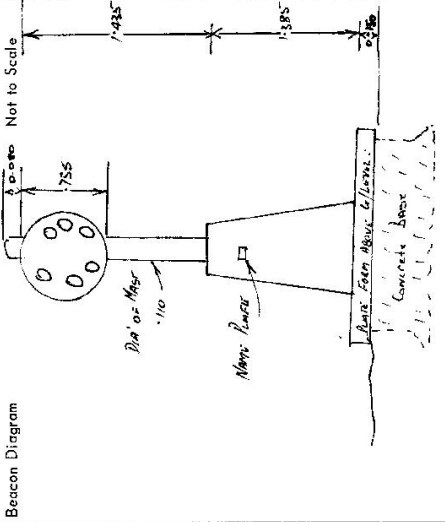

Record of Station

Date

Checked

