

STATION **KYLE ROCK TS 5986**

Owners Name: **D.A.J. MESSYER** Current Occupant: **D.A.J. MESSYER**

Address: **UPPER MYPAL** Address: **UPPER MYPAL**

Via BARRADELAN **Via BARRADELAN**

Access **18-10-1977**

0:00 **GRANDPETER RD TURNING TO TOWARDS TREST**

0:50 **APPL W/IN LINE**

1:00 **TURN RIGHT SIDE W/INDICATED IN BARRADELAN GO**

5:00 **TURN LEFT SIDE W/INDICATED**

31:00 **TURN LEFT AND CROSS BRIDGE (OLD HOUSES TOWARDS THE)**

31:30 **LOOKED BEHIND**

31:45 **TURN LEFT AT HOUSE (JUST BEFORE) ROAD AND SWEEP AS LHS.**

32:30 **TURN RIGHT W/INDICATED**

32:45 **ROAD BRIDGE**

32:50 **TURN LEFT**

33:30 **LOOKED BEHIND AND FOLLOW FRONT TURN UP ROAD**


33:40 **LOOKED BEHIND**

34:30 **GRANDPETER STATION.**

ORIGINAL STATION WAS A DRILL HOLE IN ROCK

NO MARK OR MARKS WERE FOUND.

NEW STATION WAS PLACED DIRECTLY OVER ORIGINAL DRILL HOLE

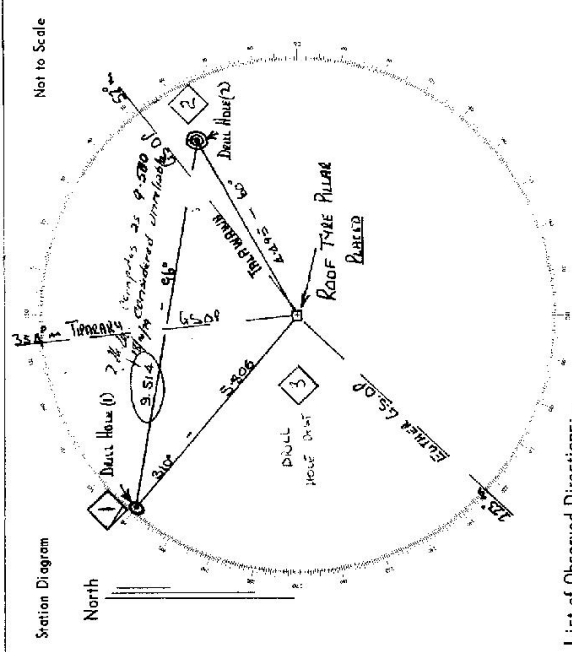

List of Observed Directions:-

Station	Direction	Type Pillar	Standpoint	Drill Hole (1) Azeez	Direction
ENTER 65.00 (Pillar)	0 00 00	TEMPORARY	ENTER 65.00 (Pillar)	0 00 00	0 00 00
DRILL HOLE (1) MARK	85 29 00	TEMPORARY	TEMPORARY G.S. OP	132 25 30	132 25 30
TEMPORARY G.S. OP	132 21 00	TEMPORARY	TEMPORARY G.S. OP	194 34 30	194 34 30
BARRADELAN G.S. OP	194 30 30	TEMPORARY	DRILL HOLE (2) MARK	245 48 58	245 48 58
DRILL HOLE (2)	249 37 00	TEMPORARY	ENTER 65.00	265 39 50	265 39 50
DRILL HOLE IN ROCK (2) (THIS MARK)	0 00 00	TEMPORARY	DRILL HOLE (1) AZEEZ	0 00 00	0 00 00
ENTER 65.00	0 00 00	TEMPORARY	ENTER 65.00	192 25 40	192 25 40
DRILL HOLE IN ROCK (1) (THIS MARK)	132 21 10	TEMPORARY	TEMPORARY G.S.	194 34 40	194 34 40
TEMPORARY PILLAR	194 30 30	TEMPORARY	DRILL HOLE (2)	245 42 10	245 42 10
BARRADELAN PILLAR	249 12 50	TEMPORARY	DRILL HOLE (2) IN ROCK (THIS MARK)	265 49 50	265 49 50

GEODETIC SURVEY OF N.S.W.

CENTRAL MAPPING AUTHORITY

GEODETIC STATION RECONNAISSANCE and MAINTENANCE REPORT

STATION: **KYLE ROCK GS(P)** No.: 5986
 MAP SHEET SCALE 1:250 000 **NEUDCASTLE**
 INSPECTED BY: **P. ROHNER** DATE: **10-7-78**
 AUTHORITY: **CMA** FIELD BOOK: **1630**

Station Diagram
 Not to Scale

Description:

Note: Cross out word or words which do not apply

1. Cleared by lanes bearing..... from Trig. Mast
2. Mast & Vanes have been painted white & black respectively.
3. The station/pillar was unpiled/not unpiled/constructed on..... 19....., dimensions now being:
 Description of mark..... should be explicit, e.g., S/Steel Pillar Plate, Steel plug, Brass plug, Bolt, G.I. Pipe
 Height of mark.....m. ^{above} rock/concrete; Mark is.....m. ^{above} G.L.
 Height of Top Vanes to Top Mark/Pillar plate.....m. Diameter of Vanes (vertical).....m.
 Height of Cairn.....m. Diameter of Cairn.....m. Name Plate found/not found/placed.
 Length of Mast.....m. (approximate if not unpiled)
4. A.....set in conc/rock has been placed/found, bearing.....°M from Mast/Plug/Pillar
5. A.....set in conc/rock has been placed/found, bearing.....°M from Mast/Plug/Pillar
6. A.....set in conc/rock has been placed/found, bearing.....°M from Mast/Plug/Pillar
7. A.....set in conc/rock has been placed/found, bearing.....°M from Mast/Plug/Pillar
8. Action required:.....

STANDPOINT:

Mark	Direction	Horiz. Distance	Height Difference	Work	Direction	Horiz. Distance	Height Difference
			above standpt				above standpt
			below standpt				below standpt
			above standpt				above standpt
			below standpt				below standpt
Prepared by:

Checked:

st-2733-1

Checked

Noted on U.T.M. Card

