
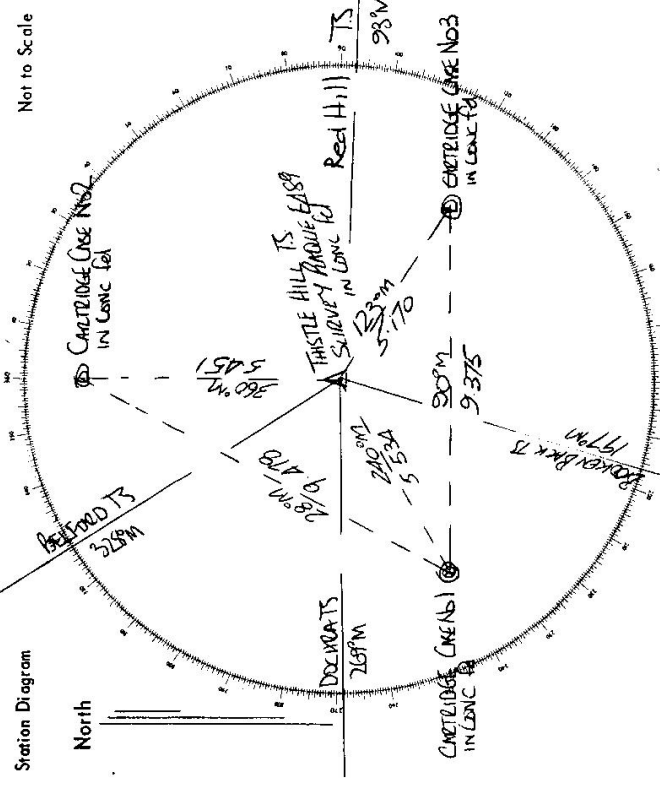


STATION THISTLE (P) 75. 5987

Owners Name.....
 Current Occupant.....
 Address.....
 Address.....

Nov 1975
 CONVENTIONAL VEHICLE (TWO MINUTE WAUK) A WHEEL DRIVE RIGHT TO TELIG.
 From "Cessnock" P.O. 0.0 km Travel North on Highway to
 BRANXTON: AT 14.48 kms. THEN LEFT AND FOLLOW THIS ROAD,
 PASSING TRACK AT LEFT, CONTINUE ON MAIN ROAD TO 21.2 kms
 TRIG APPROX 50 metres on RIGHT.

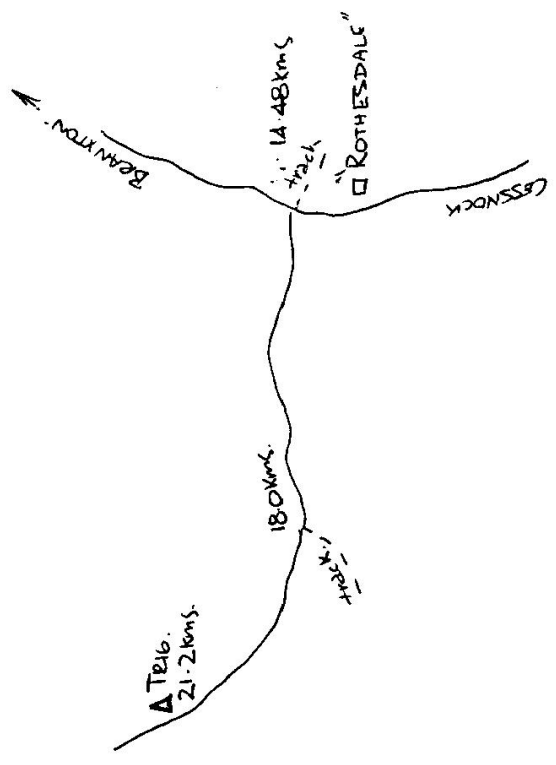


List of Observed Directions:-

Station	Direction	Station	Direction
DOCKHILL TS	359° 57' 60"	BROOKHILL TS	359° 57' 60"
REDFORD TS	57° 29' 18"	CARTIDGE CASE NO.1	89° 52' 49"
RED HILL TS	184° 12' 29.6"	CARTIDGE CASE NO.2	10° 13' 53"
BROOKHILL TS	189° 46' 36.6"	BROOKHILL TS	127° 43' 25.5"
		CARTIDGE CASE NO.3	277° 35' 26.2"
CARTIDGE CASE NO.1		SURVEY RANGE E489	
DOCKHILL TS	359° 57' 60"	REDFORD TS	359° 57' 60"
CARTIDGE CASE NO.2	109° 32' 54"	BROOKHILL TS	80° 06' 19.5"
SURVEY RANGE E489	149° 38' 23"	BROOKHILL TS	33° 23' 26.5"
CARTIDGE CASE NO.3	177° 25' 02"		

Department of Lands
Integral Survey of N.S.W.
RECONNAISSANCE and MAINTENANCE REPORT 5194

STATION **THISTLE** (P) **TS 5987**
 Co: **NORTHERN RIVERLAND** Ph: **KATH BURROWS**
 Map Sheet: **4000000 1:50000** No:
 Inspected by: **P. M. C. HEATH** Date: **2.7.22 G.L. 0.75**
 Authority: **I.S.D. NOLE** Field Book: **DPB 328**
 Beacon Diagram: **Not to Scale**

This Trig. Station has been:-
 Note: Cross out word or words which do not apply
 1. Completely cleared to permit 360° vision to surrounding Trigs. ✓
 2. ~~Cleared by fence-bearing~~
 3. Trig. Mast & Vanes have been painted white & black respectively. ✓
 4. The Trig. was unpiled/~~not unpiled~~, dimensions now being:
 Description of mark: **Concrete Pillar** should be explicit, e.g. Steel plug, Brass plug, Bally Concrete Pillar
 Height of mark: **1.47** m above **rock/concrete** **1.4** m above **G.L.**
 Height of Top Vanes to ~~Top Mast~~/Top pillar plate: **1.45** m Diameter of Vanes (vertical) **0.6** m.
 Height of Cairn: **1.4** m. Diameter of Cairn: **33/55**
 Length of Mast: **1.51** m. (~~approximate to not unpiled~~)

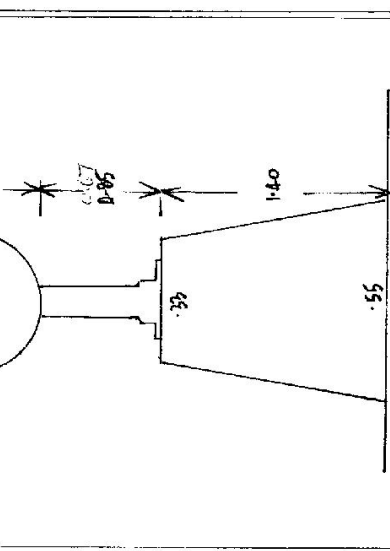

5. A. S. S. Pin set in conc./rock has been placed/rd **6.615** m, bearing **237** °M from Trig. Mast/pillar
6. ~~Cartridge Case~~ ① set in conc./soil has been placed/rd **12.146** m, bearing **238** °M from Trig. Mast/pillar
7. ~~Cartridge Case~~ ② set in conc./soil has been placed/rd **5.936** m, bearing **288** °M from Trig. Mast/pillar
8. ~~Cartridge Case~~ ③ set in conc./rock has been placed/rd **6.052** m, bearing **189** °M from Trig. Mast/pillar
9. Connection ~~SS Pin~~ to ①: **5.534** m, bearing **239** °M
10. Connection ~~SS Pin~~ to ②: **5.442** m, bearing **360** °M
11. Connection ~~SS Pin~~ to ③: **5.168** m, bearing **17** °M
12. Connection: to m, bearing °M
13. Diff. Ht. ~~Rd. Plate~~ is **1.300** m above **S.S. Pin**
14. Diff. Ht. ~~Pillar Stake~~ is **1.654** m above ~~Cartridge Case ①~~
15. Diff. Ht. ~~Pillar Stake~~ is **1.495** m above **②**
16. Diff. Ht. ~~Pillar Stake~~ is **1.638** m above **③**

Date	Record of Station
16.3.76	Pillar erected
7.1.1971	Main Mast & Vanes REBUILT

Prepared by: **AKB** Checked: **Allan Burrows**

CENTRAL MAPPING AUTHORITY

GEODETTIC SURVEY OF N.S.W.

GEODETTIC STATION RECONNAISSANCE and MAINTENANCE REPORT

Description:

Note: Cross out word or words which do not apply

1. Cleared by lanes bearing..... from Trig. Mast
2. Mast & Vanes have been painted white & black respectively.
3. The station/pillar was unpilled/not unpilled/constructed on.....19....., dimensions now being:
Description of mark.....should be explicit, e.g., S/Steel Pillar Plate, Steel plug, Brass plug, Bolt, G.I. Pipe
Height of mark.....m. above rock/concrete; Mark is.....m. above G.L.
Height of Top Vanes to Top Mark/Pillar plate.....m. Diameter of Vanes (vertical).....m.
Height of Cairn.....m. Diameter of Cairn.....m. Name Plate found/not found/placed.
Length of Mast.....m. (approximate if not unpilled)
4. A.....set in cone/rock has been placed/found, bearing.....°M from Mast/Plug/Pillar
5. A.....set in cone/rock has been placed/found, bearing.....°M from Mast/Plug/Pillar
6. A.....set in cone/rock has been placed/found, bearing.....°M from Mast/Plug/Pillar
7. A.....set in cone/rock has been placed/found, bearing.....°M from Mast/Plug/Pillar

8. Action required: Repair concrete pillar. Pillar plate still stable, but part of pillar has been demolished. Replace vanes & mast.

STANDPOINT:

Mark	Direction	Horiz. Distance	Height Difference	Mark	Direction	Horiz. Distance	Height Difference
			above standpt.				above standpt.
			below				below
			above standpt.				above standpt.
			below				below
Prepared by: *M. Roberts* Checked: *W. Jackson 7/17/19* Noted on U.T.M. Card

SI 2733-1

STATION: **THISTLE GSOP** No.: **5987**

MAP SHEET **SINGLETON**

INSPECTED BY: **N KRAHE** DATE: **18-7-79**

AUTHORITY: **C.M.A.** ANGLE BOOK: **1607/98**

North

Station Diagram

Not to Scale

+

Repair pillar
Replace mast & vanes.

(N.B. The condition of this station is known. Owner is implacably resistant to erection of mast & vanes & exists efforts to repair station have resulted in their destruction.)

Checked

