

RECONNAISSANCE and MAINTENANCE REPORT

STATION WINEY CREEK TS 6025

This Trig. Station has been:-

Note: Cross out word or words which do not apply

1. Completely cleared to permit 360° vision to surrounding Trigs.
2. Cleared by lances bearing..... from Trig. Mast
3. Trig. Mast & Vanes have been painted white & black respectively.
4. The Trig. was unpiled/not unpiled, dimensions now being: ~~Crossed out station mark found (not found)~~
should be explicit, e.g. Steel plug, Brass plug, Bolt, G.I. Pipe

Description of mark..... m ^{above} / _{below} rock/concrete m ^{above} / _{below} G.L.

Height of Top Vanes to Top Mark..... m. Diameter of Cairn..... m. Diameter of Vanes (vertical)..... m.

Height of Cairn..... m. (approximate if not unpiled)

5. A..... set in conc/rock has been placed..... m. bearing.....°M from Trig. Mast
6. A..... set in conc/soil has been placed..... m. bearing.....°M from Trig. Mast
7. A..... set in conc/soil has been placed..... m. bearing.....°M from Trig. Mast
8. A..... set in conc/rock has been placed..... m. bearing.....°M from Trig. Mast

9. Connection..... to..... m. bearing.....°M

10. Connection..... to..... m. bearing.....°M

11. Connection..... to..... m. bearing.....°M

12. Connection..... to..... m. bearing.....°M

13. Diff. Ht. is..... m. ^{above} / _{below}

14. Diff. Ht. is..... m. ^{above} / _{below}

15. Diff. Ht. is..... m. ^{above} / _{below}

16. Diff. Ht. is..... m. ^{above} / _{below}

Prepared by: P. CHEN Checked: Noted on U.T.M. Card

Co: BLONDINGTON Ph: A.A. COYLE GRANT

Map Sheet: PORT STEPHENS No: 4332 N

Inspected by: P. CHEN Date: 19/11/77

Authority: C.M.A. Field Book: 1565

Beacon Diagram: Not to Scale

Date: _____ Record of Station

N/L

STATION VINEY CREEK TS 6025


Owners Name.....
 Current Occupant.....
 Address.....
 Address.....

Access 19-4-1977

FEATURES

- 0.0 ✓ SOUTH END OF BRIDGE ACROSS KANGAH RIVER IN PACIFIC HUNY HEAD TOWARDS BULANDE LAH. ✓
- 2.6 ✓ T-INTERSECTION, MILL ROAD ON RIGHT ✓
- 3.1 ✓ CROSS BULGA CREEK ✓
- 8.3 ✓ CROSS 'BUNDABAH' CREEK ✓
- 8.6 ✓ TURN LEFT ONTO DIRT TRACK JUST BEFORE TEA GARDENS & HAWKS NEST TURN OFF. ✓
- 11.8 ✓ TRIG. ✓

Station Diagram Not to Scale

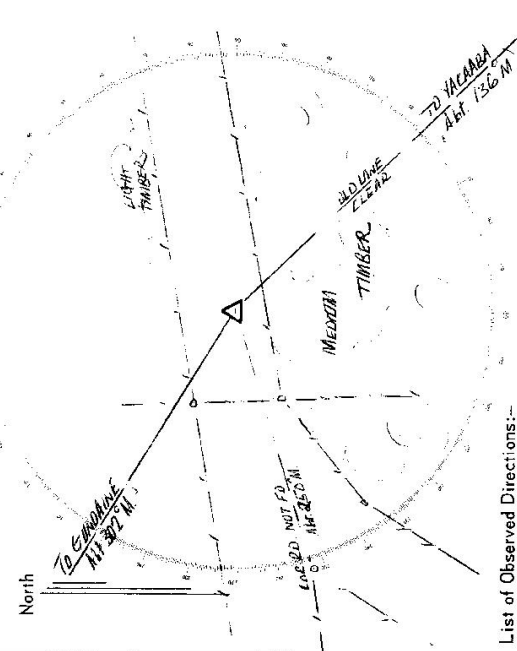

List of Observed Directions:--

Standpoint:	
Station	Direction
Standpoint:	
Station	Direction

7.4.98

TRIGONOMETRICAL SURVEY OF N.S.W.

CENTRAL MAPPING AUTHORITY

Department of Lands

RECONNAISSANCE and MAINTENANCE REPORT

STATION VINEY TS 6025

This Trig. Station has been:-

Note: Cross out word or words which do not apply

Co: BLOUCESTER Ph: A.A. COY'S GRANT
 Map Sheet: BART STEPHENS No: 9332
 Inspected by: M.L. MORRISON Date: 2/10/77
 Authority: Field Book: 1561

Beacon Diagram: Not to Scale

- 1. Completely cleared to permit 360° vision to surrounding Trigs.
- 2. Cleared by Vane bearing
- 3. Trig/Mast & Vanes have been painted white & black respectively.
- 4. The Trig. was unpiled/~~not emptied~~, dimensions now being: from Trig. Mast

Description of mark: should be explicit, e.g. Steel plug, Brass plug, Bolt, G.I. Pipe
 Height of mark: m above / m below rock/concrete G.L.
 Height of Top Vanes to Top Mark: m. Diameter of Vanes (vertical) m.
 Height of Cairn: m. Diameter of Cairn: m.
 Length of Mast: m. (approximate if not unpiled)
 5. A set in conc/rock has been placed m. bearing °M from Trig. Mast
 6. A set in conc/soil has been placed m. bearing °M from Trig. Mast
 7. A set in conc/soil has been placed m. bearing °M from Trig. Mast
 8. A set in conc/rock has been placed m. bearing °M from Trig. Mast
 9. Connection: to : m. bearing °M
 10. Connection: to : m. bearing °M
 11. Connection: to : m. bearing °M
 12. Connection: to : m. bearing °M
 13. Diff. Ht. is m. above / m. below
 14. Diff. Ht. is m. above / m. below
 15. Diff. Ht. is m. above / m. below
 16. Diff. Ht. is m. above / m. below

Date	Record of Station
	<u>TRIG NOT FOUND. OLD TRIG (BASTARDLY TRIG MARKER) AND TREE GROWING NEXT TO IT AND A ROOT HAS GROWN STRAIGHT UNDER IT. WILL VERY EASY TO LOSE (BUT A LOT OF BRACKEN WARRER) TRIG SITE IS ON THE AREA OF LAND IN A FENCED ROAD</u>

Noted on U.T.M. Cord

Checked:

Prepared by:

Checked:


7409

CENTRAL MAPPING AUTHORITY
Department of Lands
Trigonometrical Survey of N.S.W.
RECONNAISSANCE and MAINTENANCE REPORT

STATION - VINEY Pillar 15 6025
 Co: GLoucester Ph: A. A. Coys GRAVIT
 Map Sheet: PORT STEPHENS No: 4332
 Inspected by: W. M. GILLIBRAY Date: 9-2-78
 Authority: CMA Field Book: 1406

This Trig. Station has been: -
 Note: Cross out word or words which do not apply

1. Completely cleared to permit 360° vision to surrounding Trigs. -
2. Cleared by lanes bearing..... from Trig. Mast
3. Trig. Mast & Vanes have been painted white & black respectively.
4. The Trig. was unpiled/not unpiled, dimensions now being:
- Description of mark: CONC. OSS. Pillar..... should be explicit, e.g. Steel plug, Brass plug, Bolt, G.I. Pipe
- Height of mark: 0.015 m above rock/concrete..... m above G.L. below
- Height of Top Vanes to Top Mark: 1.468 m. Diameter of Vanes (vertical) 0.750 m.
- Height of Cairn: 1.355 m. Diameter of Cairn..... m.
- Length of Mast: 1.548 m. (approximate if not unpiled)
5. CONC. P. PL. set in conc/rock has been placed 2.367 m. bearing 342 °M from Trig. Mast. Pillar
6. CONC. NAIL set in conc/rock has been placed 2.657 m. bearing 225 °M from Trig. Mast. Pillar
7. A..... set in conc/soil has been placed..... m. bearing..... °M from Trig. Mast
8. A..... set in conc/rock has been placed..... m. bearing..... °M from Trig. Mast
9. Connection CONC. NAIL to G.P. PL...... is 4.271 m. bearing 15 °M
10. Connection..... to..... is..... m. bearing..... °M
11. Connection..... to..... is..... m. bearing..... °M
12. Connection..... to..... is..... m. bearing..... °M
13. Diff. Ht. G.P. PL...... is 1.371 m. above Pillar..... Plate..... below
14. Diff. Ht. CONC. NAIL..... is 1.600 m. above Pillar..... Plate..... below
15. Diff. Ht. CONC. NAIL..... is 0.123 m. above G.I. P. PL...... below
16. Diff. Ht. is..... m. above..... below.....

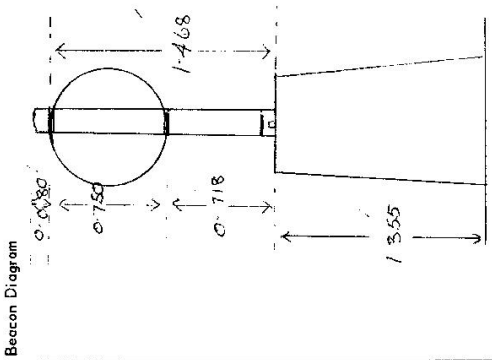

Date	Record of Station

Prepared by: A. Coys Checked: W. M. Gillibray Noted on U.T.M. Cord

STATION VINEY TS 6025


Owners Name: Current Occupant:

Address: Address:

Access: FOUND SUITABLE.

Not to Scale

Station Diagram

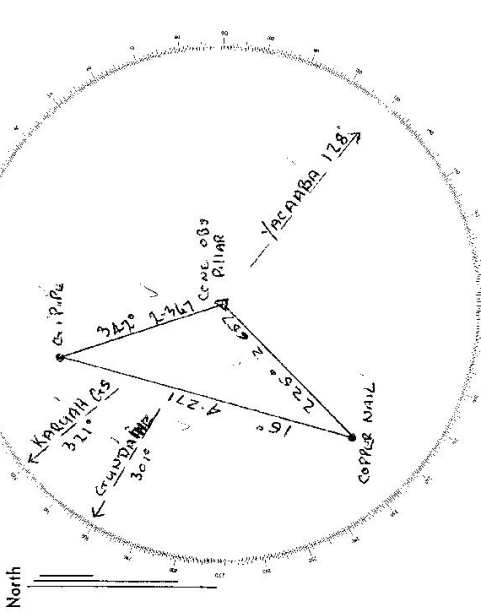

List of Observed Directions:-

Standpoint: LOC OBS PILLAR Standpoint: G.I. PILE


Station	Direction	Station	Direction
<u>GUNDA PILLAR</u>	<u>359.59.60</u>	<u>KARUMAH PILLAR</u>	<u>359.59.60</u>
<u>G.I. PILE</u>	<u>39.74.15</u>	<u>COPPER NAIL</u>	<u>253.07.10</u>
<u>KARUMAH PILLAR</u>	<u>279.54.35</u>	<u>KARUMAH PILLAR</u>	<u>279.54.40</u>
<u>COPPER NAIL</u>	<u>282.49.10</u>	<u>PILLAR SARGOT</u>	<u>277.16.40</u>
.....
.....
.....
.....

STATION VINEY TS 6025

Owners Name.....
 Current Occupant.....
 Address.....
 Address.....

Access 21/10/1977
 Direction
0.00 ON PACIFIC HWY AT INTERSECTION TO TEAGARDENS HEAD NTH TOWARDS BULMDELAH.
3.10 TURN LEFT OFF HWY UP TRACK (AT END OF PINE FOREST)
3.15 IRON GATE
3.90 GO STRAIGHT AHEAD
5.05 STRAIGHT AHEAD THROUGH WIRE GATE.
5.30 TRIG SITE (POST NEXT TO TREE (BOSIBLY ORIGINAL POSITION) ON LEFT BEFORE WIRE GATE.

Station Diagram

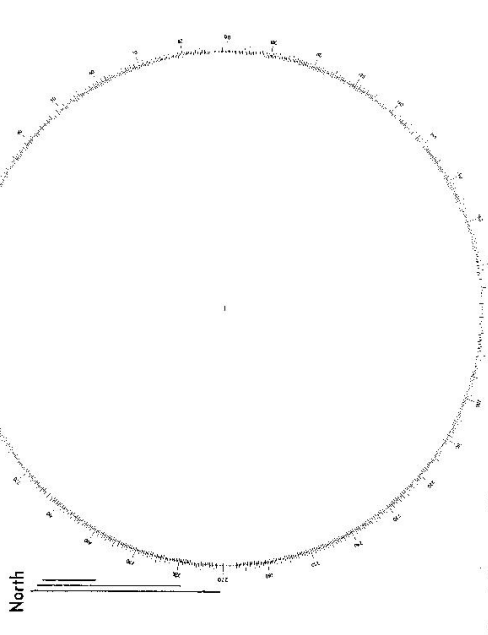

List of Observed Directions:-

Station:		Standpoint:	
Station	Direction	Station	Direction