

CENTRAL MAPPING AUTHORITY
Department of Lands

Trigonometrical Survey of N.S.W.

RECONNAISSANCE and MAINTENANCE REPORT

This Trig. Station has been:-

Note: Cross out word or words which do not apply

1. Completely cleared to permit 360° vision to surrounding Trigs.
2. Cleared by lances bearing 165° to 195° N. from Trig. Mast Pillar.
3. Trig. Mast & Vanes have been painted white & black respectively.
4. The Trig. was unpiled/~~not~~unpiled, dimensions now being: Original Station Mark ~~found~~ / not found

Description of mark..... CONCRETE PILLAR..... should be explicit, e.g. Steel plug, Brass plug, Belt, G.I. Pipe
 Height of mark..... 1.380 m..... above below..... rock/concrete..... m..... above below..... G.L.
 Height of Top Vanes to Top Mark..... 1.330 m..... Diameter of Vanes (vertical)..... 0.600 m.
 Height of Cairn..... m..... Diameter of Cairn..... m.

5. A G.I. Pipe... set in conc/rock has been placed..... 4.514 m, bearing..... 143.....°M from Trig. Mast Pillar
6. A BRASS A... set in conc/soil has been placed..... 5.771 m, bearing..... 172.....°M from Trig. Mast Pillar
7. A..... set in conc/soil has been placed..... m, bearing.....°M from Trig. Mast
8. A..... set in conc/rock has been placed..... m, bearing.....°M from Trig. Mast

9. Connection G.I. Pipe to BRASS A : 2.183 m, bearing..... 76.....°M
10. Connection PILLAR to G.I. P.P. 1 : 15.485 m, bearing..... 228.....°M
11. Connection PILLAR to G.I. P.P. 2 : 19.060 m, bearing..... 108.....°M

12. Connection..... to..... m, bearing.....°M
13. Diff. Ht. PILLAR is 0.102 m, above below..... G.I. PIPE
14. Diff. Ht. PILLAR is 1.046 m, above below..... BRASS A
15. Diff. Ht. PILLAR is 4.775 m, above below..... G.I. P.P. 1
16. Diff. Ht. PILLAR is 4.741 m, above below..... G.I. P.P. 2


Prepared by: *[Signature]* Checked: *[Signature]*

Noted on U.T.M. Card

TS 6045

STATION (775) POMINGALARA NA PILLAR.
 Co: MITCHELL PH: URANGUINITY
 Map Sheet: WAGGA WAGGA No: 8327
 Inspected by: J. J. EGGLSTON Date: 5/10/77
 Authority: WAGGA LANDS DEPT. Field Book: 77/72

Beacon Diagram

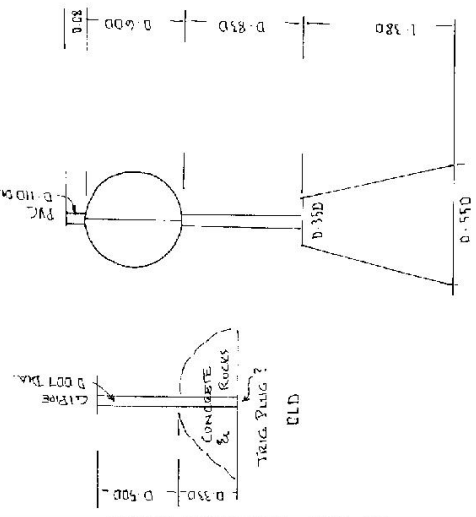

Date	Record of Station
	0.550 NEW

Checked

STATION POMINGALARNA (P) TS 6045


Owners Name: KAPOOKA MILITARY ESTABLISHMENT Current Occupant:

Address:

Access 5-10-1977

- 0.00 Km KAPOOKA TURN-OFF ON OLYMPIC WAY, ONTO KAPOOKA DRIVE
- 1.32 GUARD HOUSE
- 2.30 H. Q. (GET KEY)
- 3.10 TURN RIGHT ONTO GRAVEL ROAD, OFF KAPOOKA DRIVE
- 3.70 LOCKED GATE INTO DANGER AREA
- 5.00 TRIG.

NOTE: TRIG. CANNOT BE OCCUPIED WHILE RANGE IS IN USE.

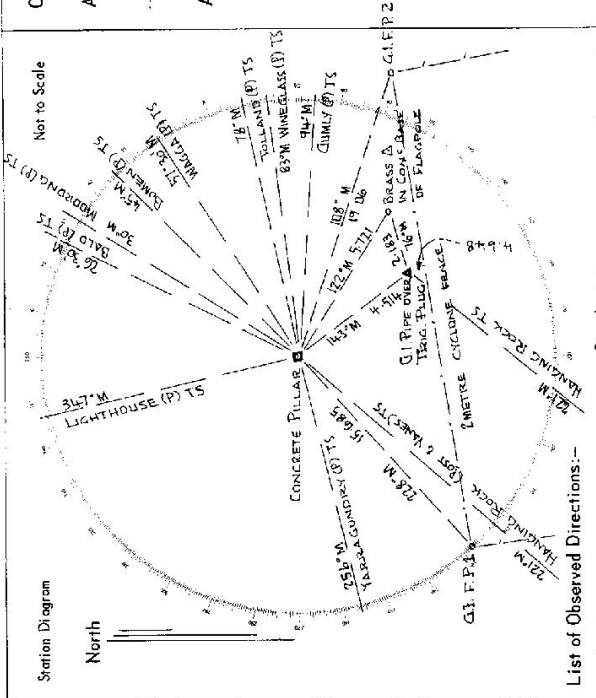

List of Observed Directions:-

Standpoint: CONCRETE PILLAR		Standpoint: TRIG. PLUG (G.I.P.P2)	
Station	Direction	Station	Direction
HANGING ROCK TS	0° 00' 00"	HANGING ROCK TS	0° 00' 00"
G.I.P.P.	7° 14' 19"	G.I.P.P. POST	75° 36' 30"
MUDDONG (P) TS	110° 56' 40"	CONCRETE PILLAR	102° 08' 10"
S.I.F.P.	241° 31' 20"	BRASS A	244° 32' 40"
BRASS A	267° 25' 40"	G.I.P.P. POST	238° 00' 50"
TRIG PLUG (G.I.P.P1)	782° 10' 10"		
Station	Direction	Station	Direction

GEODETTIC SURVEY OF N.S.W.

CENTRAL MAPPING AUTHORITY

GEODETTIC STATION RECONNAISSANCE and MAINTENANCE REPORT

Description:

1. Cleared by lanes bearing..... Note: Cross out word or words which do not apply
 2. Mast & Vanes have been painted white & black respectively.
 3. The station/pillar was unpiled/not unpiled/constructed on.....19....., dimensions now being:
 Description of mark..... should be explicit, e.g., S/Steel Pillar Plate, Steel plug, Brass plug, Bolt, G.I. Pipe
 Height of mark.....m. above rock/concrete; Mark is.....m. above G.L.
 Height of Top Vanes to Top Mark/Pillar plate.....m. Diameter of Vanes (vertical).....m.
 Height of Cairn.....m. Diameter of Cairn.....m. Name Plate found/not found/placed.
 Length of Mast.....m. (approximate if not unpiled)

- 4. A.....set in conc/rock has been placed/found, bearing.....° M from Mast/Plug/Pillar
- 5. A.....set in conc/rock has been placed/found, bearing.....° M from Mast/Plug/Pillar
- 6. A.....set in conc/rock has been placed/found, bearing.....° M from Mast/Plug/Pillar
- 7. A.....set in conc/rock has been placed/found, bearing.....° M from Mast/Plug/Pillar
- 8. Action required:.....

STANDPOINT:

Mark	Direction	Horiz. Distance	Height Difference	Mark	Direction	Horiz. Distance	Height Difference
			above standpt				above standpt
			below				below
			above standpt				above standpt
			below				below
Prepared by:

Checked:

Noted on U.T.M. Grid

STATION: **POMINGALARNA (P)** No.: **TS 6045**

MAP SHEETS SCALE 1:250 000 **WAGGA WAGGA** SCALE 1:100 000

INSPECTED BY: **C. FORD** DATE: **2-9-87**

AUTHORITY: **C. M. A.** FIELD BOOK:

Station Diagram

Not to Scale

Checked: **[Signature]**

