

CENTRAL MAPPING AUTHORITY

GEODETIC SURVEY OF NSW
 GEODETIC STATION RECONNAISSANCE and MAINTENANCE REPORT

Description: *Note: Cross out word or words which do not apply*

1. Cleared by lanes bearing..... from Trig, Mast
2. Mast & Vanes have been painted white & black respectively.
3. The station/pillar was unpainted/not unpainted/constructed on.....19....., dimensions now being:
 Description of mark.....should be explicit, e.g., S/Steel Pillar Plate, Steel plug, Brass plug, Bolt, G.I. Pipe
 Height of mark.....m. ^{above}/_{below} rock/concrete; Mark is.....m. ^{above}/_{below} G.L.
 Height of Top Vanes to Top Mark/Pillar platem. Diameter of Vanes (vertical).....m.
 Height of Cairn.....m. Diameter of Cairn.....m. Name Plate found/not found/placed.
 Length of Mast.....m. (approximate if not unplied)
4. A.....set in conc/rock has been placed/found, bearing.....°M from Mast/Plug/Pillar
5. A.....set in conc/rock has been placed/found, bearing.....°M from Mast/Plug/Pillar
6. A.....set in conc/rock has been placed/found, bearing.....°M from Mast/Plug/Pillar
7. A.....set in conc/rock has been placed/found, bearing.....°M from Mast/Plug/Pillar
8. Action required:.....

STANDPOINT:

Mark	Direction	Horiz. Distance	Height Difference	Mark	Direction	Horiz. Distance	Height Difference
			above standpt				above standpt
			below standpt				below standpt
			above standpt				above standpt
			below standpt				below standpt
Prepared by:

Checked:


St 2798-1

Noted on U.T.M. Card

STATION: BURBORG (P) TS: No.: 6050
 MAP SHEET SCALE 1:250 000 CAMBERRA
 INSPECTED BY: CWA DATE: March 1978
 AUTHORITY: FIELD BOOK:

Station Diagram
 North
 Not to Scale

GS 24

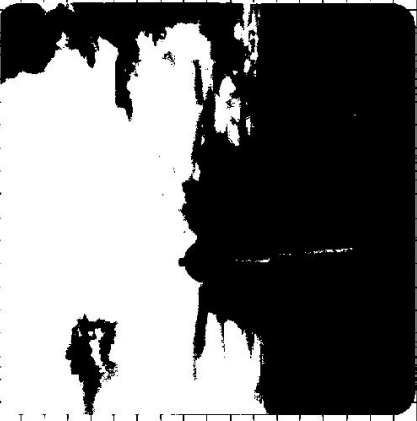STATION BURRBOING (F) 6050	Owner's Name: Address: Phone: Access Report of <i>March</i> <i>19/21</i> was found suitable/unsuitable. ACCESS	Current Occupant: Address: Phone: <u>Aust. Survey Office Mark</u>	
Beacon Diagram Not to Scale			
This section to be completed by officer constructing pillar. Original station mark found/not found.			
Description of mark: Original beacon found/not found.			
Description of beacon: Height Top of Vanes to Top Mark.....m. Height of mark.....m. above G.L. above rock/cone.....m. below G.L. Diameter of Vanes.....m. Height of Cairn.....m. Original Beacon has/has not been destroyed by me.			
			Date Record of Station

GEODETTIC SURVEY OF N.S.W.

CENTRAL MAPPING AUTHORITY

GEODETTIC STATION RECONNAISSANCE and MAINTENANCE REPORT

Description:

1. Cleared by lanes bearing.....
 Note: Cross out word or words which do not apply
 from Trig, Mast

2. Mast & Vanes have been painted white & black respectively.

3. The station/pillar was unplied/not unplied/constructed on..... 19....., dimensions now being:

Description of mark.....should be explicit, e.g., S/Steel Pillar Plate, Steel plug, Brass plug, Bolt, G.I. Pipe

Height of mark.....m. ^{above} rock/concrete; Mark ism. ^{above} G.L.

Height of Top Vanes to Top Mark/Pillar platem. Diameter of Vanes (vertical).....m.

Height of Cairn.....m. Diameter of Cairn.....m. Name Plate found/not found/placed.

Length of Mastm. (approximate if not unplied)

4. A.....set in conc/rock has been placed/found, bearing.....° M from Mast/Plug/Pillar


5. A.....set in conc/rock has been placed/found, bearing.....° M from Mast/Plug/Pillar

6. A.....set in conc/rock has been placed/found, bearing.....° M from Mast/Plug/Pillar

7. A.....set in conc/rock has been placed/found, bearing.....° M from Mast/Plug/Pillar

8. Action required:.....

Mark	Direction	Horiz. Distance	Height Difference	Mark	Direction	Horiz. Distance	Height Difference
BALCOMBE GS. OF 0 00 00			above standpt				above standpt
YARROW PIC GS 50 14 03			above standpt				above standpt
AVST SURVEY MARK 242 57 20 9 17 3		0.701	below				below
CONC. PILLAR 339 21 20 3 968		1.321	above standpt				above standpt
			above standpt				above standpt
			below				below
			above standpt				above standpt
			below				below
			above standpt				above standpt
			below				below

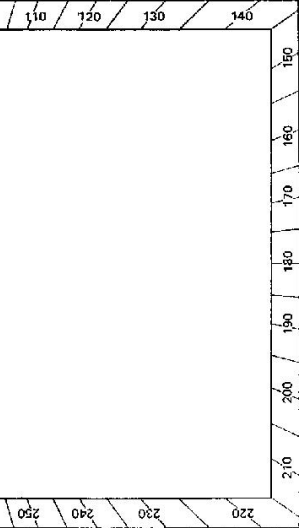


STANDPOINT: BRASS TRIG PLUG IN CONC FL. STANDPOINT:

STATION: BURRONG 6050 No.:
 MAP SHEET SCALE 1:280 000 CAMBERRA
 INSPECTED BY: IAN EVISON DATE: 17-3-78
 AUTHORITY: C.M.A. FIELD BOOK: 11656

Prepared by: Ian Evison
 Checked:

GS 24

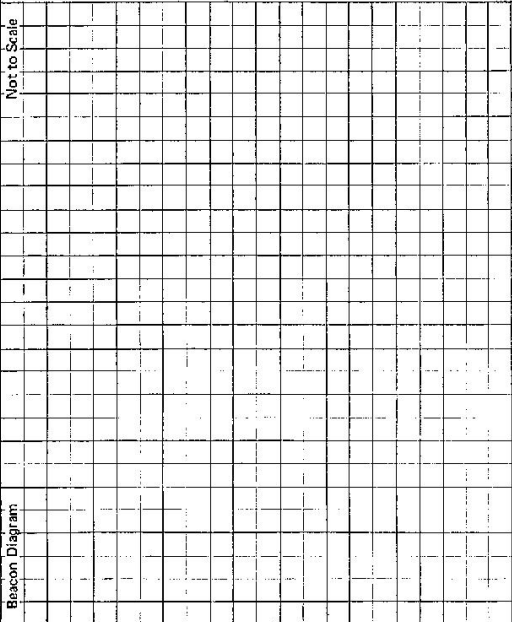STATION BURBONG 6050	Owner's Name: Address: Phone: Access Report of/19 was found suitable/unsuitable.	Current Occupant: Address: Phone: ACCESS
Beacon Diagram	Not to Scale 	
This section to be completed by officer constructing pillar. Original station mark found/not found.		
Description of mark: Original beacon found/not found.		
Description of beacon: Height Top of Vanes to Top Markm. Height of markm above rock/concm above G.L.m belowm Diameter of Vanesm. Height of Cairnm. Original Beacon has/has not been destroyed by me.		
Date	Record of Station	

GEODETTIC SURVEY OF N.S.W.


CENTRAL MAPPING AUTHORITY

GEODETTIC STATION RECONNAISSANCE and MAINTENANCE REPORT

Description:

1. Cleared by lances bearing 285 to 220 ^m 234 to 258 ^m from Trig. Mast
Note: Cross out word or words which do not apply
2. Mast & Vanes have been painted white & black respectively. ✓
3. The station/pillar was ~~unplaced/not unplaced~~/constructed on 17.3 ^m 19.78 ^m, dimensions now being:
Description of mark 3.5 Conc. Pillar. Flashed should be explicit, e.g., S/Steel Pillar Plate, Steel plug, Brass plug, Bolt, G.I. Pipe
Height of mark 3.80 ^m above ~~rock~~ ^{above} ~~concrete~~ ^{below} 3.80 ^m Mark is 1.4.3 ^m 1.4.5 ^m Diameter of Vanes (vertical) 0.75 ^m
Height of Top Vanes to Top Mark/Pillar plate 1.4.6.5 ^m Diameter of Vanes (vertical) 0.75 ^m
Height of Cairn ^m Diameter of Cairn ^m Name Plate ~~found/not found/placed~~
Length of Mast ^m (approximate if not unplaced)
4. BRASS TRIG. PLUG set in conc/rock has been ~~placed~~/found, bearing 264 [°] M from ~~Mast/Plug/Pillar~~
5. AUST. SURVEY MARK set in conc/rock has been ~~placed~~/found, bearing 326 [°] M from ~~Mast/Plug/Pillar~~
6. A set in conc/rock has been placed/found, bearing [°] M from Mast/Plug/Pillar
7. A set in conc/rock has been placed/found, bearing [°] M from Mast/Plug/Pillar
8. Action required: Name plate to be supplied

Mark	Direction	Horiz. Distance	Height Difference	Mark	Direction	Horiz. Distance	Height Difference
BALCOMBE GS OP	0 00 00			BALCOMBE GS OP	0 00 00		
YARROW PIC GS	50 15 02			CONC. PILLAR	40 35 58	10 393	2.022
TRIG PLUG	159 21 40	3.969	1.323	YARROW PIC GS	50 11 22		
AUST SURVEY MARK	220 38 20	10.391	2.022	TRIG PLUG	62 53 40	9.172	0.699

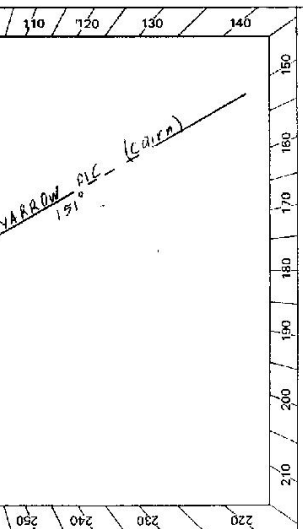

STATION: BURROONG GS 6050 No.:

MAP SHEET SCALE 1:250 000 CAMBERRA

INSPECTED BY: IAN EYSON DATE: 17-3-78

AUTHORITY: CMA FIELD BOOK: 01656

Station Diagram
MAG. North
Not to Scale

Checked

STANDPOINT: CONC. OBS PILLAR

Prepared by: Ian Eyson Checked: Ian Eyson

Noted on U.T.M. Card



GS 24

STATION **BURABONG G.S. 6050**

Owner's Name: **Mr. RUREN COLYERWELL**
 Address: **"BURABONG"**
KING'S HIGHWAY
 Phone: **97110 QUEANBEYAN**

ACCESS
 Access Report of **11.3.1978** was found suitable/unsuitable.

- K.M.**
- 0.0 From **BURBENDORE** take the **QUEANBEYAN Rd.** South to the **MOLONGLO RIVER** (Act & NSW Border & Railway Line) /
 - 0.7 **"BURBONG" (lower)** Proceed towards **Queanbeyan**.
 - 1.4 ON LHS is locked gate. (AUSTRALIAN SURVEY OFFICE MASTER KEY)
 - 1.7 Pass small dam on left. Follow track.
 - 1.9 Turn right up gully following track.
 - 2.5 Through green gate turning left, then right again up hill.
 - 2.9 **BURABONG G.S.**

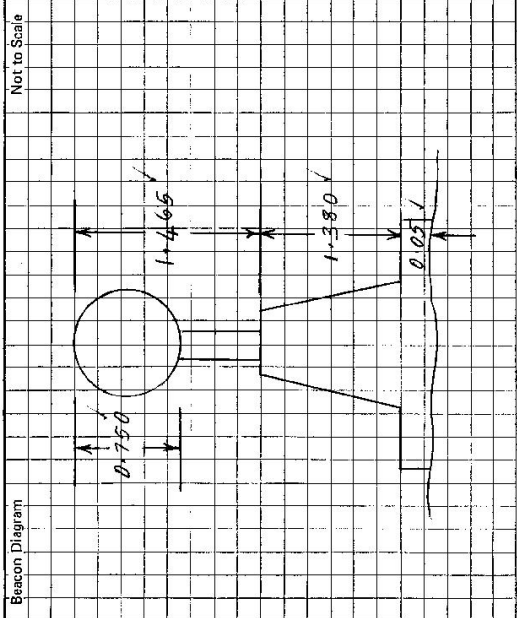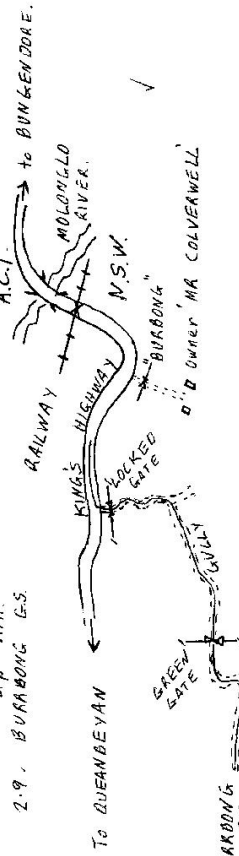

This section to be completed by officer constructing pillar.

Original station mark found ~~not found~~.

Description of mark: **BRASS TRIG. PLUG in CORR.**

Original beacon found ~~not found~~.

Description of beacon: **Coin Mast & Vanes**

Height Top of Vanes to Top Mark: **4.282** m.

Height of mark: **0.051** m. above ~~below~~ G.L.

Diameter of Vanes: **0.000** m. Height of Cairn: **1.1** m.

Original Beacon has ~~not~~ been destroyed by me.

Date	Record of Station
BURABONG G.S. 4	

St 2733 -2 D. West, Government Printer

No: 6050

STATION BORBONG (P)

<p>Beacon Diagram</p>	<p>Not to Scale</p>
-----------------------	---------------------

This section to be completed by officer constructing pillar.

Original station mark found/not found.

Description of mark:

Original beacon found/not found.

Description of beacon:

Height Top of Vanes to Top Mark.....m.

Height of mark.....m. above rock/conc.....m. below above G.L.

Diameter of Vanes.....m. Height of Cairn.....m.

Original Beacon has/has not been destroyed by me.

<p>Owner's Name: Mr Rueben COLVERBELL</p> <p>Address: 21 Survejer St QUERUBETAN</p> <p>Phone: 02 6297 1110</p> <p>6299 1663 at "Borbong" homestead ACCESS</p> <p>Access Report of 17/3/1978 was found same/unsuitable.</p>	<p>Current Occupant:</p> <p>Address:</p> <p>Phone:</p> <p>4WD LPI LOCK</p>
<p>0.0 L KINGS HWY & CAPTAIN'S FLAT ROAD Head towards BUNGENDOLE on KINGS HWY.</p> <p>4.0 Turn R through LOCKED GATE just before culvert. OWNERS HOUSE "Borbong" 0.35km further on HWY.</p> <p>4.4 Turn R up spur (post on L). Follow wheel tracks</p> <p>4.9 Turn L along fence</p> <p>5.0 Pass green gate on R</p> <p>5.2 At top of hill - let down fence on R and drive to Δ about another 200m. OWNERS PERMISSION to let down netting fence.</p>	<p>Date</p> <p>Record of Station</p> <p>OK for static GPS 245-274 m 25° Elev Tree</p> <p>INSPECTED BY: A. Sivertsen</p> <p>DATE: Apr. 03</p>