

GEODETTIC SURVEY OF M.S.#:

CENTRAL MAPPING AUTHORITY

GEODETTIC STATION RECONNAISSANCE and MAINTENANCE REPORT

Description:

1. Cleared by lense bearing 206° / 250° / 261° / 062° / 062° from Trig. Mast

2. Mast & Vanes have been painted white & black respectively. ✓

3. The ~~station~~ / pillar was ~~unplaced~~ / ~~not unplaced~~ / constructed on 21 - 10 - 1977, dimensions now being:

Description of mark: S/S Pillar Plate / Steel plate / Bress-plate / Bolt / G.I. Pipe

Height of mark: 1.370 m. above ~~rock~~ / ~~concrete~~; Mark is below G.L.

Height of Top Vanes to Top ~~Mark~~ / ~~Pillar plate~~ 1.110 m. Diameter of Vanes (vertical) 0.155 m.

Height of Cairn: 1.190 m. Diameter of Cairn 0.110 m. Name Plate ~~found~~ / ~~not found~~ / placed 3-11-77

Length of Mast 1.190 m. (approximate if not upright)

4. (Copper Nail / Placed / in Drill Hole / in) set in conc/rock has been placed / ~~found~~ / bearing 289 °M from ~~Mast/Plug~~ / ~~Pillar~~

5. A TRIG. PLUG set in conc/rock has been placed / ~~found~~ / bearing 16 °M from ~~Mast/Plug~~ / ~~Pillar~~

6. A set in conc/rock has been placed / ~~found~~ / bearing 0 °M from Mast / ~~Plug~~ / ~~Pillar~~

7. A set in conc/rock has been placed / ~~found~~ / bearing 0 °M from Mast / ~~Plug~~ / ~~Pillar~~

8. Action required:

STANDPOINT: CONCRETE PILLAR STANDPOINT: TRIG. PLUG in rock

Mark	Direction	Horiz. Distance	Height Difference	Mark	Direction	Horiz. Distance	Height Difference
TORAGY (Pillar)	359 59 60		above standpt.	TORAGY (Pillar)	359 59 60		above standpt.
POLLWOMBRA (Pillar)	44 52 40		above standpt.	POLLWOMBRA (Pillar)	44 52 20		above standpt.
WANDERA T.S. in Drill Hole	63 01 00		above standpt.	COPPER NAIL in drill hole	63 01 00	8.666	above standpt.
COPPER NAIL Hole	83 18 40	8.169	above standpt.	CONC. PILLAR	352 33 00	3.006	above standpt.
TRIG PLUG in rock	172 32 25	3.003	above standpt.				above standpt.
			below standpt.				below standpt.
			below standpt.				below standpt.
Prepared by: H.C. BORDER

Checked:

Noted on U.T.M. Card



STATION: **BURREWARRA (P)** No.: 6052

MAP SHEET: ULLADULLA

INSPECTED BY: H.C. BORDER DATE: 28-10-77

AUTHORITY: C.M.A FIELD BOOK: 01655

Scale: 1:250 000

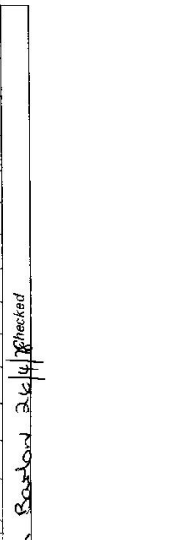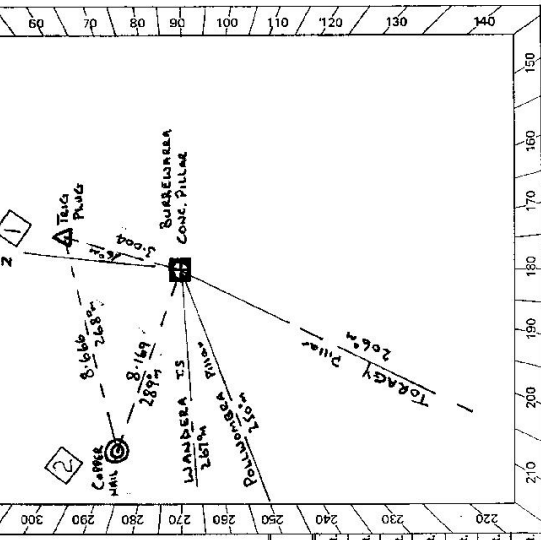


Station Diagram

North

North Head

Not to Scale

St 2739-2 D. West, Government Printer

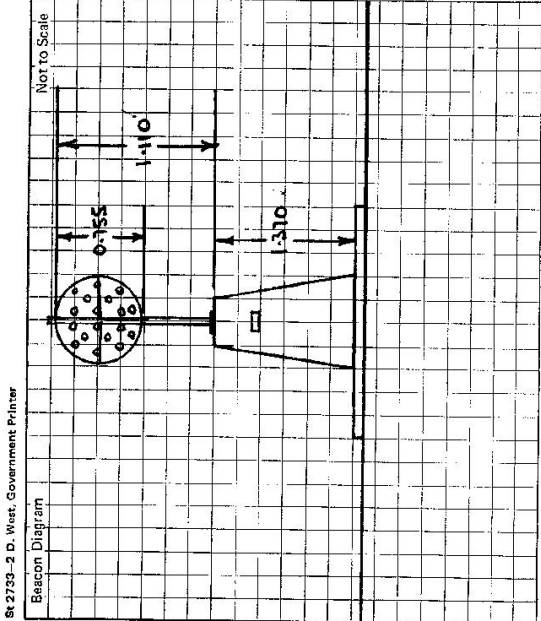

This section to be completed by officer constructing pillar.

Original station mark found/~~not found~~.

Description of mark: **BRONZE TRIG. PILE**

Original beacon ~~found~~/not found.

Description of beacon:

Height Top of Vanes to Top Mark:m.

Height of mark: **0.04** above **rock** ~~above~~ **0.35** m. ~~above~~ **G.L.** / below

Diameter of Vanes:m. Height of Cairn:m.

Original Beacon has/~~has not been~~ destroyed by:

STATION BURREWARRA (PILLAR) 6052

Owner's Name: **EURODALLA SHIRE** (SEEN)
 Address: **MORNTA**
 (RECREATION GROUND)
 Phone:

Current Occupant:

Address:

Phone:

ACCESS

Access Report of **28/10/18** was found suitable/unsuitable.

from **Monye** take **Prince's Hwy**, northward
turn off Prince's Hwy on R.H.S to Boulder
follow Boulder Rd, passing P.O
(this rd, now called GEORGE BASE DRIVE)
following this road northward, crossing CANDLAGAN CREEK at:
still " " " TOMAGO RIVER at:
passing TOMAGINA on L.H.S and SUNPATCH TURN OFF on R.H.S at:
turn off to BURREWARRA POINT + GUERILLA BAY on R.H.S (eastward) at:
road forks take R.H. Turn at:
follow road to parking area at:
follow main built track (sand track)
eastward from parking area to navigation light at:
+ BURREWARRA COAST PILLAR

m's
 0-00
 0-40
 13-10
 15-10
 17-20
 18-10
 21-00
 21-10
 22-40
 23-00

Date	Record of Station
12.10.1988	These messages from Monyeta to K. HARRIS New Cairn at Monyeta placed. Diana Vanas c. 15m. Leads west to BURREWARRA COAST PILLAR. R.M.C.O. 1. 1988/1.

See also Burrewarra (F) 6052

MAP SHEET BATHMANS BAY

CONTROL DIAGRAM

STATION BURREWARRA LIGHT

No. 89226

CENTRAL MAPPING AUTHORITY -

County SE - VINCENT Parish BATHMANS

Photo Identification /

Run NSW

Photo Identification Sketch

Not to Scale

GRID NORTH


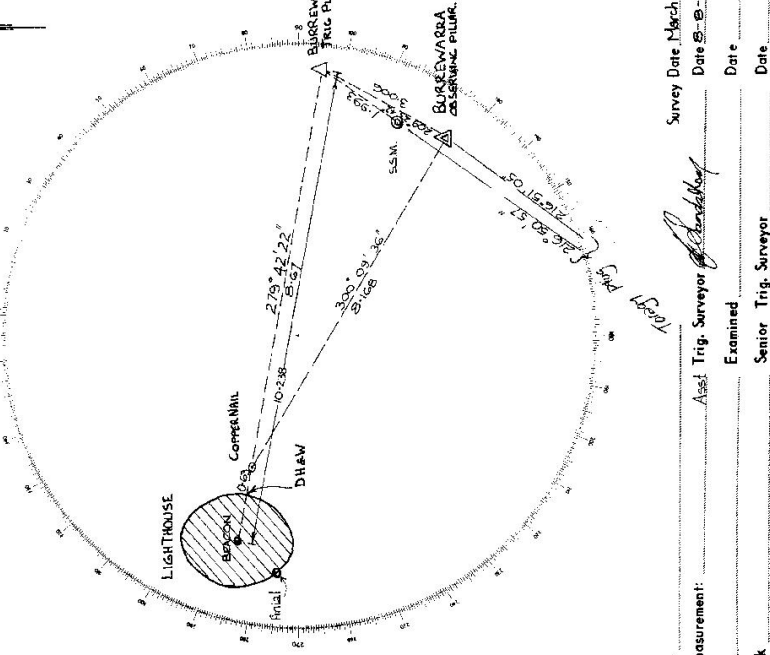


Photo Pt. Height Details.

Approx. Scale

STATION		CO-ORDINATES	
SOUTH LATITUDE	EAST LONGITUDE	ZONE	NORTHING
791970.874	6029452.444	55	6029452.444
791970.874	6030710.233	56	6030710.233
Datum	Elevation		
+	+		
Cadastral Corner	FINAL	55	6029451.678
Photo Point		56	6030739.520
Computer	Date	Senior Computer	Date
	7.8.78		
Examined	Date		Date
	8.8.78		

To Obtain
 Unit of Measurement: Asst. Trig. Surveyor
 Scale Examined
 Field Book Senior Trig. Surveyor
 Survey Date: March 1975
 Date: 8-8-78

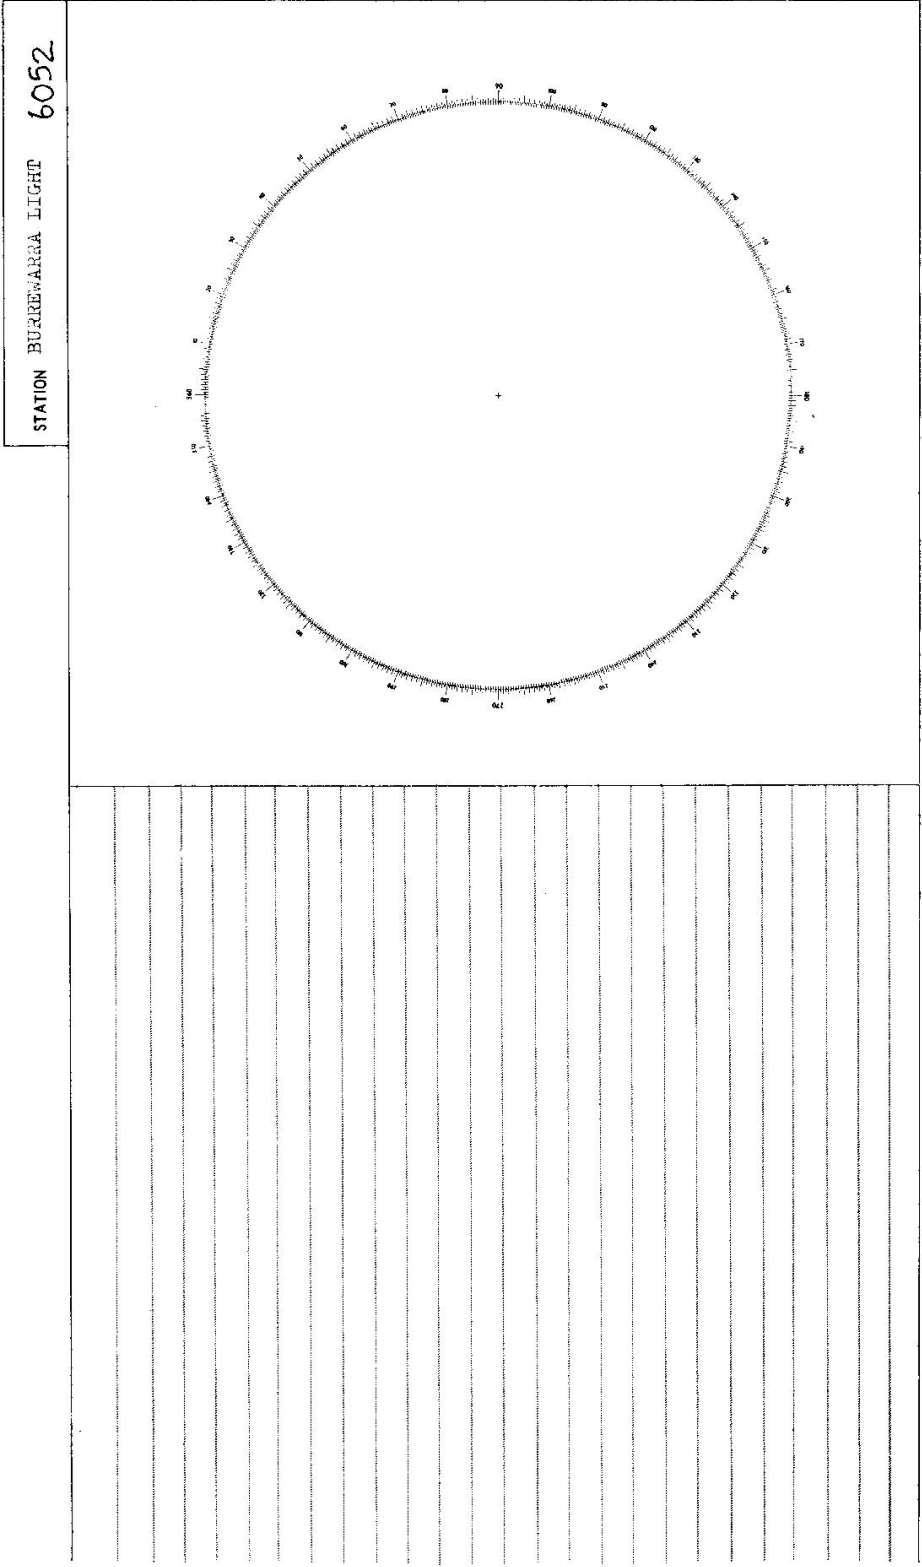

CENTRAL MAPPING AUTHORITY

GEODETTIC STATION RECONNAISSANCE and MAINTENANCE REPORT

STATION: **BURREWARRA (P)** No.: **6052**

MAP SHEETS SCALE 1:100,000
SCALE 1:250,000
Baharans Bay

INSPECTED BY: **D. Heits**
A. Sivertsen

DATE: **9.9.88**


AUTHORITY: **CMA**

FIELD BOOK: **C573/a0**
C574/24

Description:
 1. Cleared by lanes bearing.....
 Note: *Cross out word or words which do not apply*
 from Trig. Mast
 2. Mast & Vanes have been painted white & black respectively.
 3. The station/pillar was unpiled/not unpiled/constructed on.....
 19....., dimensions now being:
 Description of mark.....should be explicit, e.g., S/Steel Pillar Plate, Steel plug, Brass plug, Bolt, G.I. Pipe
 Height of mark.....m. above rock/concrete; Mark is.....m. above G.L.
 Height of Top Vanes to Top Mark/Pillar plate.....m. Diameter of Vanes (vertical).....m.
 Height of Cairn.....m. Diameter of Cairn.....m. Name Plate found/not found/placed.
 Length of Mast.....m. (approximate if not unpiled)

STANDPOINT: TRIG PLOG		STANDPOINT:					
Mark	Direction	Horiz. Distance	Height Difference	Mark	Direction	Horiz. Distance	Height Difference
TORREY (P)	0 00 60		above standpt.				above standpt.
POLLWOMBRA (P)	44 51 59		above standpt.				above standpt.
Lighting Rod on L.H.	58 01 24 (case)		above standpt.				above standpt.
Centre of Lighthouse	62 49 48 (case)		above standpt.				above standpt.
			below standpt.				below standpt.
			below standpt.				below standpt.
8. Action required:.....
 Prepared by: **A. Sivertsen 20.9.88** Checked: **Noted on U.T.M. Cont.**

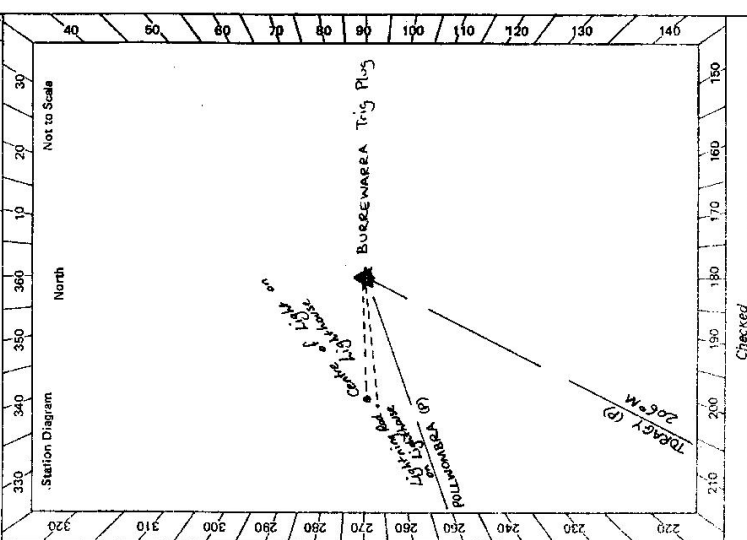

GS 24

20. 2753-2 D. West, Government Printer Beacon Diagram:	STATION BURREWARRA (P) 6052	Owner's Name Eurobodalle Shire Address Phone: Current Occupant Address Phone:	Access Report of 9.1.1988 was found suitable/unsuitable. Travel South from Batemans Bay for about 17km on coast road (ocean rd & George Bass Drive) then at 0.6km turn Left at sign BURRI POINT ROAD (cf) Travel North from MORUYA via Airport/Broulee/Tomskin for about 21km via George Bass Drive then turn Right at sign BURRI POINT ROAD 0.6km Follow BURRI POINT RD (Sign Guerilla Bay) 0.7 Take R fork 1.4 At parking area go through locked ALMCO gate on right. Chain can be lifted over gate - post. Follow sandy track. 1.9 Turn L towards Lighthouse & (P) 2.0 BURREWARRA (P)
Not to Scale 		Date Record of Station	
This section to be completed by officer constructing pillar. Original station mark found/not found. Description of mark: Original beacon found/not found. Description of beacon: Height Top of Vanes to Top Mark m. Height of mark m. above G.L. below Diameter of Vanes m. Height of Cairn m. Original Beacon has/has not been destroyed by me.			