



Sr 2733-2 D. West, Government Printer

STATION <b>WANDERA (PILLAR) TS 6053</b>	
<p>Owner's Name: <b>CROWN LANDS T.R.16194</b></p> <p>Address: <b>FORESTRY COMMISSION</b></p> <p>Phone: <b>BATEMAN'S BAY</b></p> <p style="text-align: center;">ACCESS</p> <p>Access Report of <b>4.11.1977</b> was found suitable/unsuitable.</p> <p>take <b>Archer - Bradwood Rd.</b> westward from <b>Monyo P.O</b> crossing river at :-                  end of sealed road at :-                  crossing <b>Barnette Creek</b> at :- crossing <b>Daly's</b>                  intersection of <b>honyo Mountain Rd.</b> called at :-                  (Monyo via <b>honyo Mountain</b>)</p> <p><b>KNOWLES CREEK</b>                  house on R.H.S - <b>JOHN ENGLEBOW</b>                  house on L.H.S                  take track (fire trail) <b>KNOWLES Rd</b> (steep) on R.H.S                  to <b>WANDERA TRIG</b></p> <p>intersection of fire trails, turn right at :-                  a side track on R.H.S at :-  <b>WANDERA PILLAR</b> at :-</p>	<p style="text-align: right;">Kms</p> <p>0.00 3.70 6.60 14.80 17.30 18.10</p> <p>22.30 26.40 27.20 28.00</p>
<p>Beacon Diagram</p> <p style="text-align: right;">Not to Scale</p>	<p>This section to be completed by officer constructing pillar.</p> <p>Original station mark found/<del>not found</del>.</p> <p>Description of mark: <b>BROWNIE TRIG P.W.O</b></p> <p>Original beacon found/<del>not found</del>.</p> <p>Description of beacon: <b>Cairn, Mast &amp; Vanes</b></p> <p>Height Top of Vanes to Top Mark.....<b>3.445</b>.....m.</p> <p>Height of mark.....<b>0.055</b>.....m. above <del>rock/stone</del> <sup>above</sup> G.L.</p> <p>Diameter of Vanes.....<b>1.010</b>.....m. Height of Cairn.....<b>1.400</b>.....m.</p> <p>Original Beacon has/<del>has not</del> been destroyed by me.</p>
	<p>Date</p> <p>Record of Station</p>

GEODETTIC SURVEY OF M.S.W.

CENTRAL MAPPING AUTHORITY

GEODETTIC STATION RECONNAISSANCE and MAINTENANCE REPORT


STATION: **WANDERA G.S. (P)** No.: **6053**

MAP SHEET SCALE 1:250 000 **VILLADULLA**

INSPECTED BY: **R. LANDER** DATE: **15-10-80**

AUTHORITY: **C.M.A.** FIELD BOOK: **AR1895**

- Description: *Note: Cross out word or words which do not apply*
- Cleared by lanes bearing..... from Trig. Mast
  - Mast & Vanes have been painted white & black respectively.
  - The station/pillar was unpiled/not unpiled/constructed on.....19..... dimensions now being: Description of mark.....should be explicit, e.g., S/Steel Pillar Plate, Steel plug, Brass plug, Bolt, G.I. Pipe Height of mark.....m. <sup>above</sup> rock/concrete; Mark is.....m. <sup>above</sup> G.L. Height of Top Vanes to Top Mark/Pillar plate .....m. Diameter of Vanes (vertical).....m. Height of Cairn.....m. Diameter of Cairn.....m. Name Plate found/not found/placed. Length of Mast.....m. (approximate if not unpiled)
  - A. ~~SSM~~ <sup>2</sup>.....set in conc/rock has been placed/found, bearing.....° M from Mast/Plug/Pillar
  - A. ~~SSM~~ <sup>0</sup>.....set in conc/rock has been placed/found, bearing.....° M from Mast/Plug/Pillar
  - A.....set in conc/rock has been placed/found, bearing.....° M from Mast/Plug/Pillar
  - A.....set in conc/rock has been placed/found, bearing.....° M from Mast/Plug/Pillar
  - Action required:.....

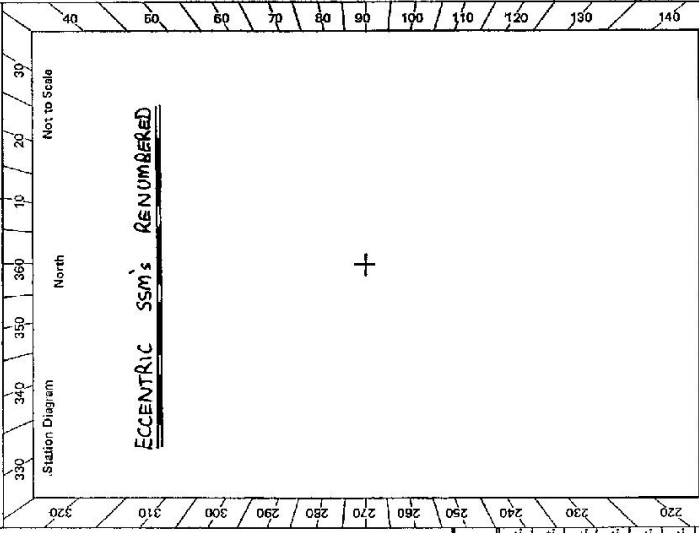

STANDPOINT:			
Mark	Direction	Horiz. Distance	Height Difference
			above standpt.
			below standpt.
			above standpt.
			below standpt.
Prepared by: **R. LANDER 30-10-80** Checked: **R. Williams 29/1/80** Noted on U.T.M. Card

PREVIOUSLY UNNUMBERED

GEODETIC SURVEY OF N.S.W.

CENTRAL MAPPING AUTHORITY

GEODETIC STATION RECONNAISSANCE and MAINTENANCE REPORT

Description:

1. Cleared by lanes bearing  $35^{\circ}24'26''$  to  $N89^{\circ}$ ,  $199^{\circ}$  to  $240^{\circ}$ ,  $288^{\circ}$  to  $333^{\circ}$ ,  $345^{\circ}$  to  $353^{\circ}$  from Trig. Mast  
 130m to 15m INSPECTED

2. Mast & Vanes have been painted white & black respectively. *yes*

3. The station/pillar was ~~replaced~~ *replaced* on *17/04/19* *same*  $19.88$  dimensions now being:  
 Description of mark: *S/Steel Plate* should be explicit, e.g., S/Steel Pillar Plate, Steel plug, Brass plug, Bolt, G.I. Pipe

Height of mark:  $1.37$  m. above ~~mark~~ *concrete*; Mark is  $1.520$  m. above G.L.

Height of Top Vanes to Top ~~mark~~ *Pillar plate*  $1.435$  m. Diameter of Vanes (vertical)  $0.750$  m.

Height of Cairn:  $0$  m. Diameter of Cairn:  $0$  m. Name Plate ~~found~~ *not* found/placed.

Length of Mast:  $0$  m. (approximate if not unplied)

4. A.  $0$  set in conc/rock has been placed/found, bearing  $0^{\circ}$  M from Mast/Plug/Pillar

5. A.  $0$  set in conc/rock has been placed/found, bearing  $0^{\circ}$  M from Mast/Plug/Pillar

6. A.  $0$  set in conc/rock has been placed/found, bearing  $0^{\circ}$  M from Mast/Plug/Pillar

7. A.  $0$  set in conc/rock has been placed/found, bearing  $0^{\circ}$  M from Mast/Plug/Pillar

8. Action required: *PLEASE NOTE: ORIGINAL TRIP LOG HAS BEEN DESTROYED BY ACCIDENT. MARK CHANGED OUT BY COUNTY COUNCIL*

STANDPOINT:

Mark	Direction	Horiz. Distance	Height Difference	Mark	Direction	Horiz. Distance	Height Difference
			above standpt				above standpt
			below standpt				below standpt
			above standpt				above standpt
			below standpt				below standpt
Prepared by: *P. Jones 28/6/18*

Checked: *9/11/2018*

Named on U.T.M. Card *14*

Checked *140* *13/01/18*

STATION: *WANDERA (C)* No.: *6053*  
 MAP SHEETS SCALE 1:250 000 SCALE 1:100 000  
 INSPECTED BY: *P. Jones* DATE: *17/6/18*  
 AUTHORITY: *C.M.A.* FIELD BOOK: *1964*

Station Diagram

Not to Scale


STATION **WANDERA (P)** TS **6053**

Owner's Name: **CROWN LAND TR 16194**  
 Address: **FORESTRY COMMISSION**  
**BOYEMAN'S BAY MR MERV HARRIS**  
 District: **ROSEBERRY**  
 Phone: **044-766211**

Current Occupant:  
 Address:  
 Phone:

- Access Report of 17.6.88 was found suitable/unsuitable.
- ACCESS:
- AM 0.00 1ST OFFICE ABOUYA TRAVEL WEST MONA CAMPBELL STREET TOWARDS MANDEN, BRAIDWOOD
  - 379 CROSS CONCRETE BRIDGE OVER RIVER
  - 6.59 END OF SEALED ROAD 7/16/88
  - 9.36 PAS T RIDGE ROEST ROAD ON RIGHT
  - 18.21 PAS GRAVEL ROAD ON RIGHT; SIGN ABOUYA Via LARRY'S Mt FOLLOW ROAD TOWARDS BRAIDWOOD
  - 22.46 CROSS KNOWLES CREEK
  - 22.53 TURN RIGHT ONTO STEEP GRAVEL ROAD SIGN KNOWLES ROAD
  - 26.58 TURN RIGHT AT T INTERSECTION SIGN WANDERA TRIG.
  - 27.31 PAS X RIDGE ROAD ON RIGHT
  - 28.09 WANDERA (P)

NOTE: ABOUYA RD. IS ALONG CAMPBELL STREET FROM ROUND-A-BOUT; TURNING RIGHT OF RANGES HIGHWAY

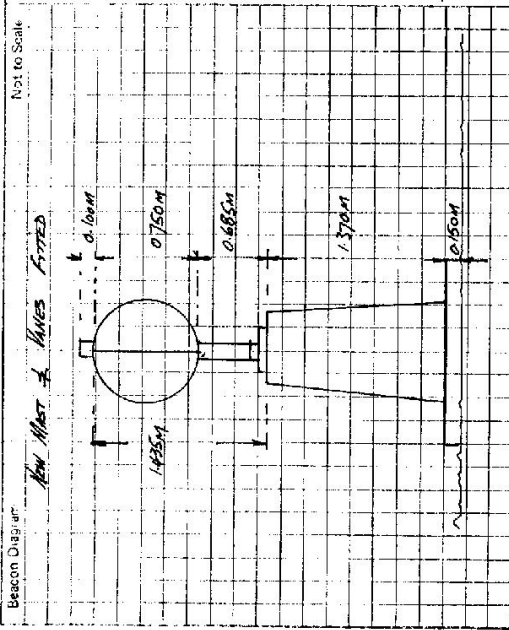

This section to be completed by officer constructing pillar.

Original station mark found/not found.

Description of mark: .....

Original beacon found/not found.

Description of beacon: .....

Height Top of Vanes to Top Mark .....m.

Height of mark .....m. above G.L. below

Diameter of Vanes .....m. Height of Cairn .....m.

Original Beacon has/not been destroyed by me.

Date	Record of Station