

GEODETIC SURVEY OF N.S.W.

CENTRAL MAPPING AUTHORITY


GEODETIC STATION RECONNAISSANCE and MAINTENANCE REPORT

STATION: **MOGO (PILLAR)** No.: **6054**

MAP SHEET SCALE 1:250 000 **ULLADULLA.**

INSPECTED BY: **H.C. BORDER** DATE: **27-1-18**

AUTHORITY: **C.M.A** FIELD BOOK:

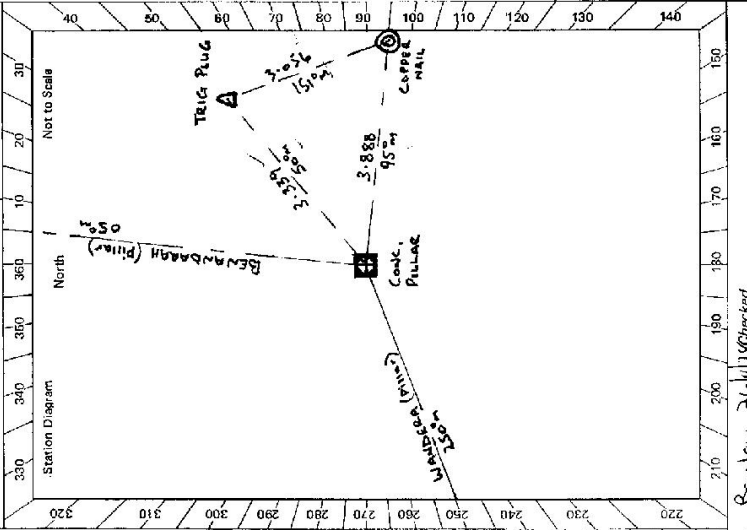

- Description:
- Cleared by lanes bearing **250m / 05° / 24m**. Note: Cross out word or words which do not apply. **176m to 201m** from Trig. Mast
 - Mast & Vanes have been painted white & black respectively. ✓
 - The station/pillar was ~~unplaced/not placed~~/constructed on **1.6m** ~~1.1m~~ **1.91m** dimensions now being: Description of mark: **1/4s Pillar Plate** should be explicit, e.g. **S/Steel Pillar Plate**, Steel plug, Brass plug, Bolt, G.I. Pipe
- Height of mark: **1.36m** above ~~level~~ **feet/concrete**; Mark is **1.440m** above G.L.
- Height of Top Vanes to Top ~~Mark~~/Pillar plate **1.440m**; Diameter of Vanes (vertical) **0.755m**.
- Height of ~~Cairn~~ **1.520m**; Diameter of ~~Cairn~~ **1.520m**; Name Plate ~~found/not found~~/placed.
- Length of Mast **1.520m** (approximate if not unplied)
- A. TRIG. PLUG** set in ~~conc/rock~~ has been ~~placed~~/found, bearing **50°** M from ~~Mast/Plug~~/Pillar
 - A. COPPER NAIL** set in ~~conc/rock~~ has been ~~placed~~/found, bearing **95°** M from ~~Mast/Plug~~/Pillar
 - A.** set in ~~conc/rock~~ has been ~~placed~~/found, bearing **95°** M from ~~Mast/Plug~~/Pillar
 - A.** set in ~~conc/rock~~ has been ~~placed~~/found, bearing **95°** M from ~~Mast/Plug~~/Pillar
- Action required: **Name. Plate to be supplied.**

STANDPOINT: COOK PILLAR		STANDPOINT: TRIG PLUG				
Mark	Direction	Horiz. Distance	Height Difference	Direction	Horiz. Distance	Height Difference
WANDERAH (Pillar)	359 59 60		above standpt. 359 59 60	WANDERAH (Pillar)	359 59 60	below standpt.
BENAMBARRAH (Pillar)	117 35 20		above standpt. 117 35 20	BENAMBARRAH (Pillar)	117 35 20	below standpt.
TRIG PLUG	158 45 40	3.338	below standpt. 1.548	COPPER NAIL	264 02 40	above standpt. 0.192
COPPER NAIL	208 03 20	3.888	below standpt. 1.358	COOK. PILLAR	338 04 20	above standpt. 1.550
			below standpt.			below standpt.
			below standpt.			below standpt.
			below standpt.			below standpt.

Prepared by: **H.C. BORDER** Checked: **B. How** 13/1/18

STATION	MDGD	(PILLAR)	TS 6054	
<p>Owner's Name: <u>CROWN LANDS</u> Address: <u>FORESTEY COMMISSION</u> <u>BATEMANS BAY</u> Phone:</p>				<p>Current Occupant:</p>
<p>ACCESS</p> <p>Access Report of 27.1.1978 was found suitable/unsuitable. from Batemans Bay P.O. take Princess Hwy South towards Monya. Crossing Deep Creek at:- turn off Hwy on L.H.S. onto old gravel road. at:- road forks take L.H.S track at:- a track goes to the left, (keep to main track) at:- T. intersection, (or fire tracks intersection) at:- turn sharp right and follow track up hill, take track to left. at:- follow this track to trig. Pillar. at:-</p>				<p>Kms 0.00 5.30 6.50 7.10 7.80 8.60 9.00 9.10</p>
<p>Beacon Diagram</p>				<p>Date</p> <p>Record of Station</p>
<p>This section to be completed by officer constructing pillar.</p> <p>Original station mark found/not found.</p> <p>Description of mark: <u>STONE PILLAR</u></p> <p>Original beacon found/not found.</p> <p>Description of beacon: <u>Cairn, Mast & Vanes. (Old mast rotted away)</u></p> <p>Height Top of Vanes to Top Mark.....m.</p> <p>Height of mark.....m. ^{above} below G.L.</p> <p>Diameter of Vanes <u>0.610</u>.....m. ^{below} above rock/cons.</p> <p>Height of Cairn <u>1.350</u>.....m.</p> <p>Original Beacon has/has not been destroyed by fire.</p>				

GEODETIC SURVEY OF NSW

CENTRAL MAPPING AUTHORITY

GEODETIC STATION RECONNAISSANCE and MAINTENANCE REPORT

Description:

1. Cleared by vanes bearing 162° to 183° m, 285° to 307° m to 324° to 341° to 350° m Trig. Mast
Note: Cross out word or words which do not apply
 2. Mast & Vanes have been painted white & black respectively. **YES**
 3. The station/pillar was ~~concrete~~ **concrete** mounted on 20° m **stone**, dimensions now being: 19.88° m, above G.L.
S/ Above Base
- Description of mark **S/ Above Base** should be explicit, e.g., S/Steel Pillar Plate, Steel plug, Brass plug, Bolt, G.I. Pipe
- Height of mark 1360 m, above ~~base~~ **concrete**; Mark is 1360 m, above G.L.
- Height of Top Vanes to Top ~~mark~~ **Pillar plate** 1440 m. Diameter of Vanes (vertical) 0.745 m.
- Height of Cairn 0 m. Diameter of Cairn 0 m. Name Plate found/not found/placed.
- Length of Mast 0 m. (approximate if not unplied)
4. A 0 m set in conc/rock has been placed/found, bearing 0° M from Mast/Plug/Pillar
 5. A 0 m set in conc/rock has been placed/found, bearing 0° M from Mast/Plug/Pillar
 6. A 0 m set in conc/rock has been placed/found, bearing 0° M from Mast/Plug/Pillar
 7. A 0 m set in conc/rock has been placed/found, bearing 0° M from Mast/Plug/Pillar
8. Action required: 0

STANDPOINT:

Mark	Direction	Horiz. Distance	Height Difference	Mark	Direction	Horiz. Distance	Height Difference
			above	standpt			below
			below	standpt			above
			above	standpt			below
			below	standpt			above
Prepared by: **P.Berts 28/6/88**

Checked: **J. Hall 29/6/88**

Noted on U.T.M. Card

STATION: **M660 (P)** No.: **6054**
 MAP SHEETS SCALE 1:250 000 **ULLADULLA** SCALE 1:100 000
 INSPECTED BY: **P.BERTS** DATE: **20/6/88**
 AUTHORITY: **C.M.A.** FIELD BOOK: **1964**

Station Diagram
 Not to Scale
 SATELITE MARKS NOT SEARCHED FOR ON THIS VISIT


Checked **A** 14/10/88

STATION **Mogo (P) TS 6054**

Owner's Name: **FORESTRY COMMISSION**
 Address: **BATEMAN'S BAY**
 Mr. MARK ANNE'S DISTRICT RESERVE
 Phone: **044 726 211**
 Current Occupant:
 Address:
 Phone:

ACCESS:

Access Report of 20.6/1988 was found suitable/unavailable.
RM FEATURE
 0.00 **RAT OFFICE BATEMAN'S BAY TRAVEL SOUTH ALONG ORIENT STREET**
 0.18 **TURN RIGHT AT STOP SIGN ALONG BAYERN ROAD TOWARDS PRINCESS HIGHWAY**
 0.45 **TURN LEFT ONTO PRINCESS HIGHWAY TOWARDS MARYVA-BEER.**
 6.92 **TURN LEFT OFF PRINCESS HIGHWAY ONTO SEAVEL ROAD SIGN**
 (SHOULDER PROHIBITED, DANGER AUTHORIZED VEHICLES ONLY NO ACCESS/DAM)
 7.45 **TAKE LEFT FORK IN TRACK.**
 8.19 **TAKE RIGHT FORK**
 8.26 **ABS TRACK ON RIGHT**
 9.03 **TURN RIGHT AT T INTERSECTION**
 9.07 **TURN RIGHT SIGN MOGO TRIG ROAD.**
 9.43 **TURN LEFT ONTO TRACK.**
 9.51 **MOGO (P)**

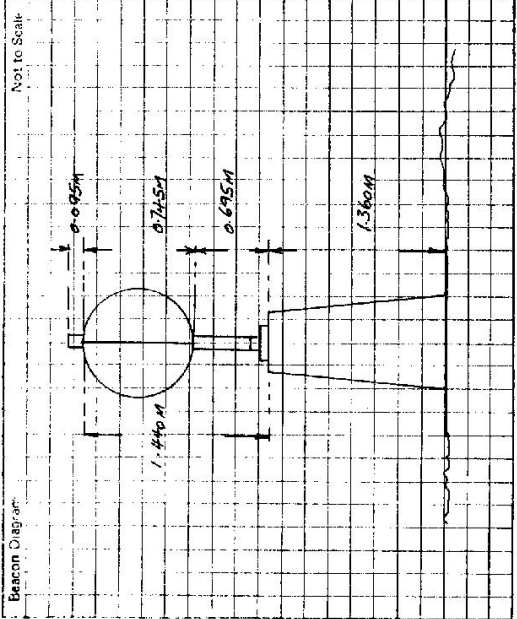

This section to be completed by officer constructing pillar.

Original station mark found/not found.

Description of mark:

Original beacon found/not found.

Description of beacon:

Height Top of Vanes to Top Markm.

Height of mark.....m. above G.L. below

Diameter of Vanesm.

Original Beacon has/has not been destroyed by me.

Height of Cairnm.

Date	Record of Station